
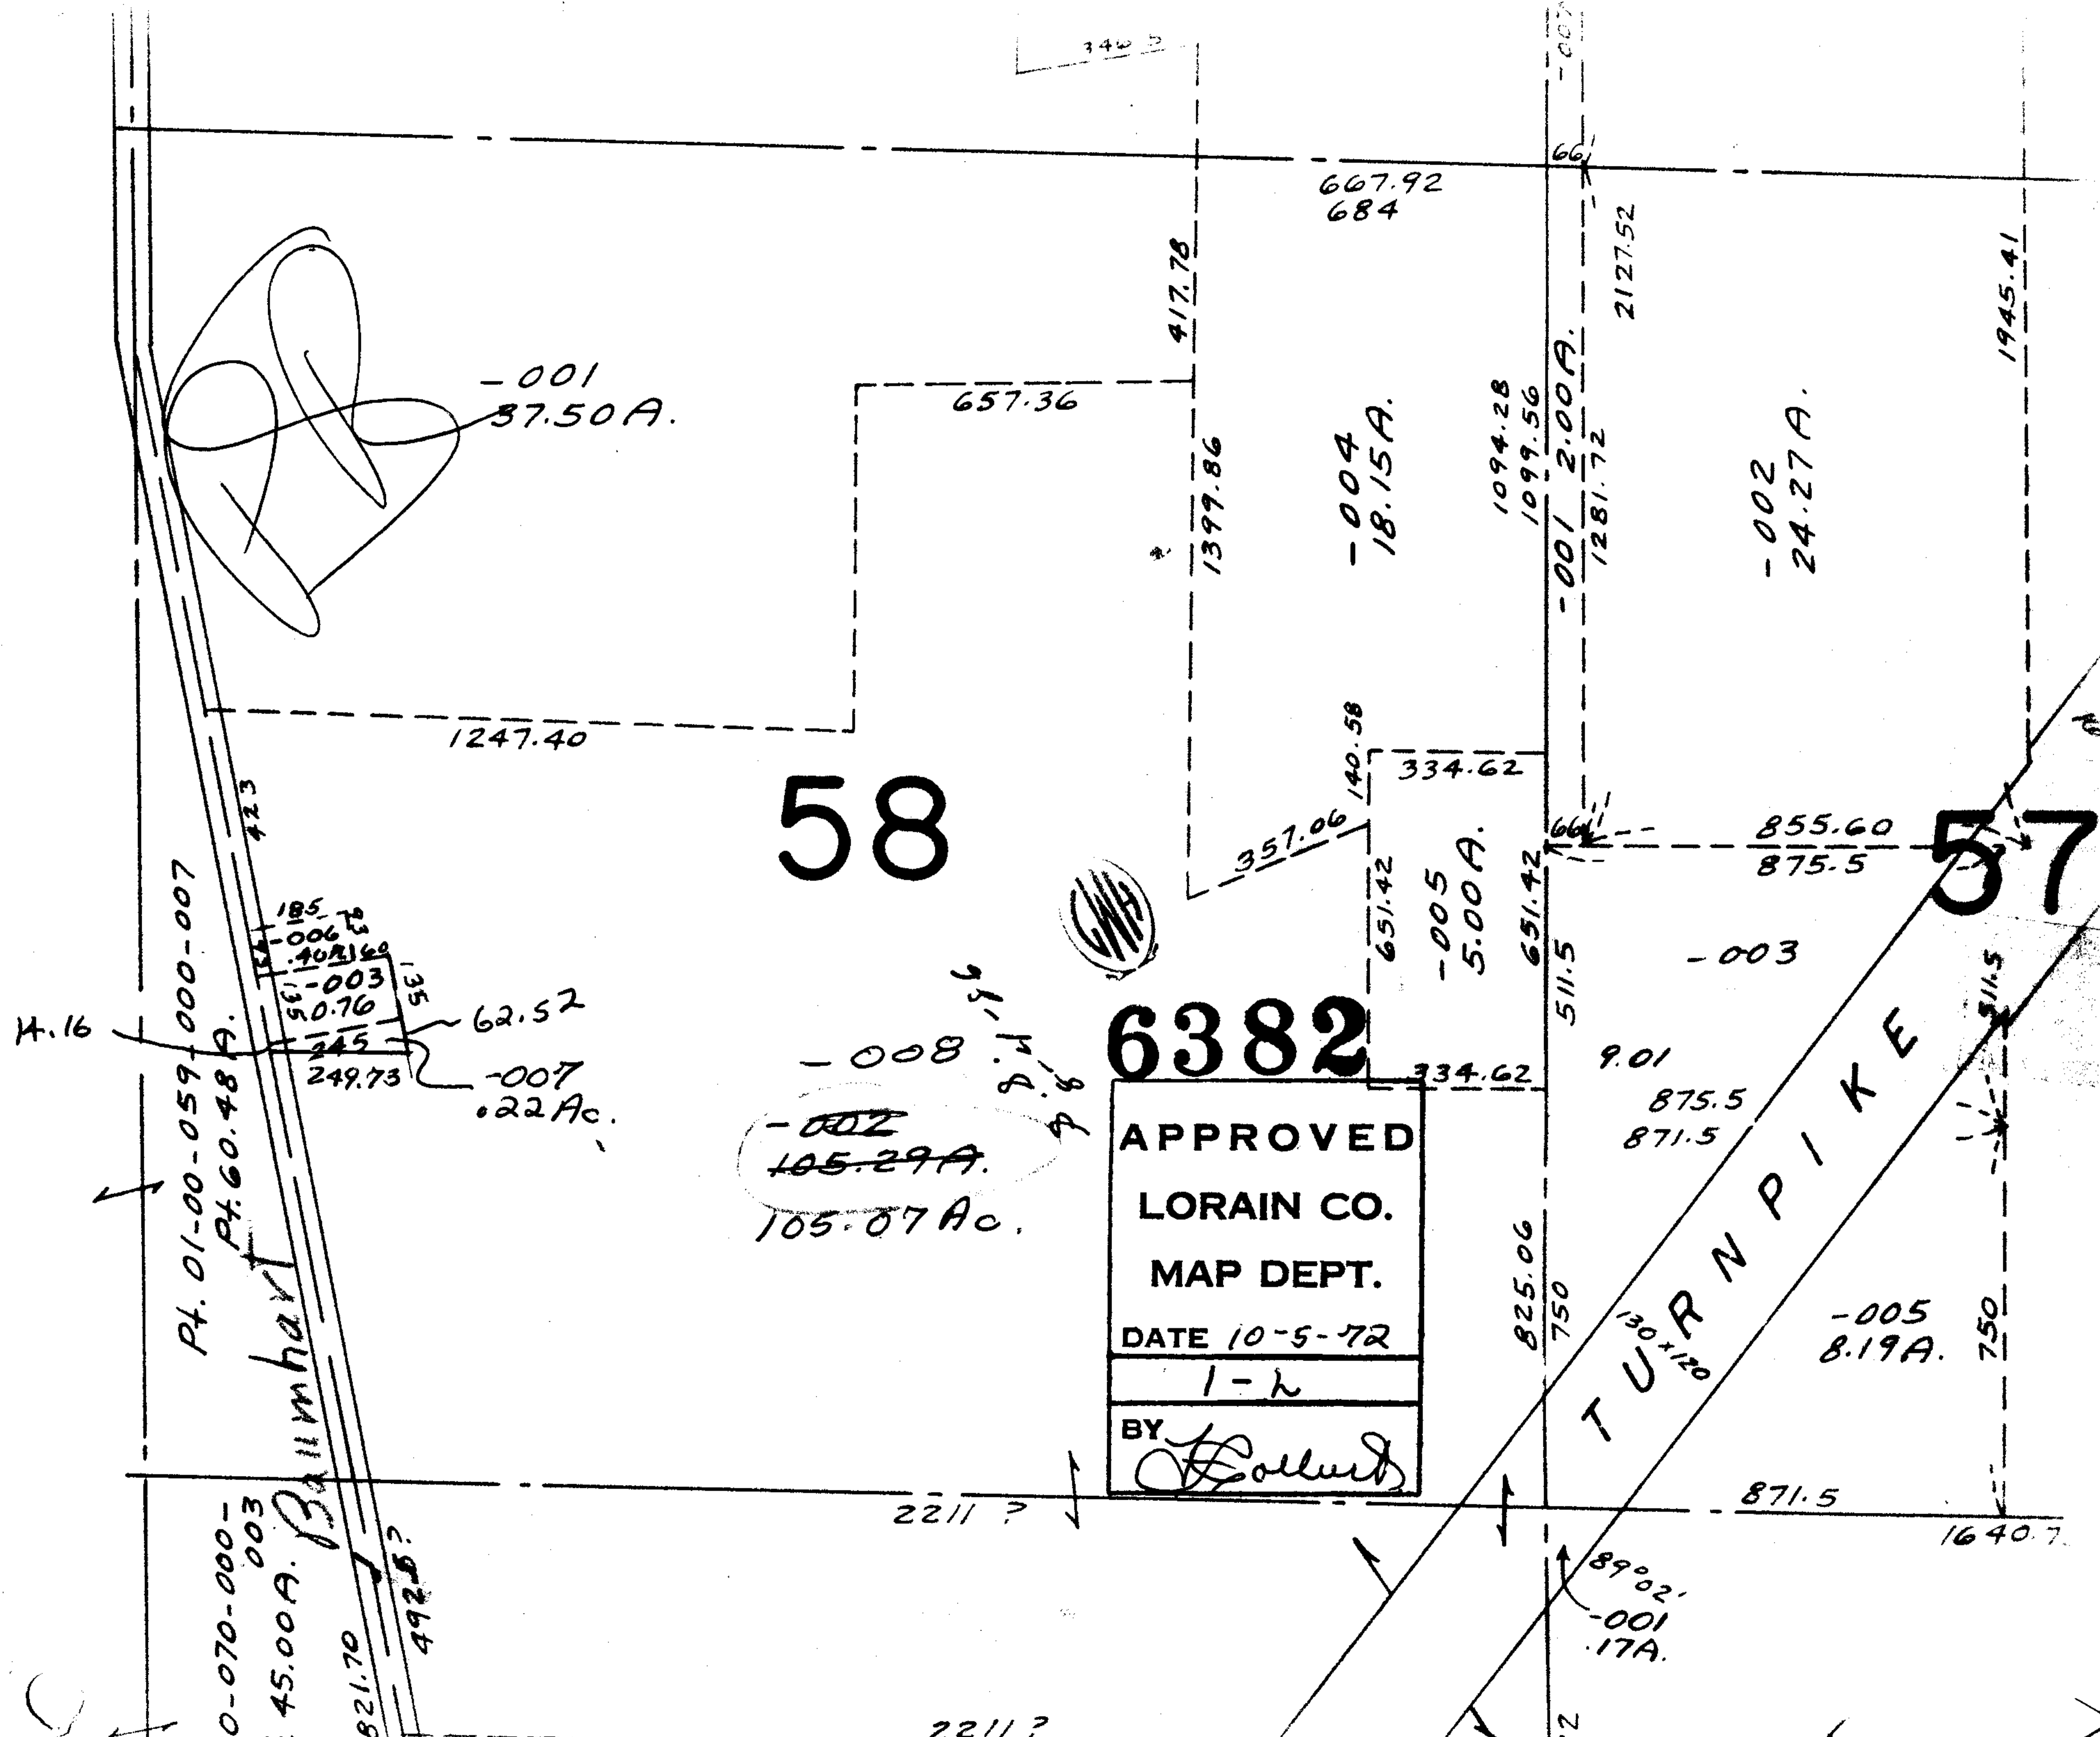


6382

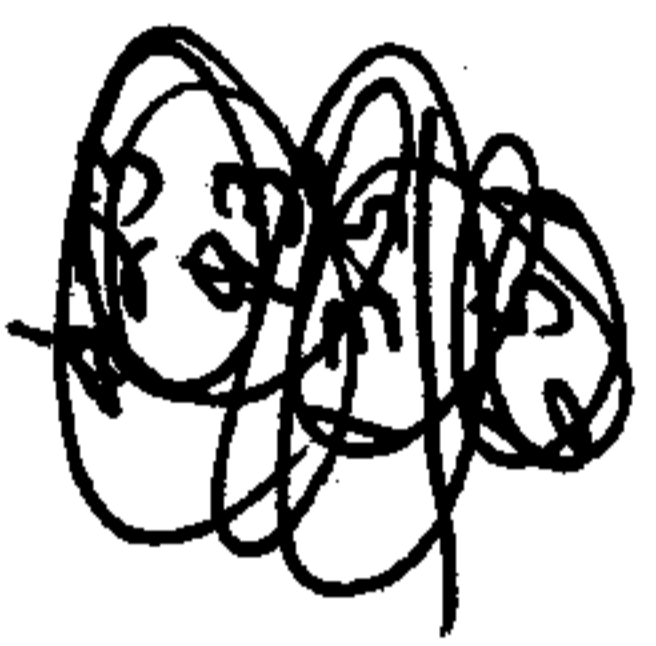

6382

APPROVED
 LORAIN CO.
 MAP DEPT.
 DATE 10-5-72
 1-h
 BY *Lollub*

58

57

4.16
 Pt. 01-00-059-000-007
 Pt. 60.48 A.

821.70
 492.5?
 Pt. 45.00 A. Baumhart

185
 1006.75
 4021.60
 50.76
 245
 249.73

62.52
 -007
 22 Ac.

-002
 105.29 A.
 105.07 Ac.

-008
 91.46
 P.M. 8
 P. 8

667.92
 684

-004
 18.15 A.

1094.28
 1099.56

-001
 2.00 A.

-002
 24.27 A.

357.06
 140.58
 651.42
 -005
 5.00 A.

334.62

651.42
 511.5

-003

9.01
 875.5
 871.5

334.62

825.06
 750

TURNPIKE
 130 x 120

-005
 8.19 A.

871.5

1640.7

2211 ?

2211 ?

22

8902
 -001
 17 A.

2127.52

1945.41

