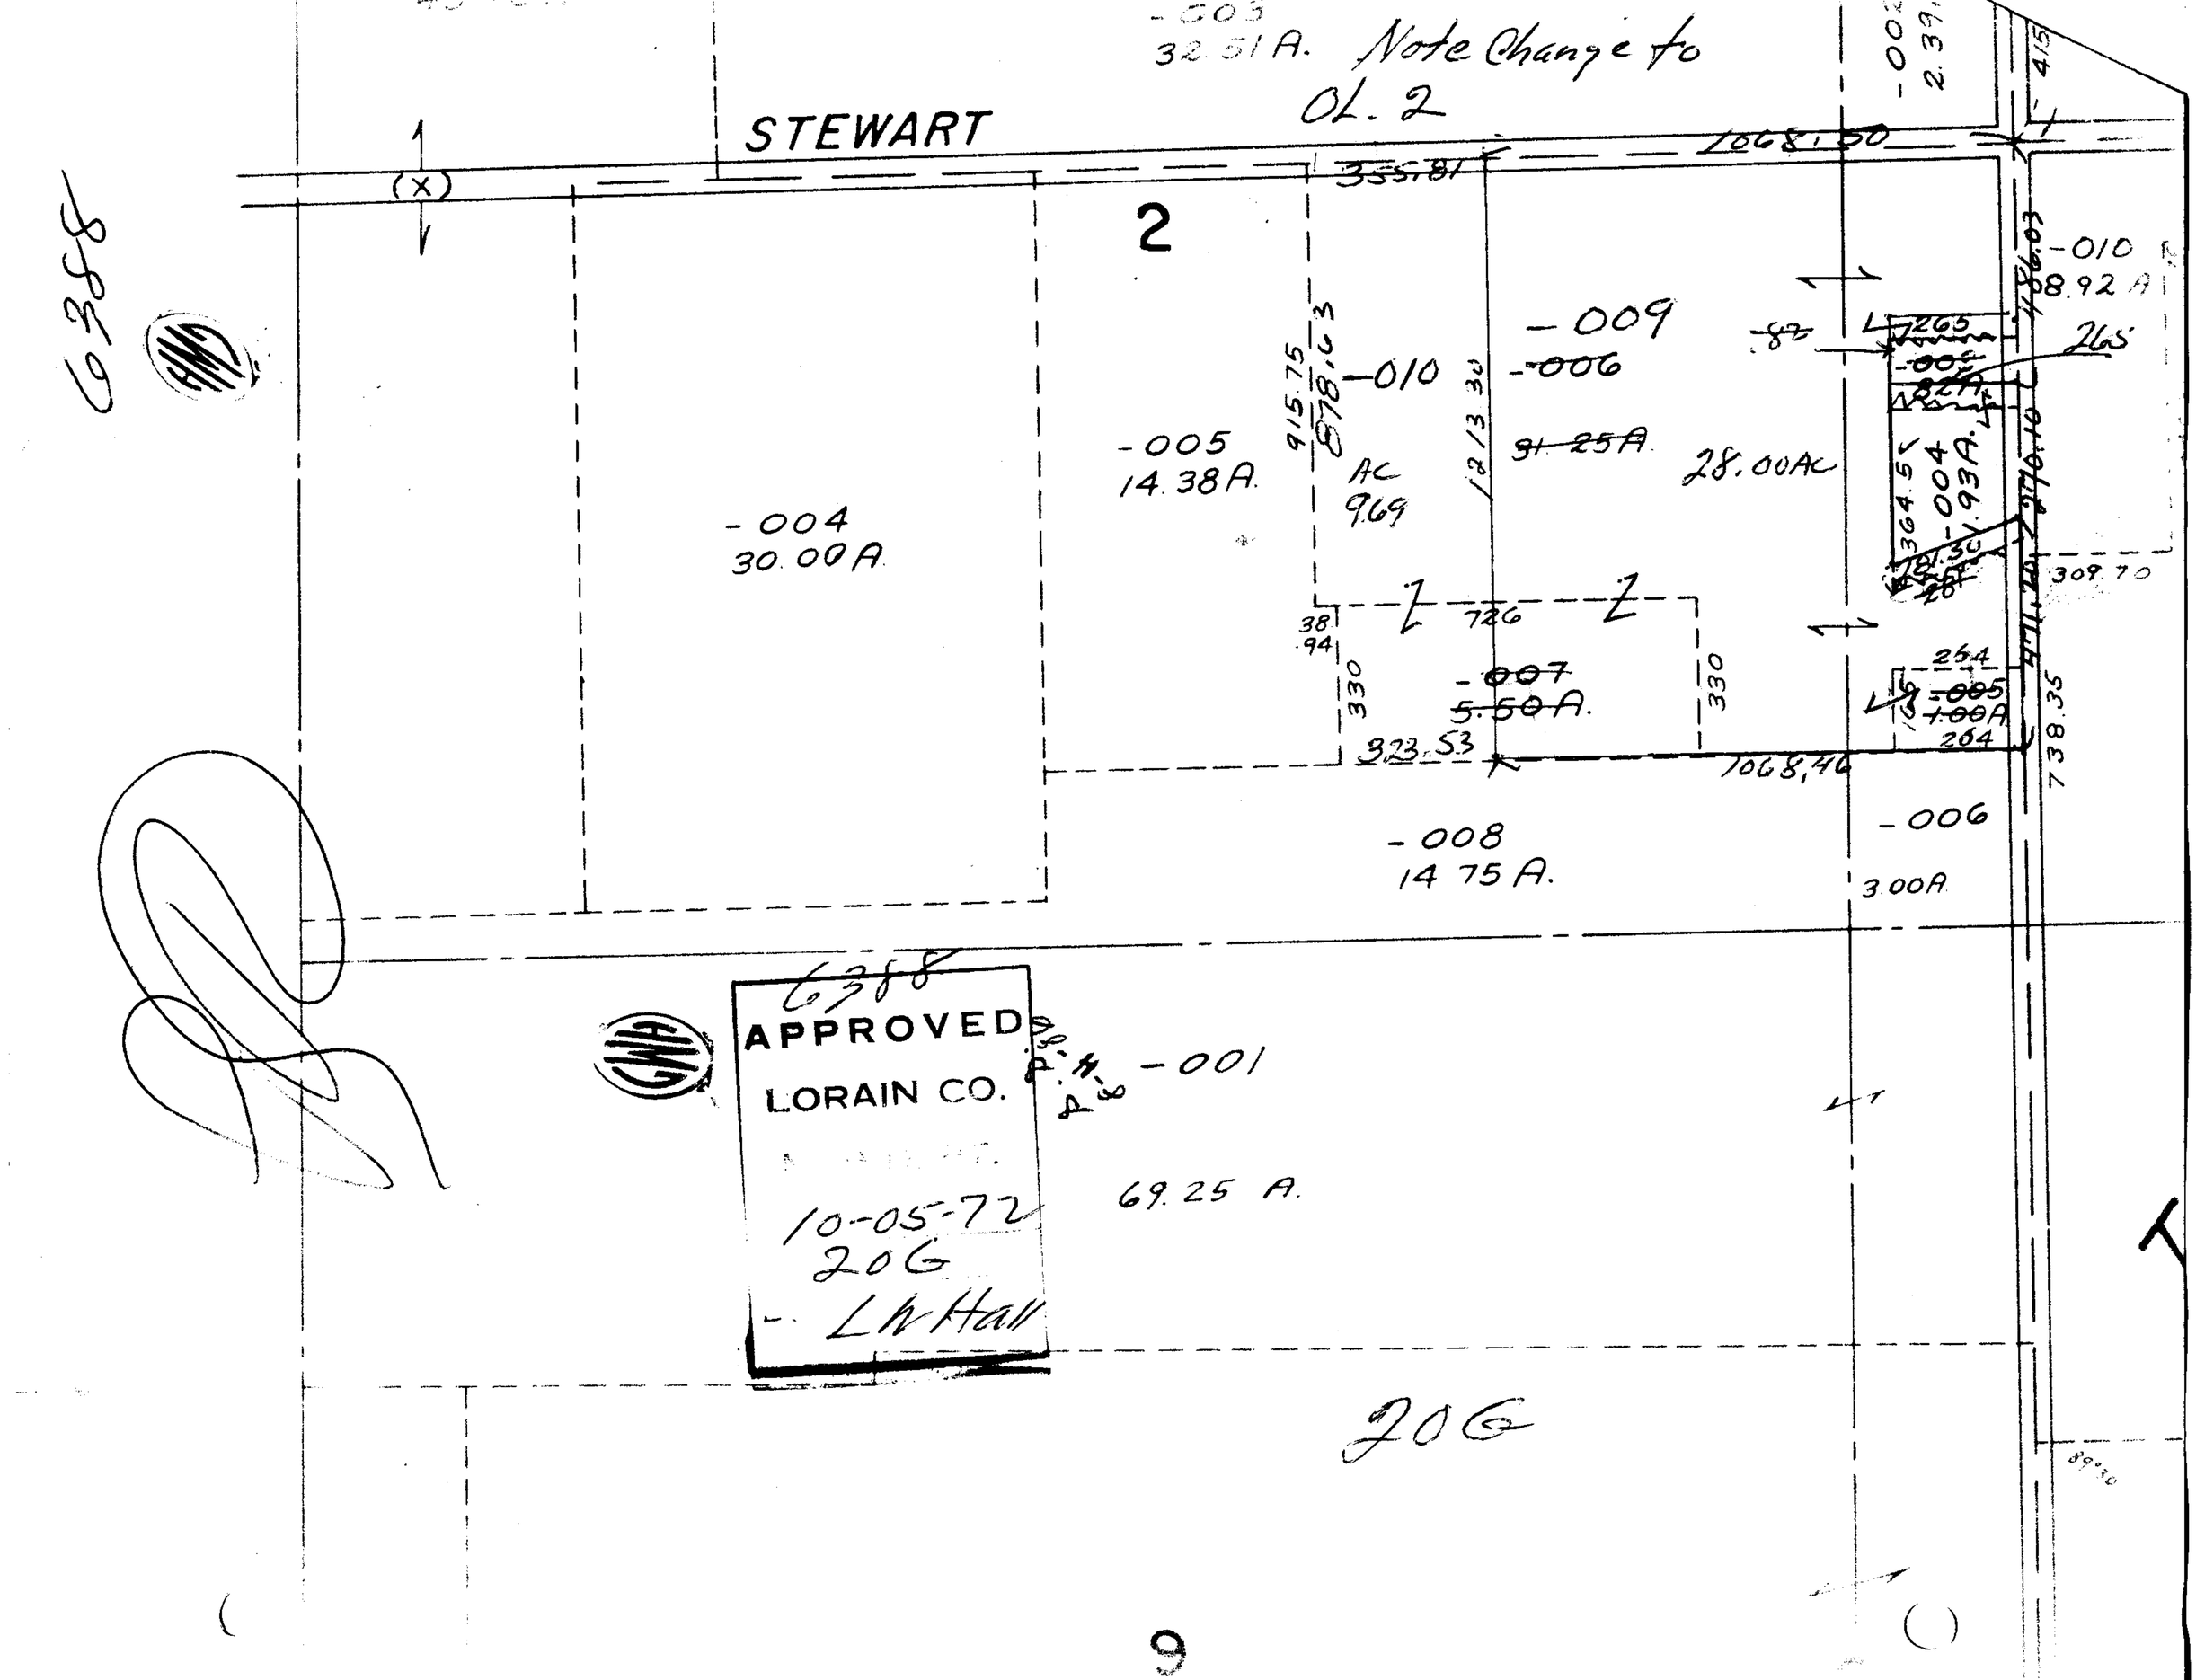

-003
32.51 A.
Note Change to
OL. 2
STEWART
(X)
2
1068.50
355.81
-010
8.92 A
-009
-006
-010
-005
14.38 A.
AC
9.69
28.00 AC
-004
30.00 A.
-004
1.93 A.
309.70
726
-007
5.50 A.
330
330
323.53
1068.46
-008
14.75 A.
-006
3.00 A.
738.35
6388
APPROVED
LORAIN CO.
10-05-72
20G
LW Hall
-001
69.25 A.
20G