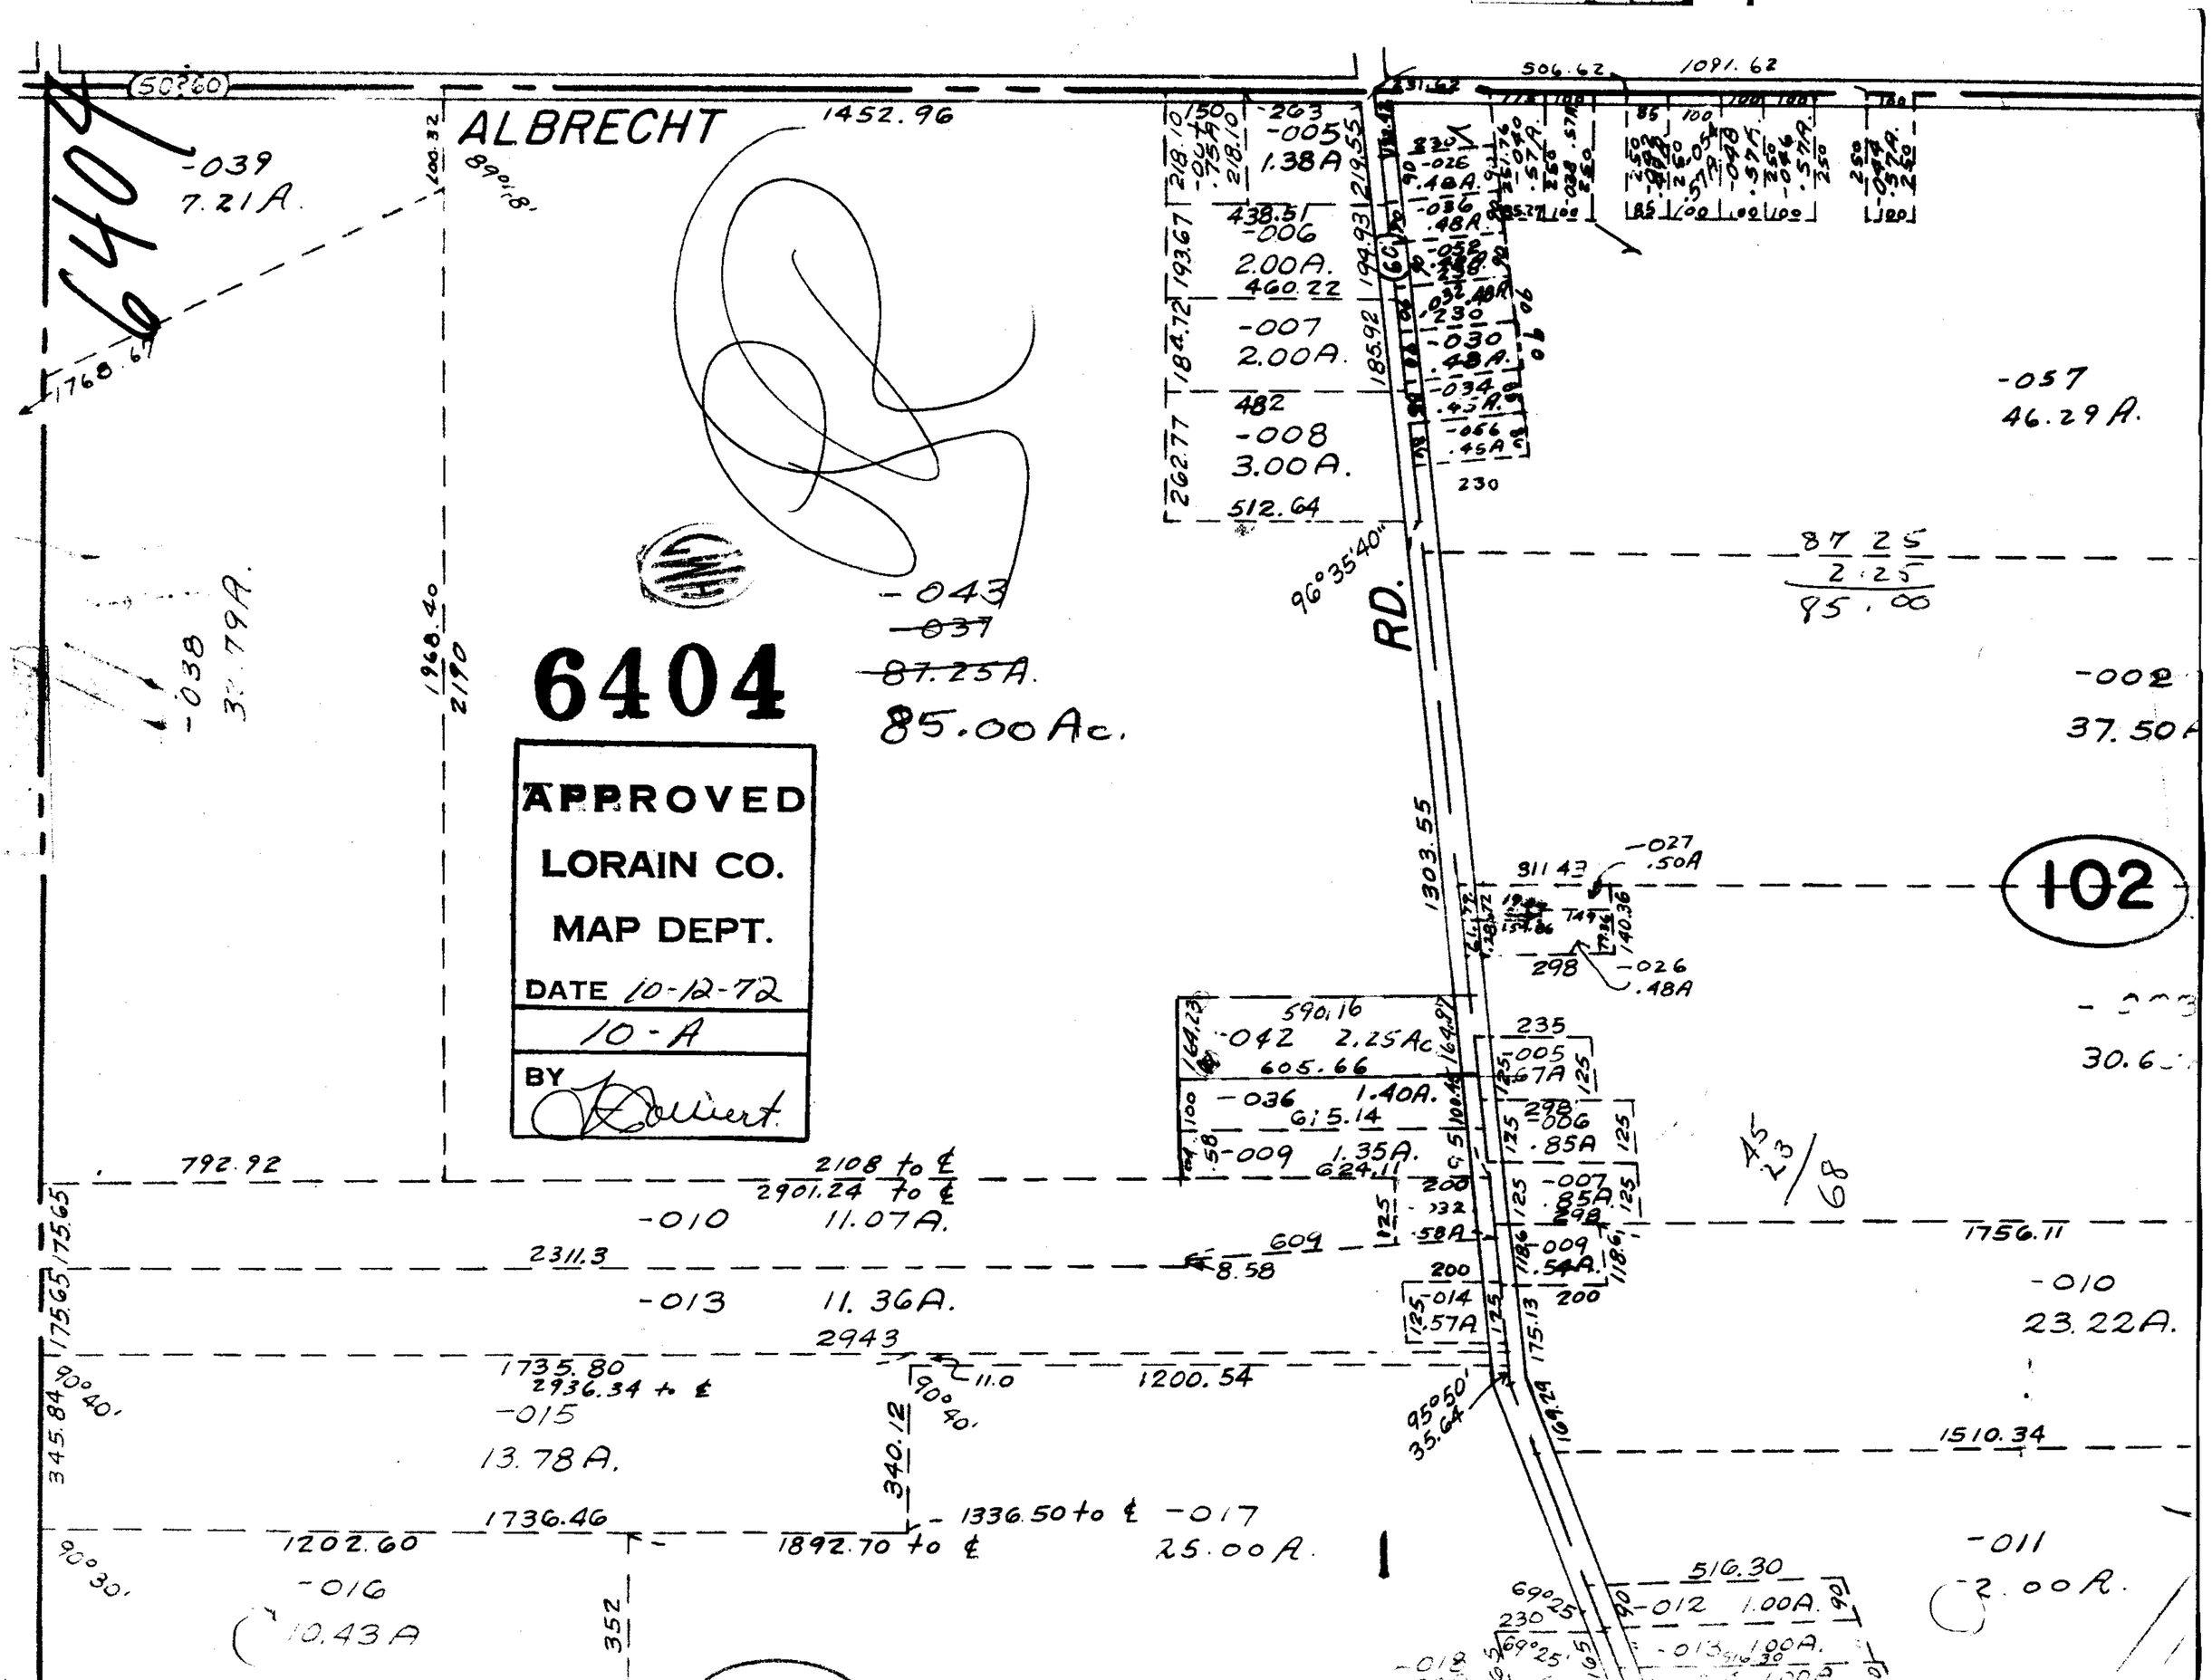

6404
ALBRECHT
RD.
1452.96
-039
7.21A.
-043
~~-037~~
~~87.25A.~~
85.00 Ac.
-038
37.79A.
-057
46.29A.
-002
37.50A
-010
23.22A.
-011
2.00A.
-012
1.00A.
-013
1.00A.
-014
.57A
-015
13.78A.
-016
10.43A
-017
25.00A.
-010
11.07A.
-013
11.36A.
-042
2.25Ac
-036
1.40A.
-009
1.35A.
-005
1.38A
-006
2.00A.
-007
2.00A.
-008
3.00A.
-026
.48A.
-030
.48A.
-034
.45A.
-056
.45A
-027
.50A
-026
.48A
-005
.67A
-006
.85A
-007
.85A
-009
.54A.
-014
.57A
1756.11
1510.34
1200.54
1736.46
1202.60
1892.70 to ℄
1336.50 to ℄
2108 to ℄
2901.24 to ℄
2311.3
2943
1735.80
2936.34 to ℄
792.92
1768.67
1968.40
2190
1303.55
96°35'40"
95°50'
35.64
69°25'
45
23
68
102
APPROVED
LORAIN CO.
MAP DEPT.
DATE 10-12-72
10-A
BY