

6405
APPROVED

LORAIN CO.

MAP DEPT.

DATE 10-17-72


6405
6405
6-86



POPLAR

ELMA

DILWORTH

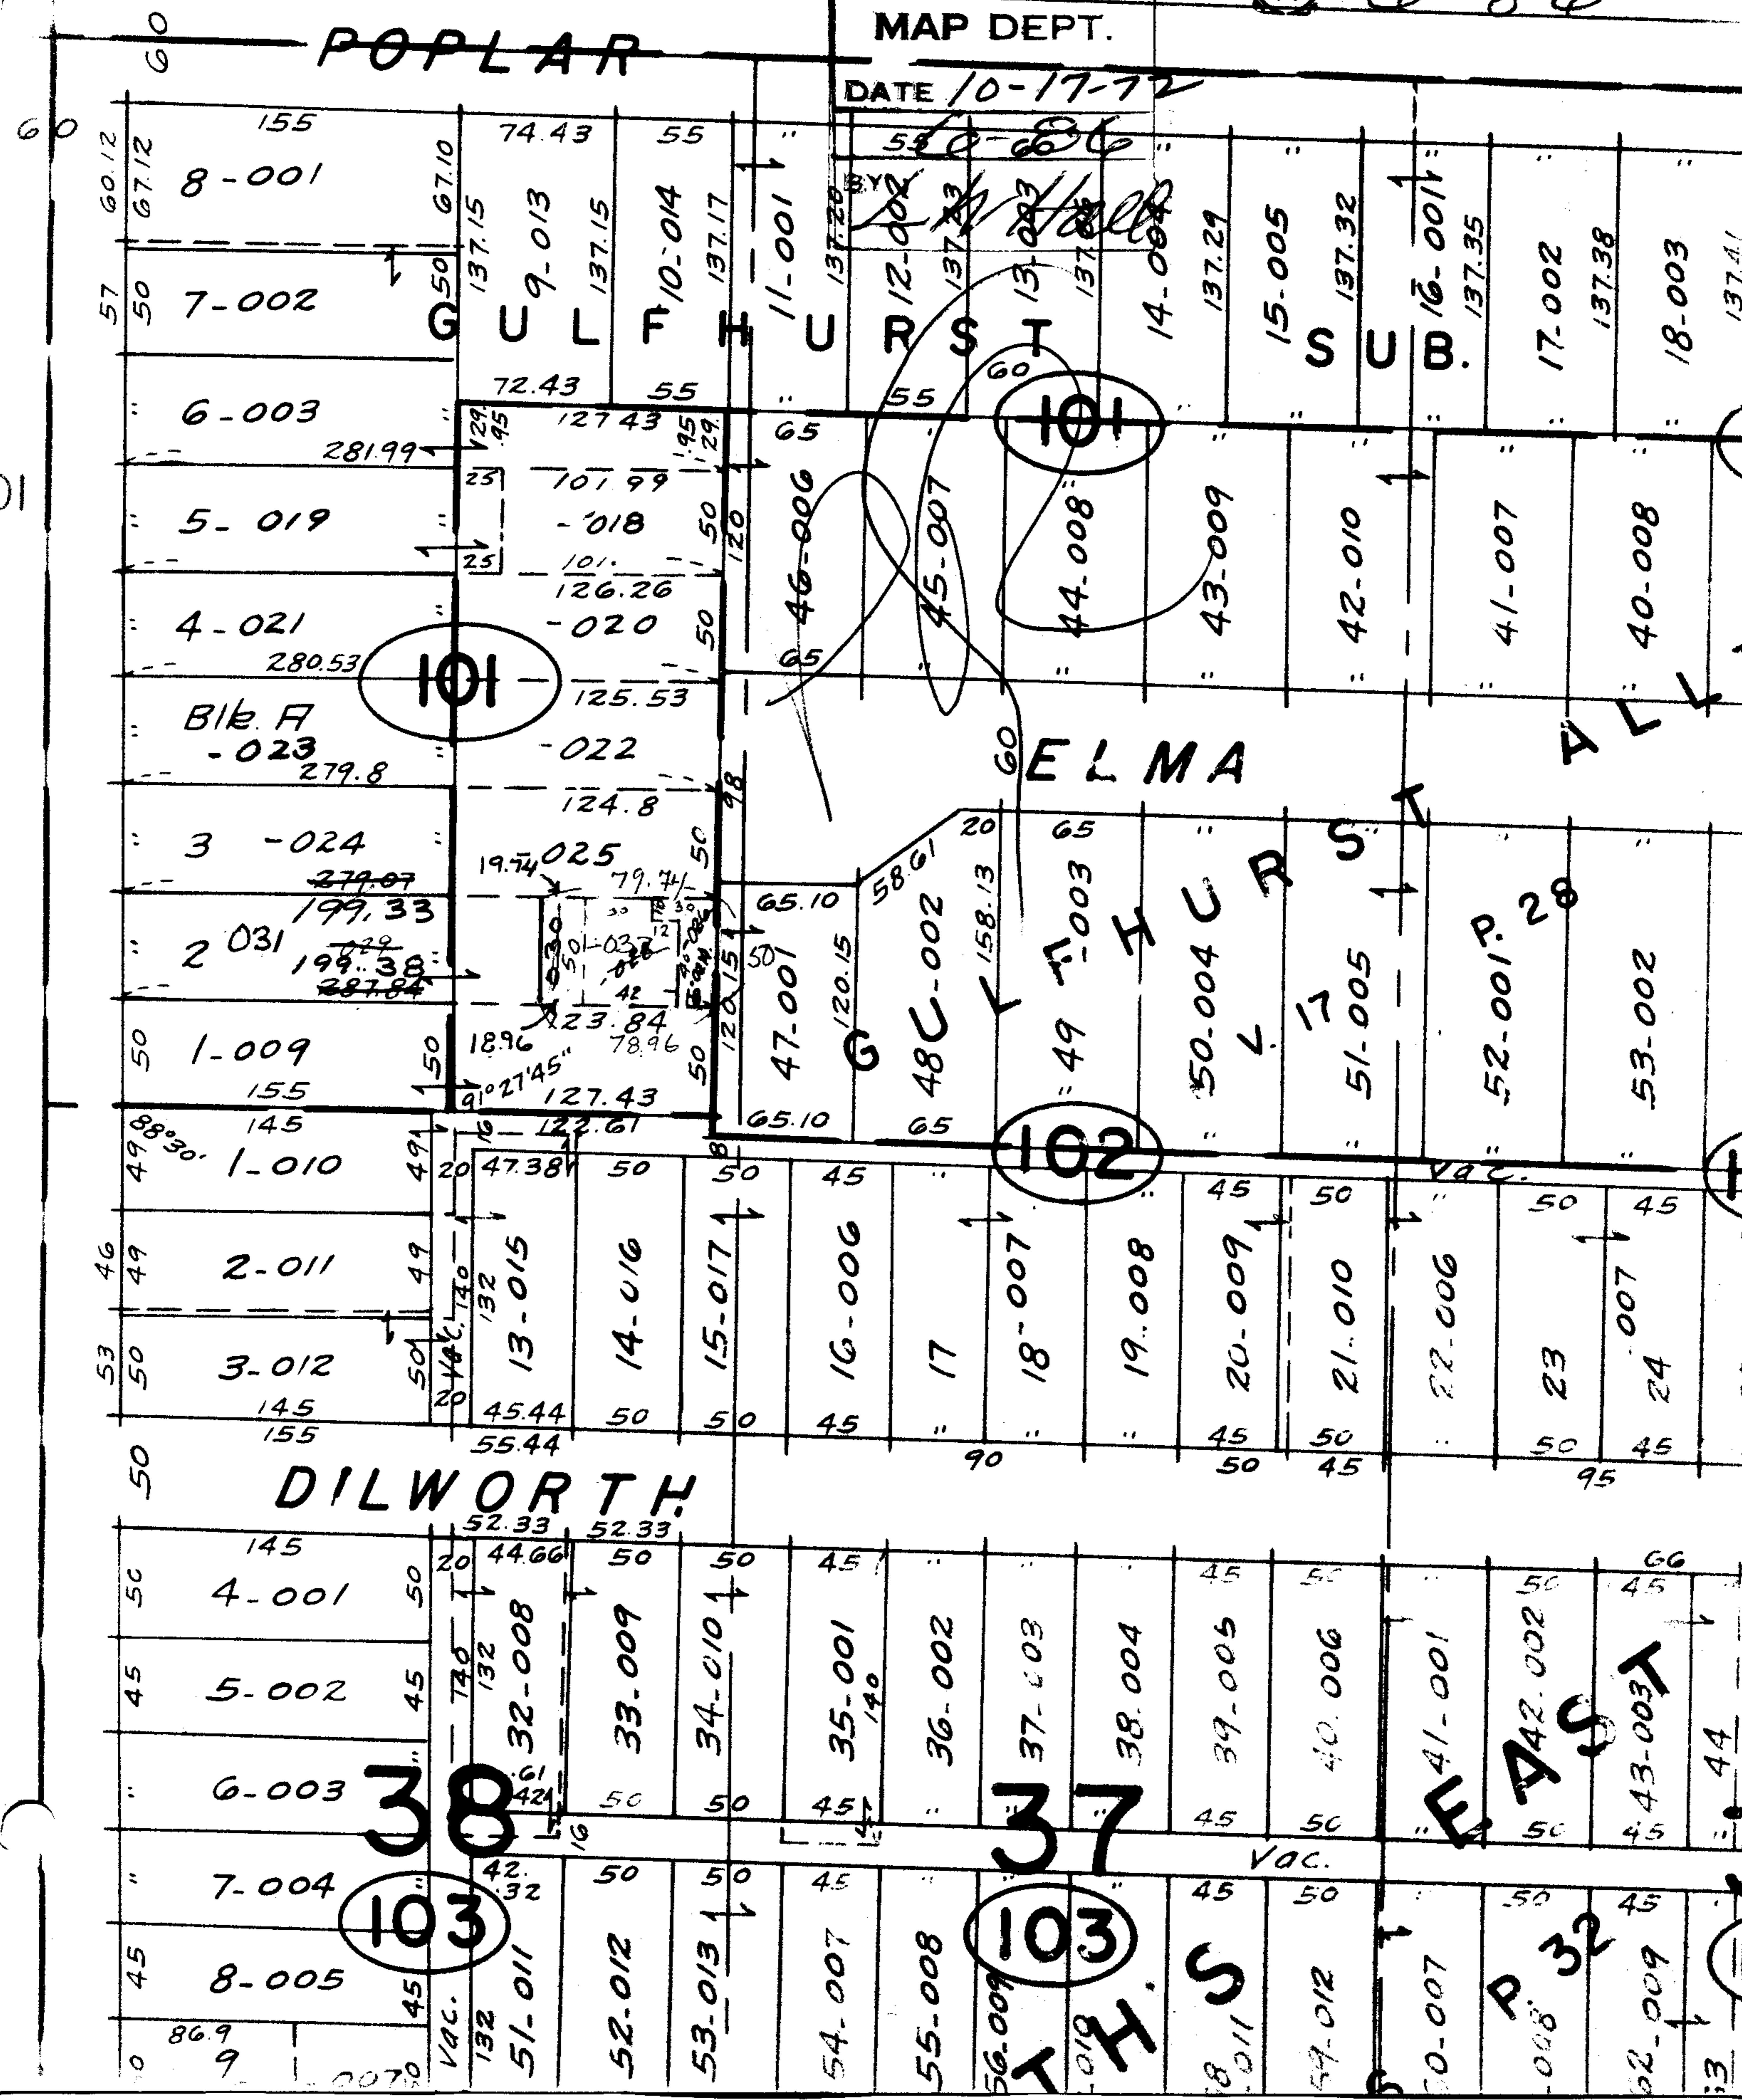

101

101

102

103

103

38

37

32

301
6-86

A

H

1