
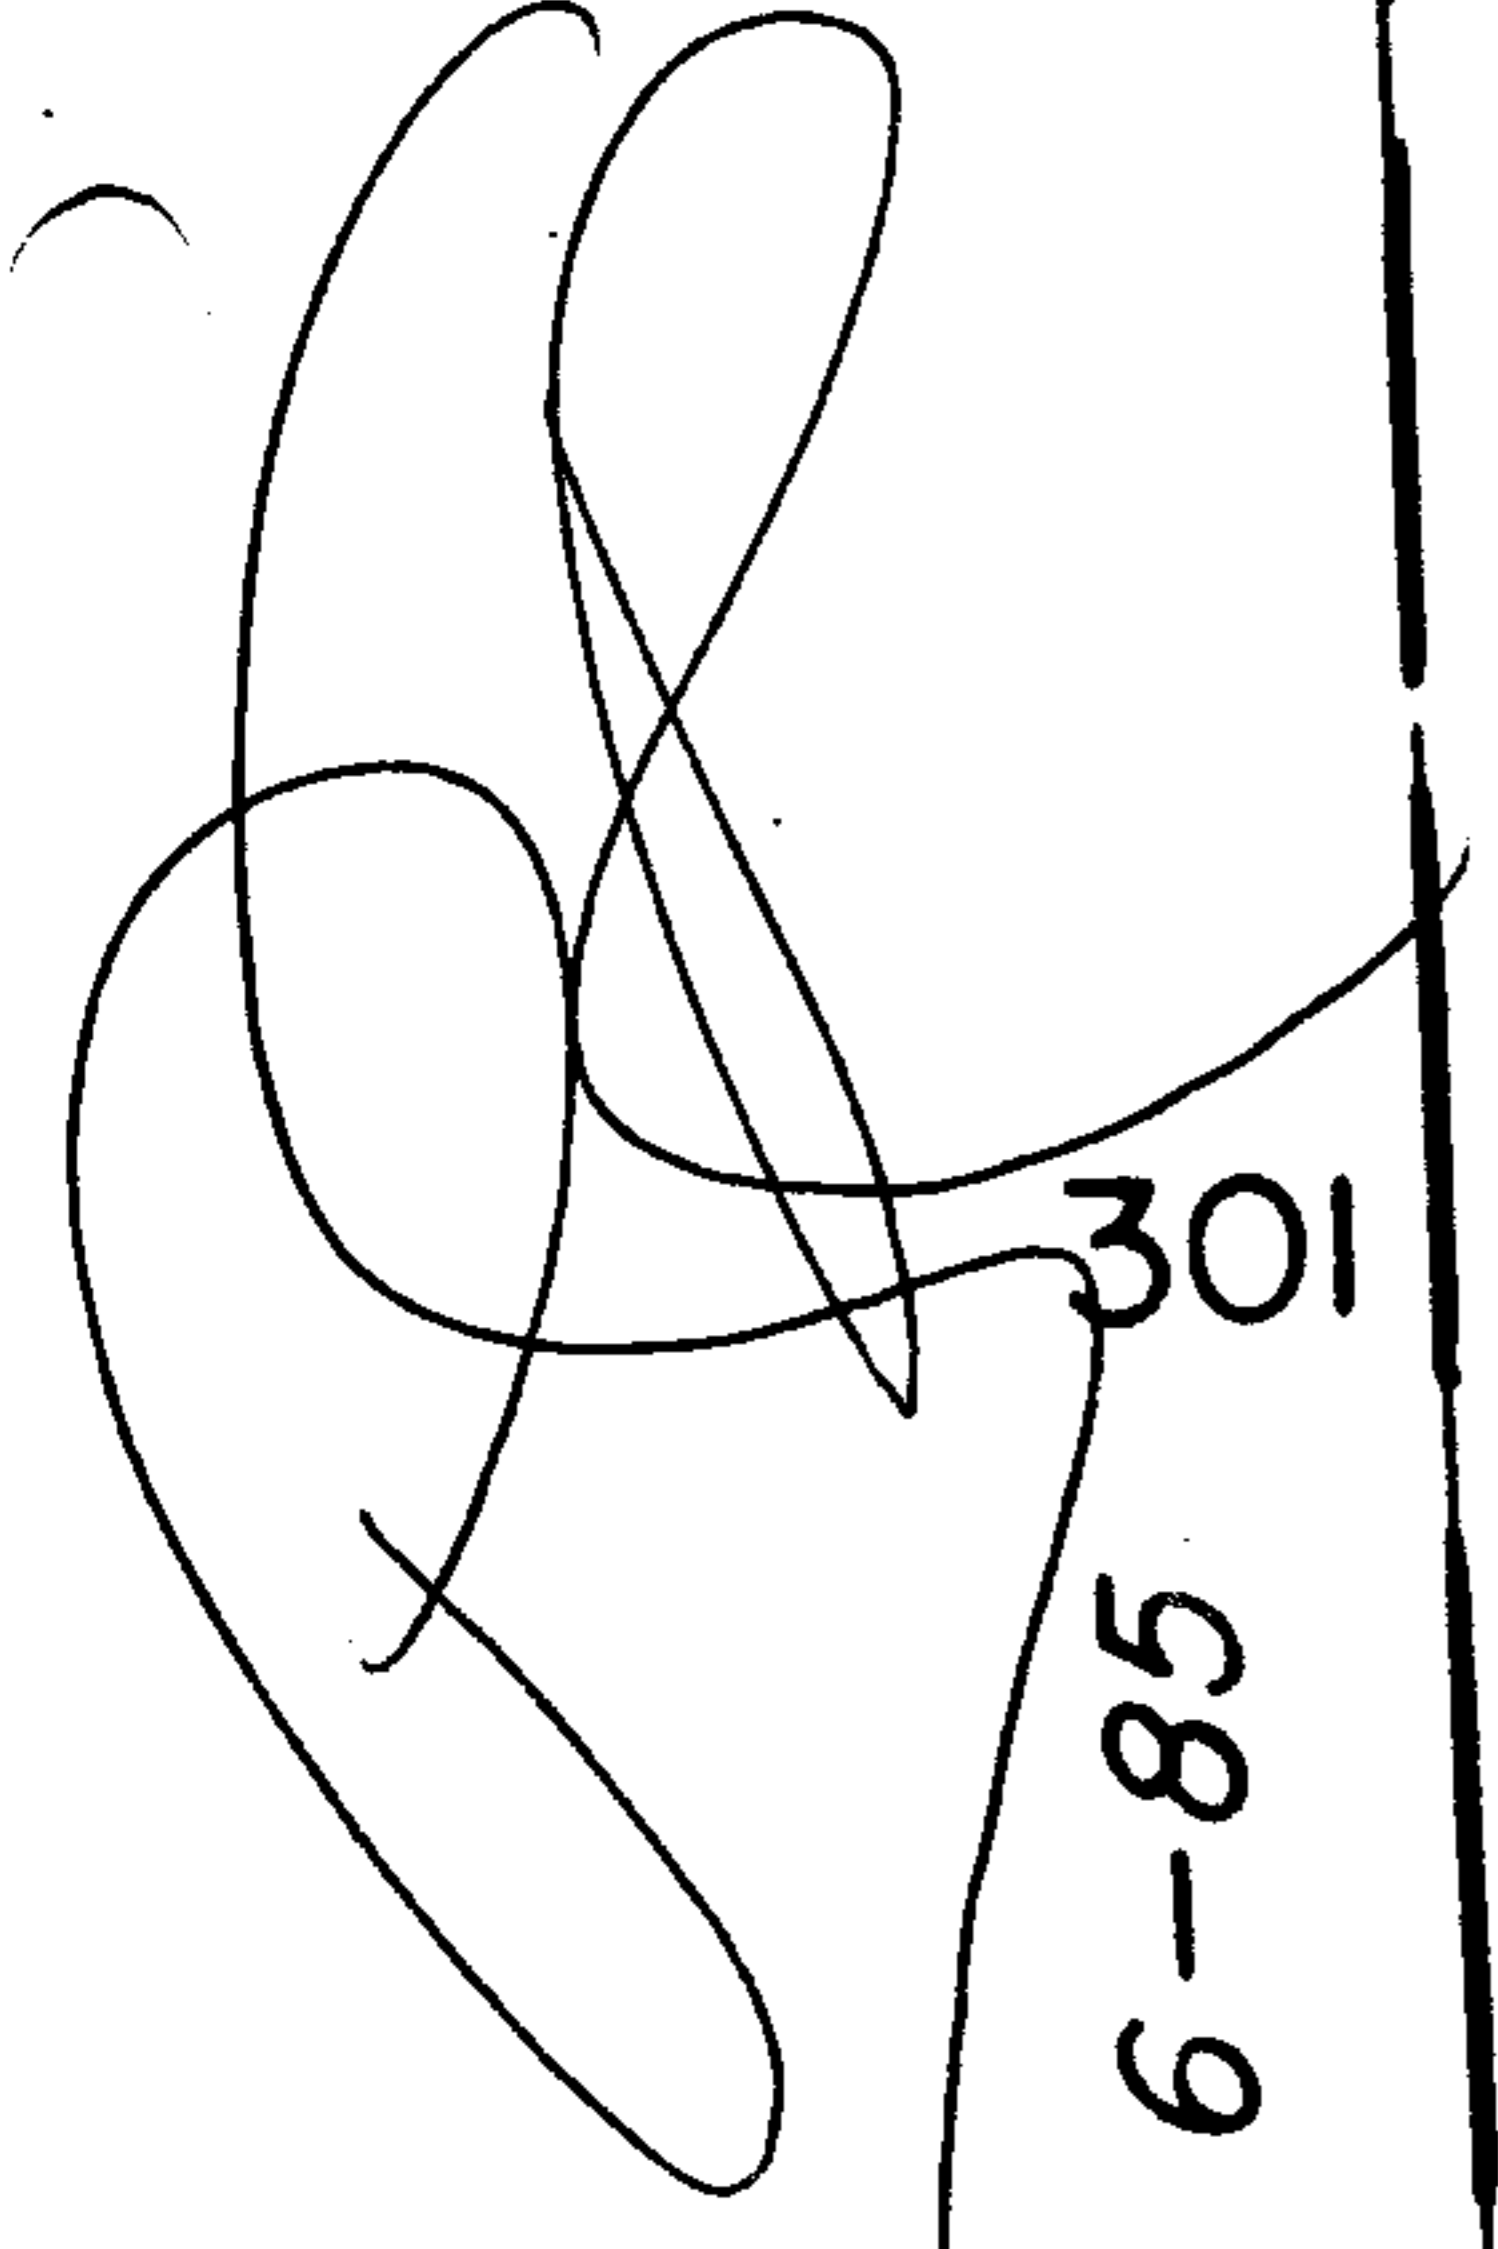


#6405-6405

POPLAR

Combination 6-86

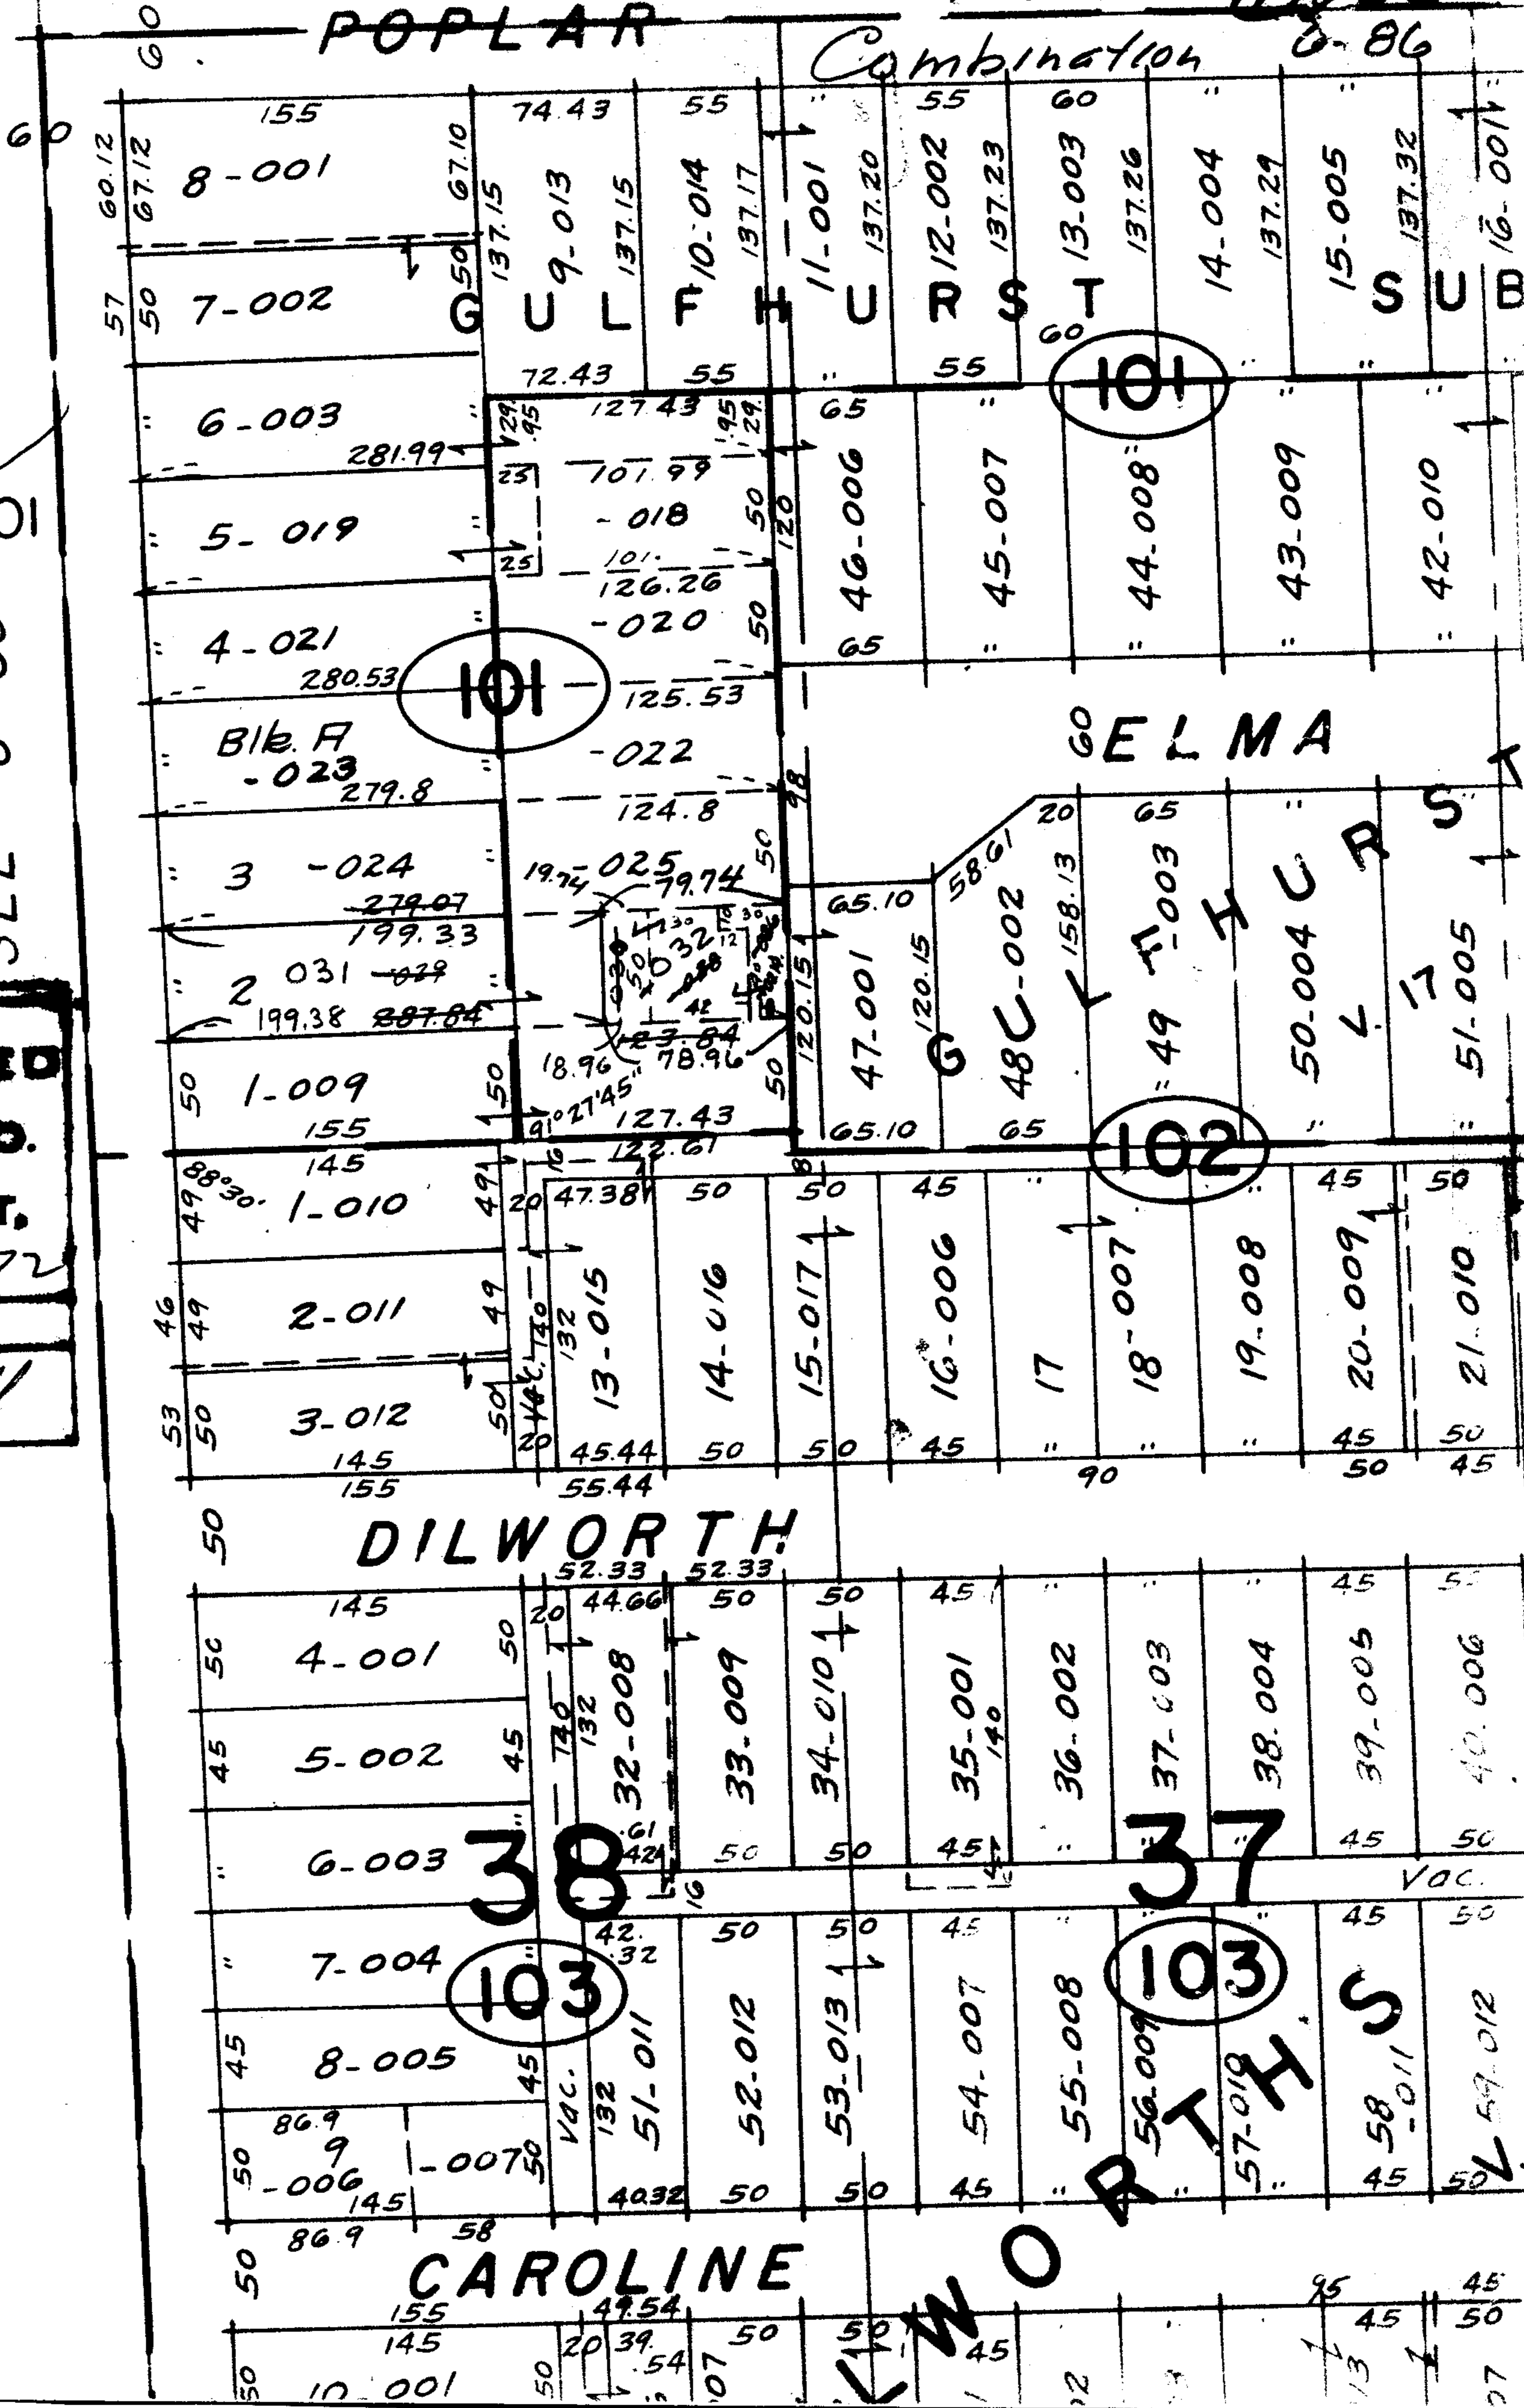

SEE 6-85

6405

APPROVED
 LORAIN CO.
 DEPT.
 DATE 10-17-72
 6-86
 L. W. Hall

CAROLINE

L W O

R T H S