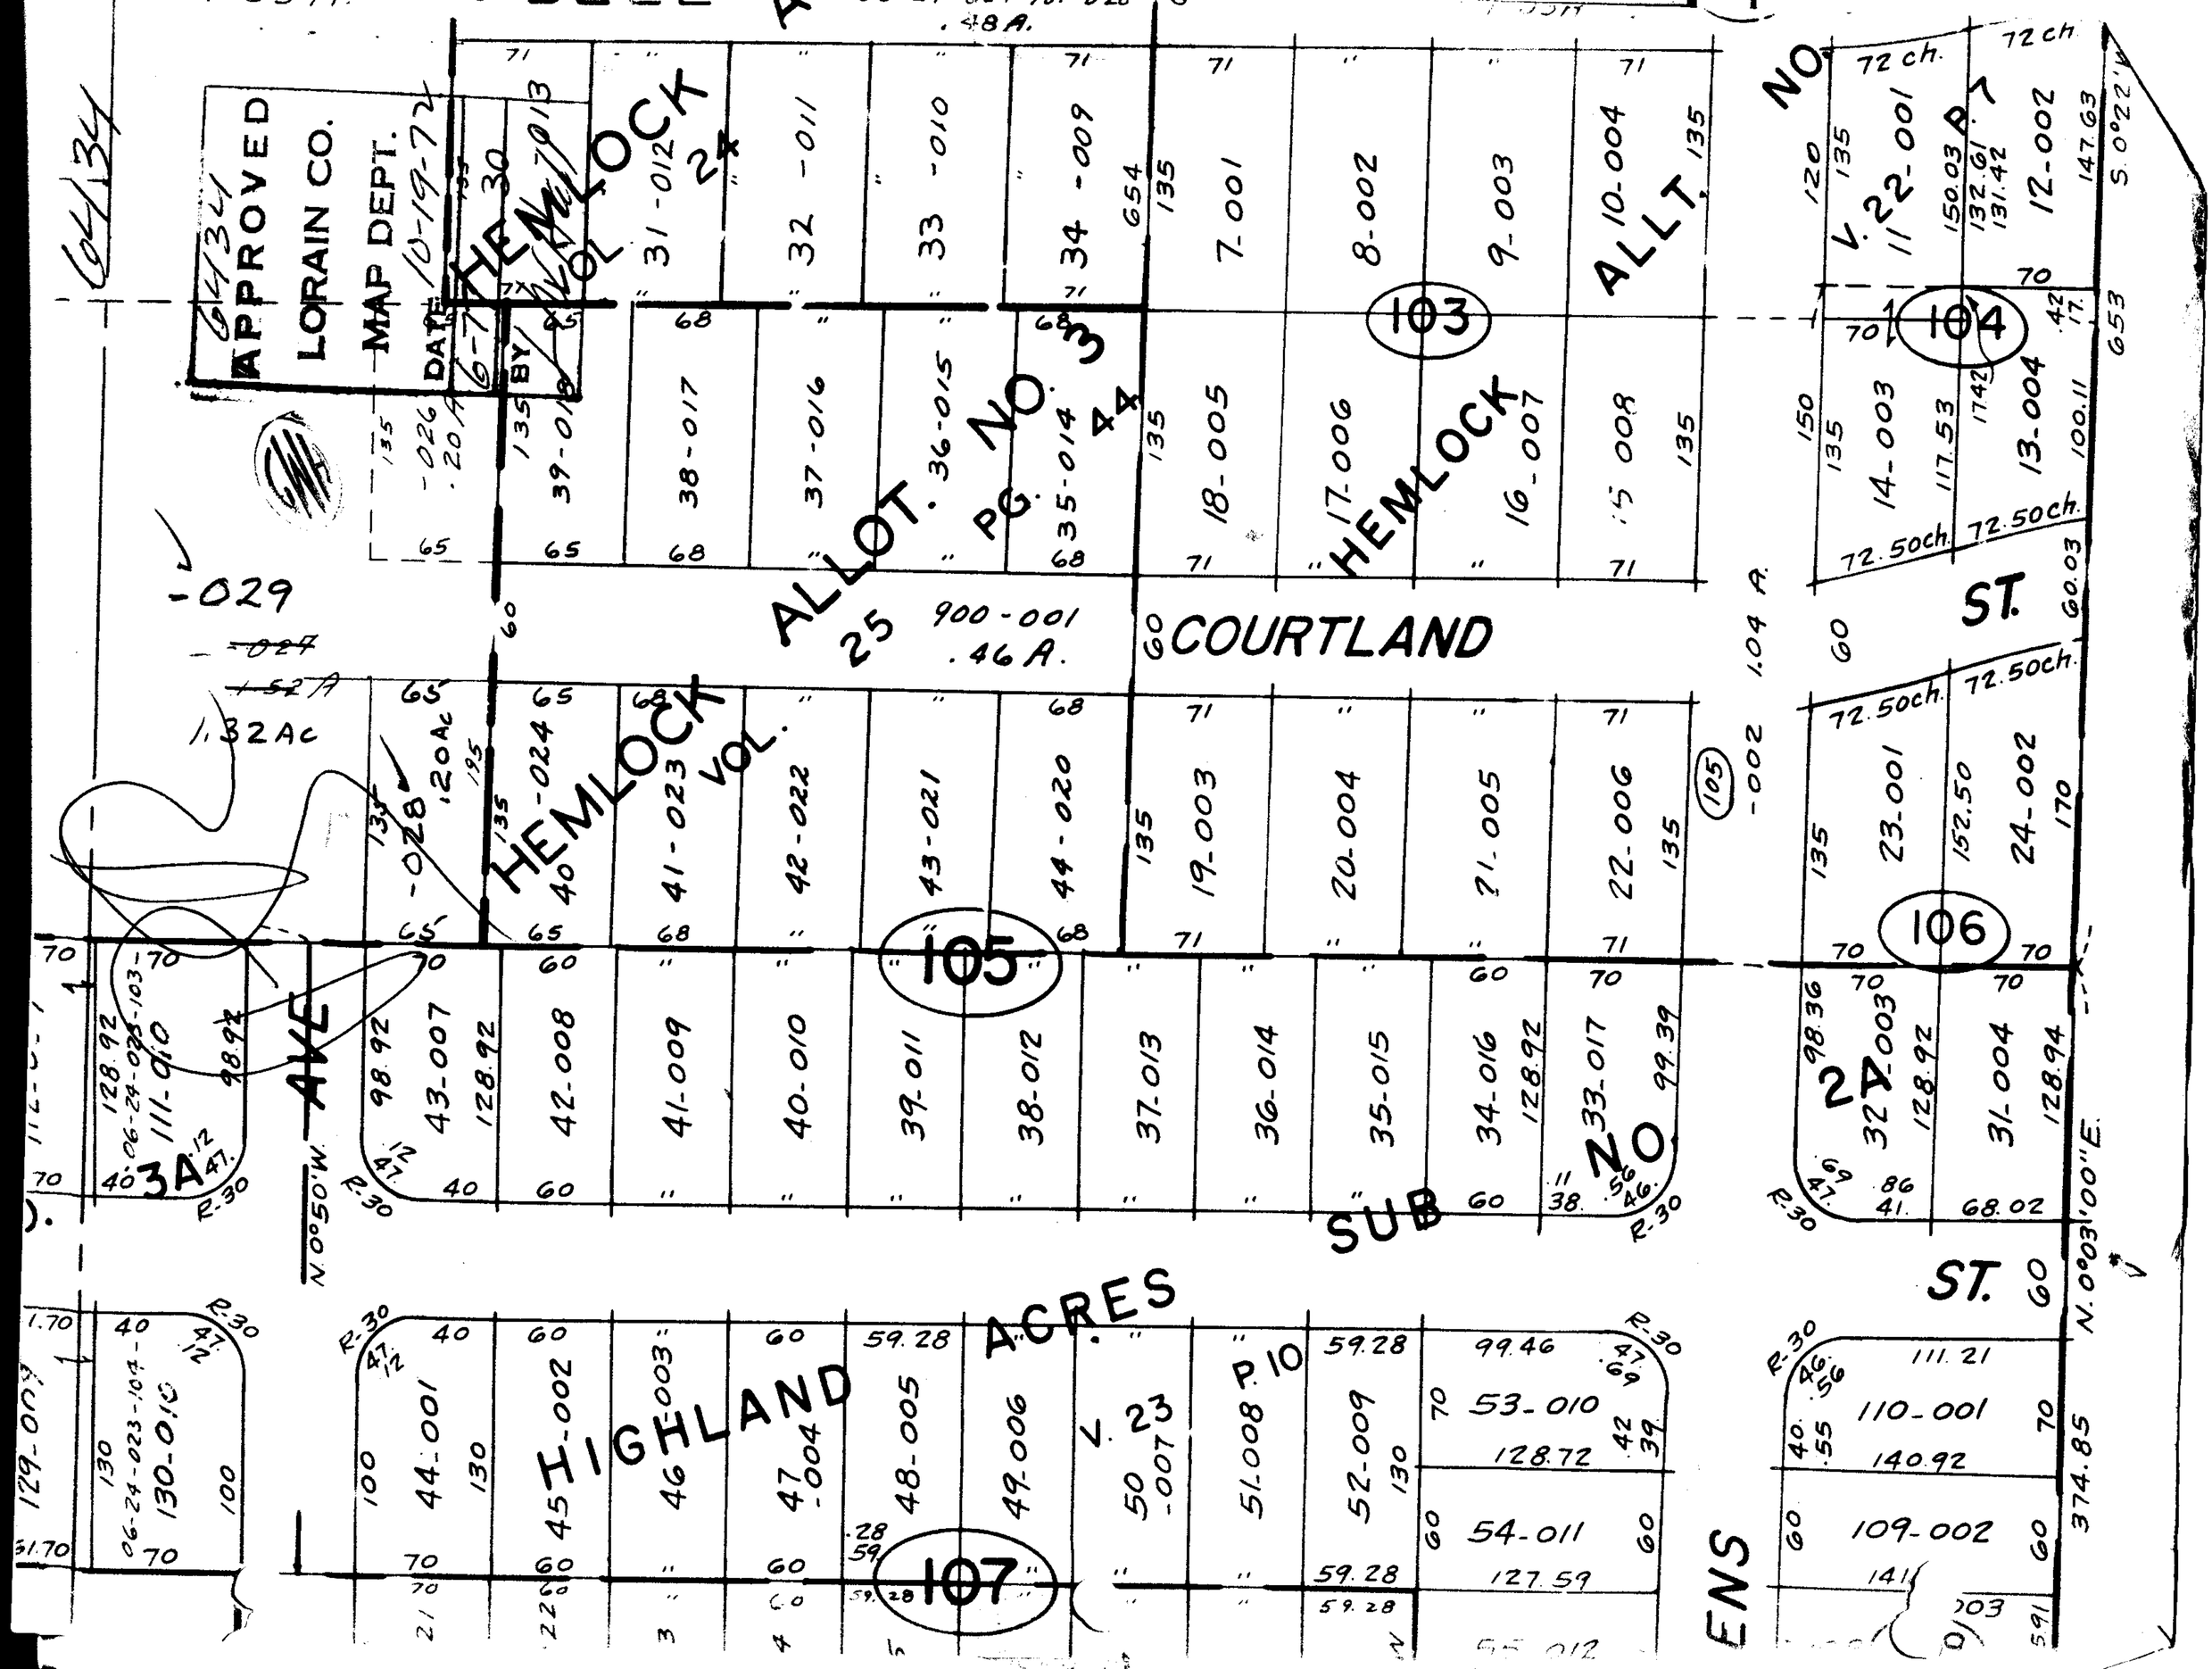

APPROVED
LORAIN CO.
MAP DEPT.
DATE 10-19-72
BY
HEMLOCK
VOL. 24
ALLOT. NO. 3
PG. 44
HEMLOCK
ALLT. NO.
V. 22 P. 7
COURTLAND
ST.
HEMLOCK
VOL. 25
900-001
.46 A.
HIGHLAND ACRES
SUB NO.
V. 23 P. 10
AVE
ST.
103
104
105
106
107