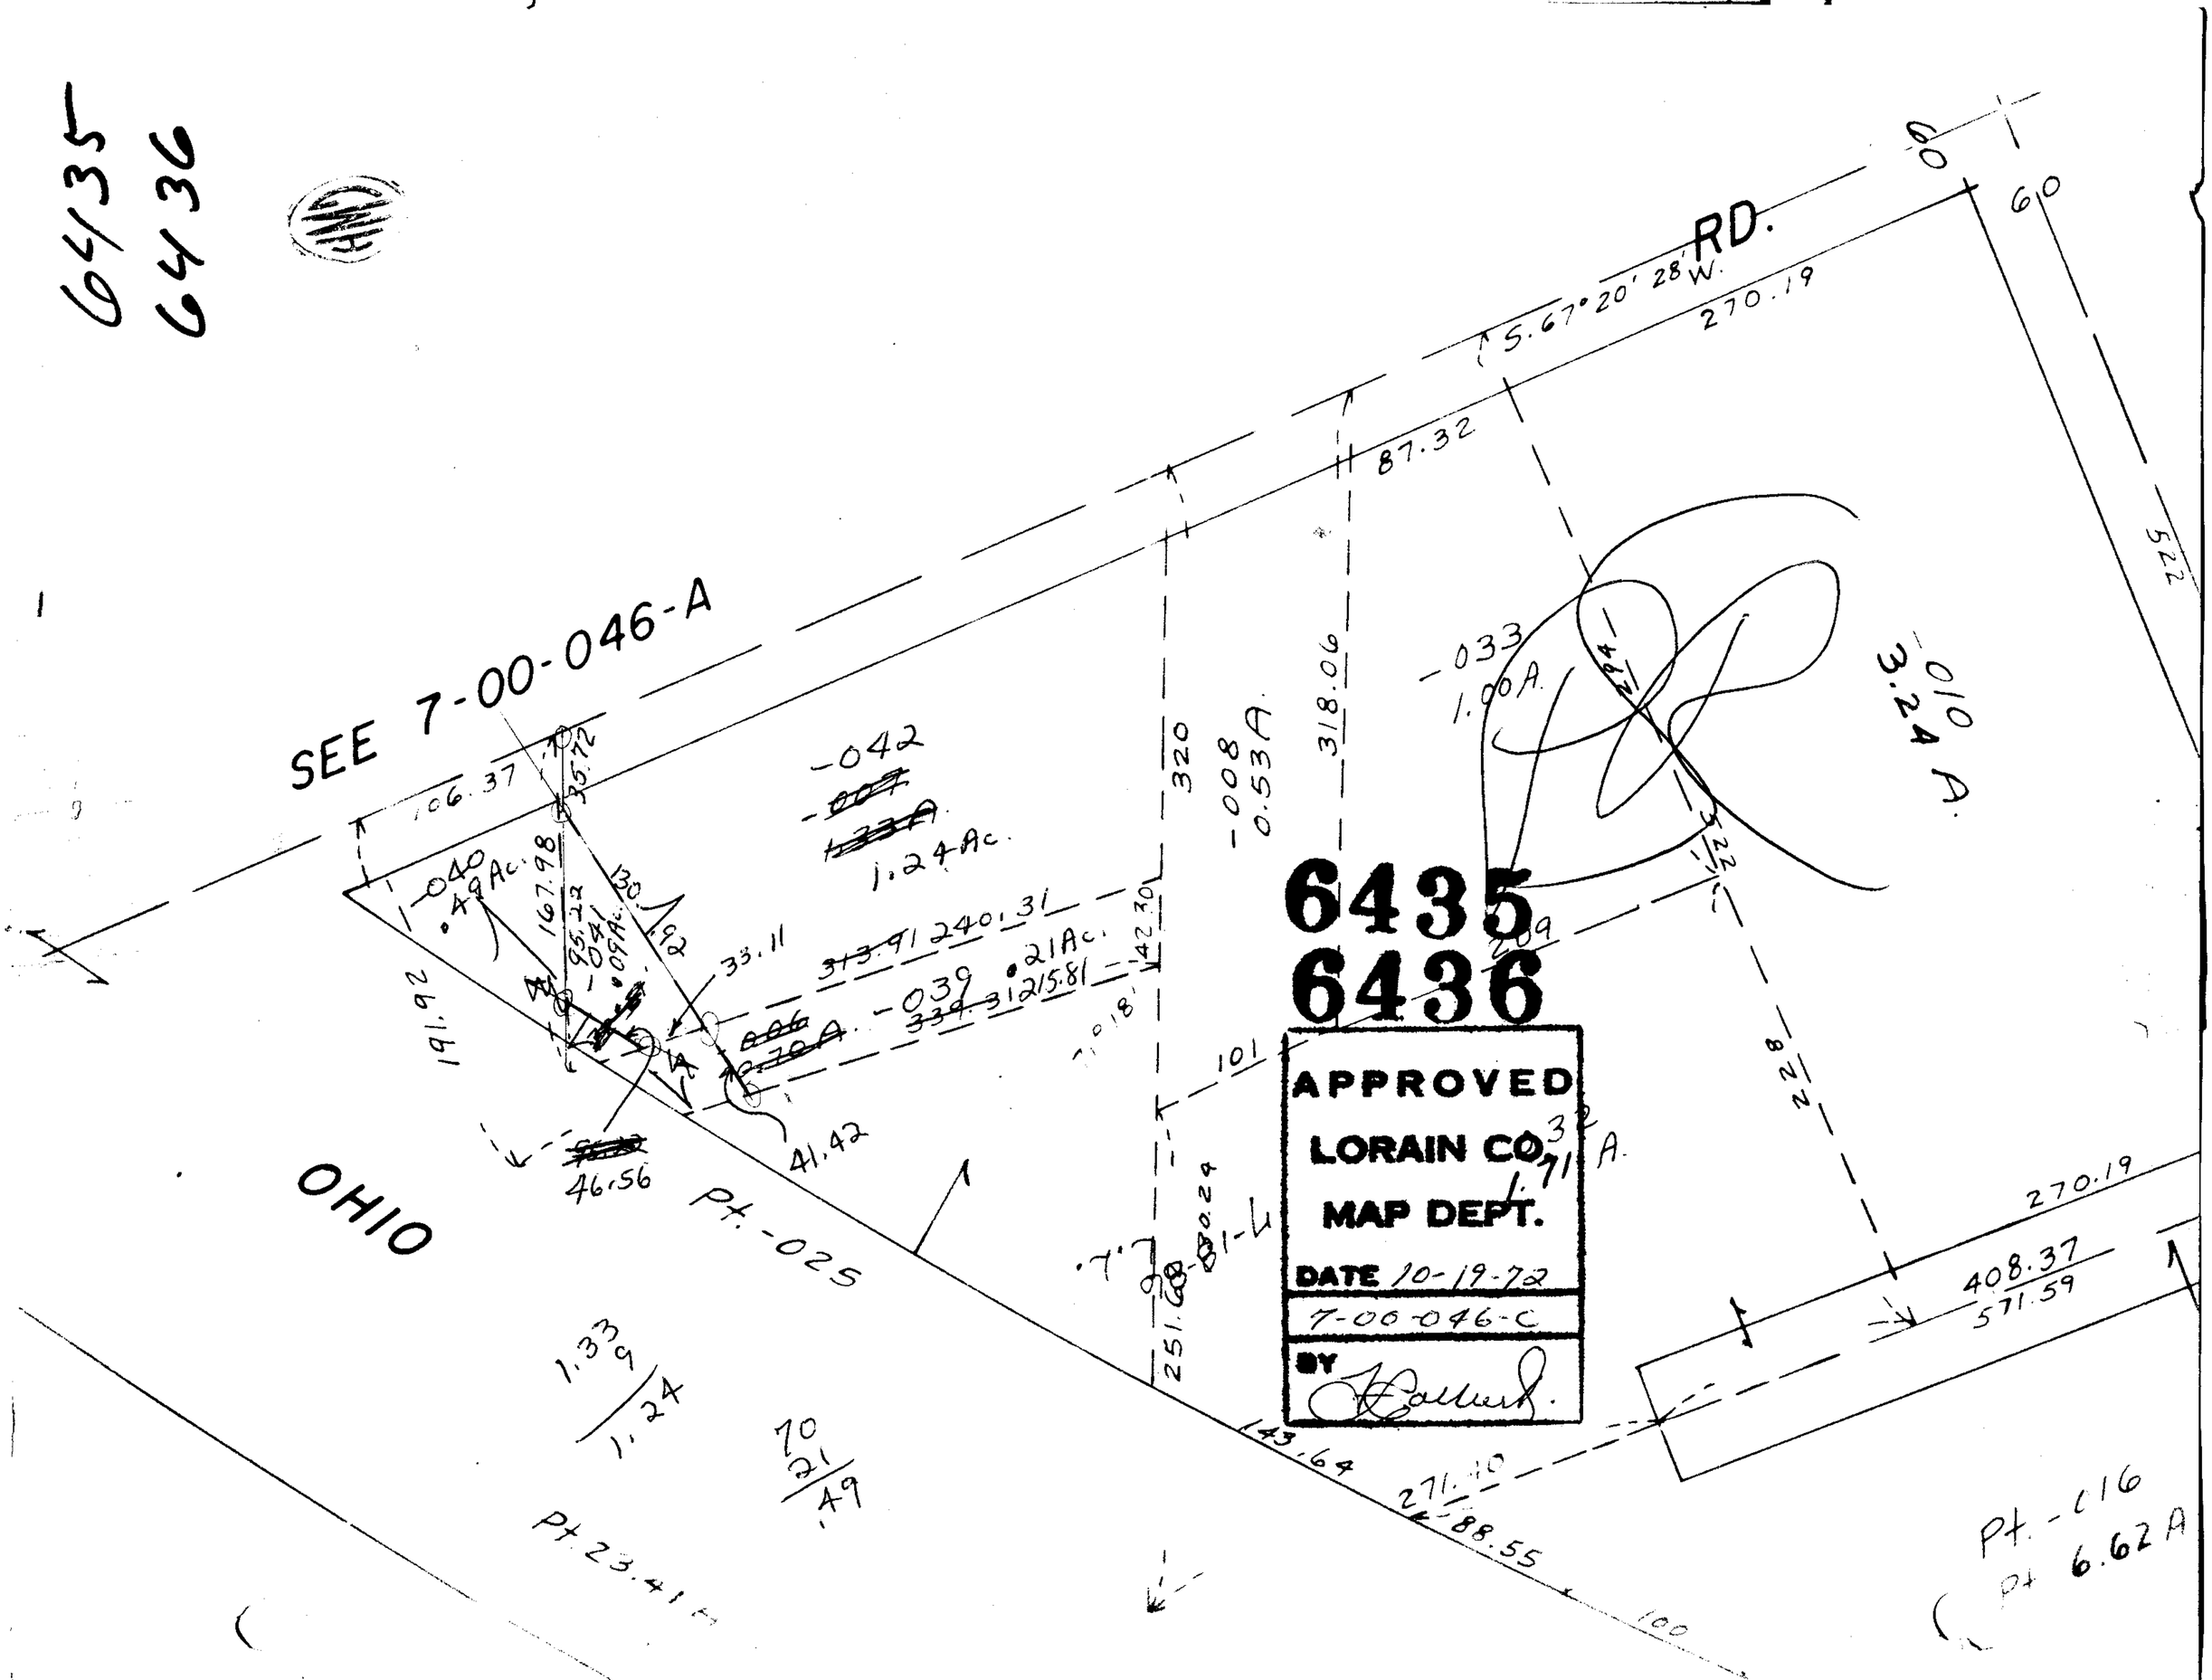
6435
6436
APPROVED
LORAIN CO.
MAP DEPT.
DATE 10-19-72
7-00-046-C
BY
SEE 7-00-046-A
RD.
OHIO
S.67°20'28"W.
270.19
87.32
318.06
320
-008
0.53A.
-033
1.00A.
-010
3.24 A.
-042
1.24Ac.
-040
.49Ac.
167.98
35.72
106.37
130.92
33.11
240.31
.21Ac.
215.81
-039
41.42
46.56
191.92
Pt.-025
1.33
9
1.24
70
21
.49
Pt 23.41
143.64
271.40
88.55
100
270.19
408.37
571.59
Pt.-016
Pt 6.62 A
101
228
209
522
60
60