6446
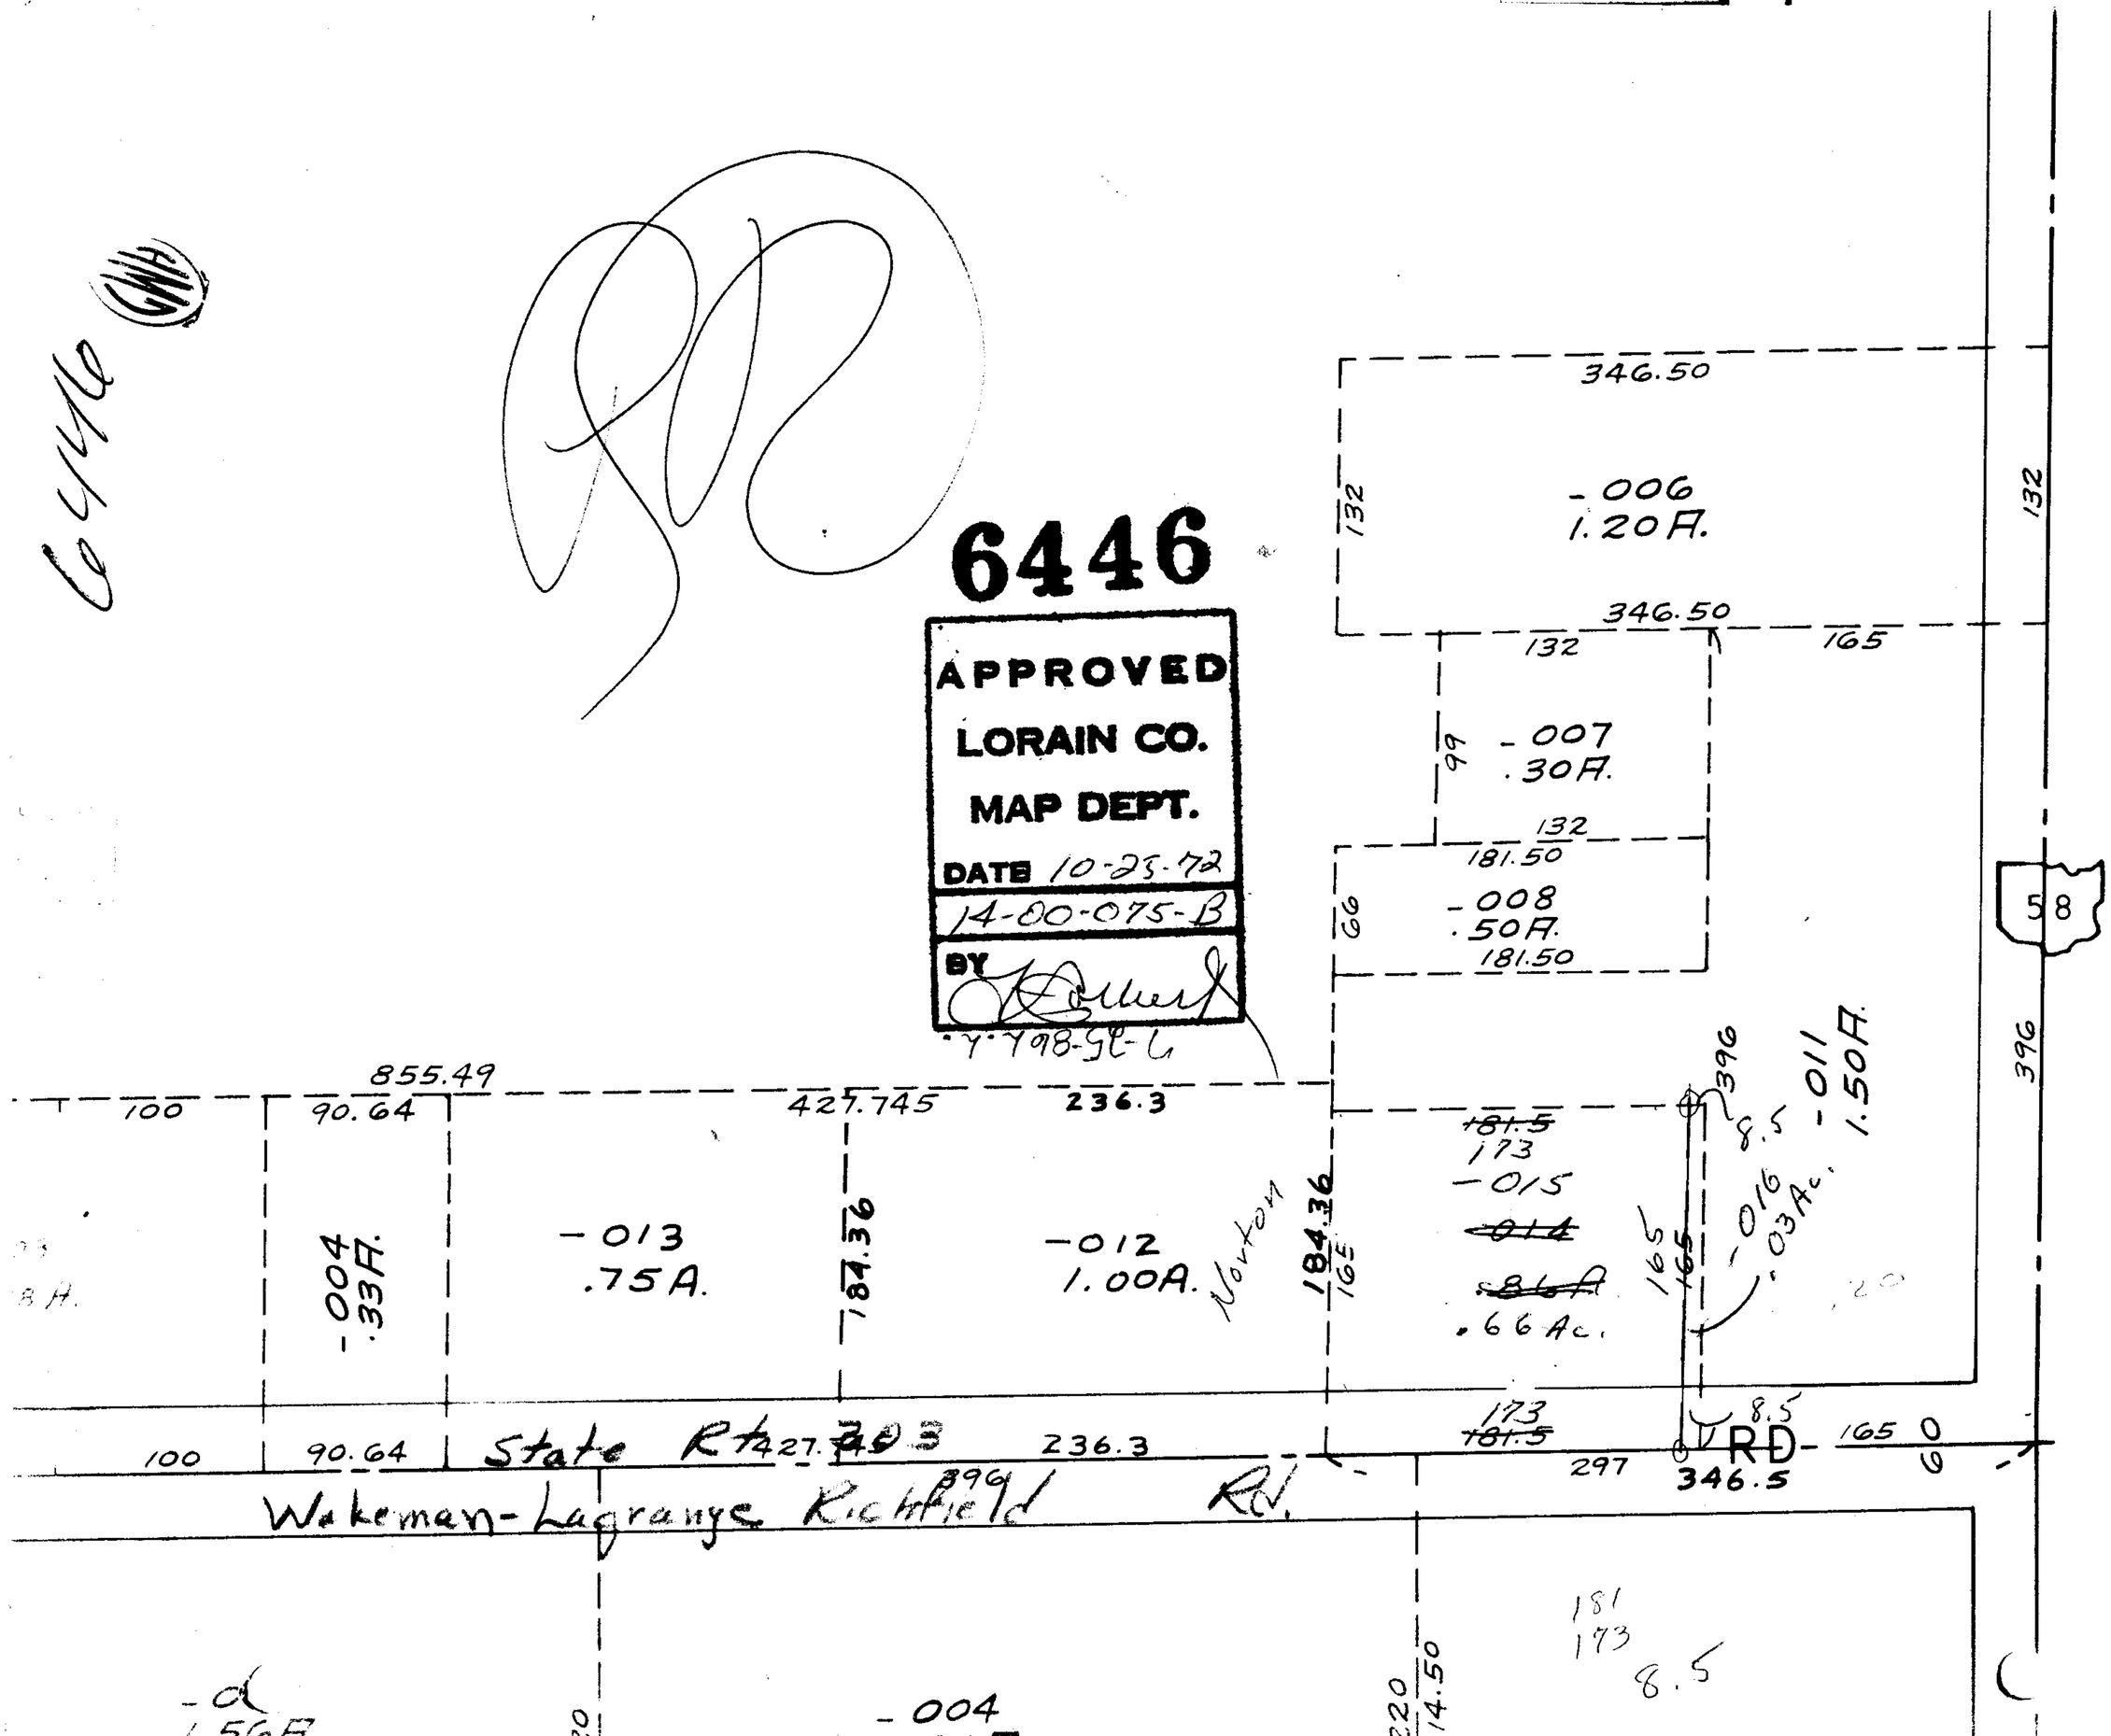
APPROVED
LORAIN CO.
MAP DEPT.
DATE 10-25-72
14-00-075-B
BY [signature]
Y-Y98-SE-L