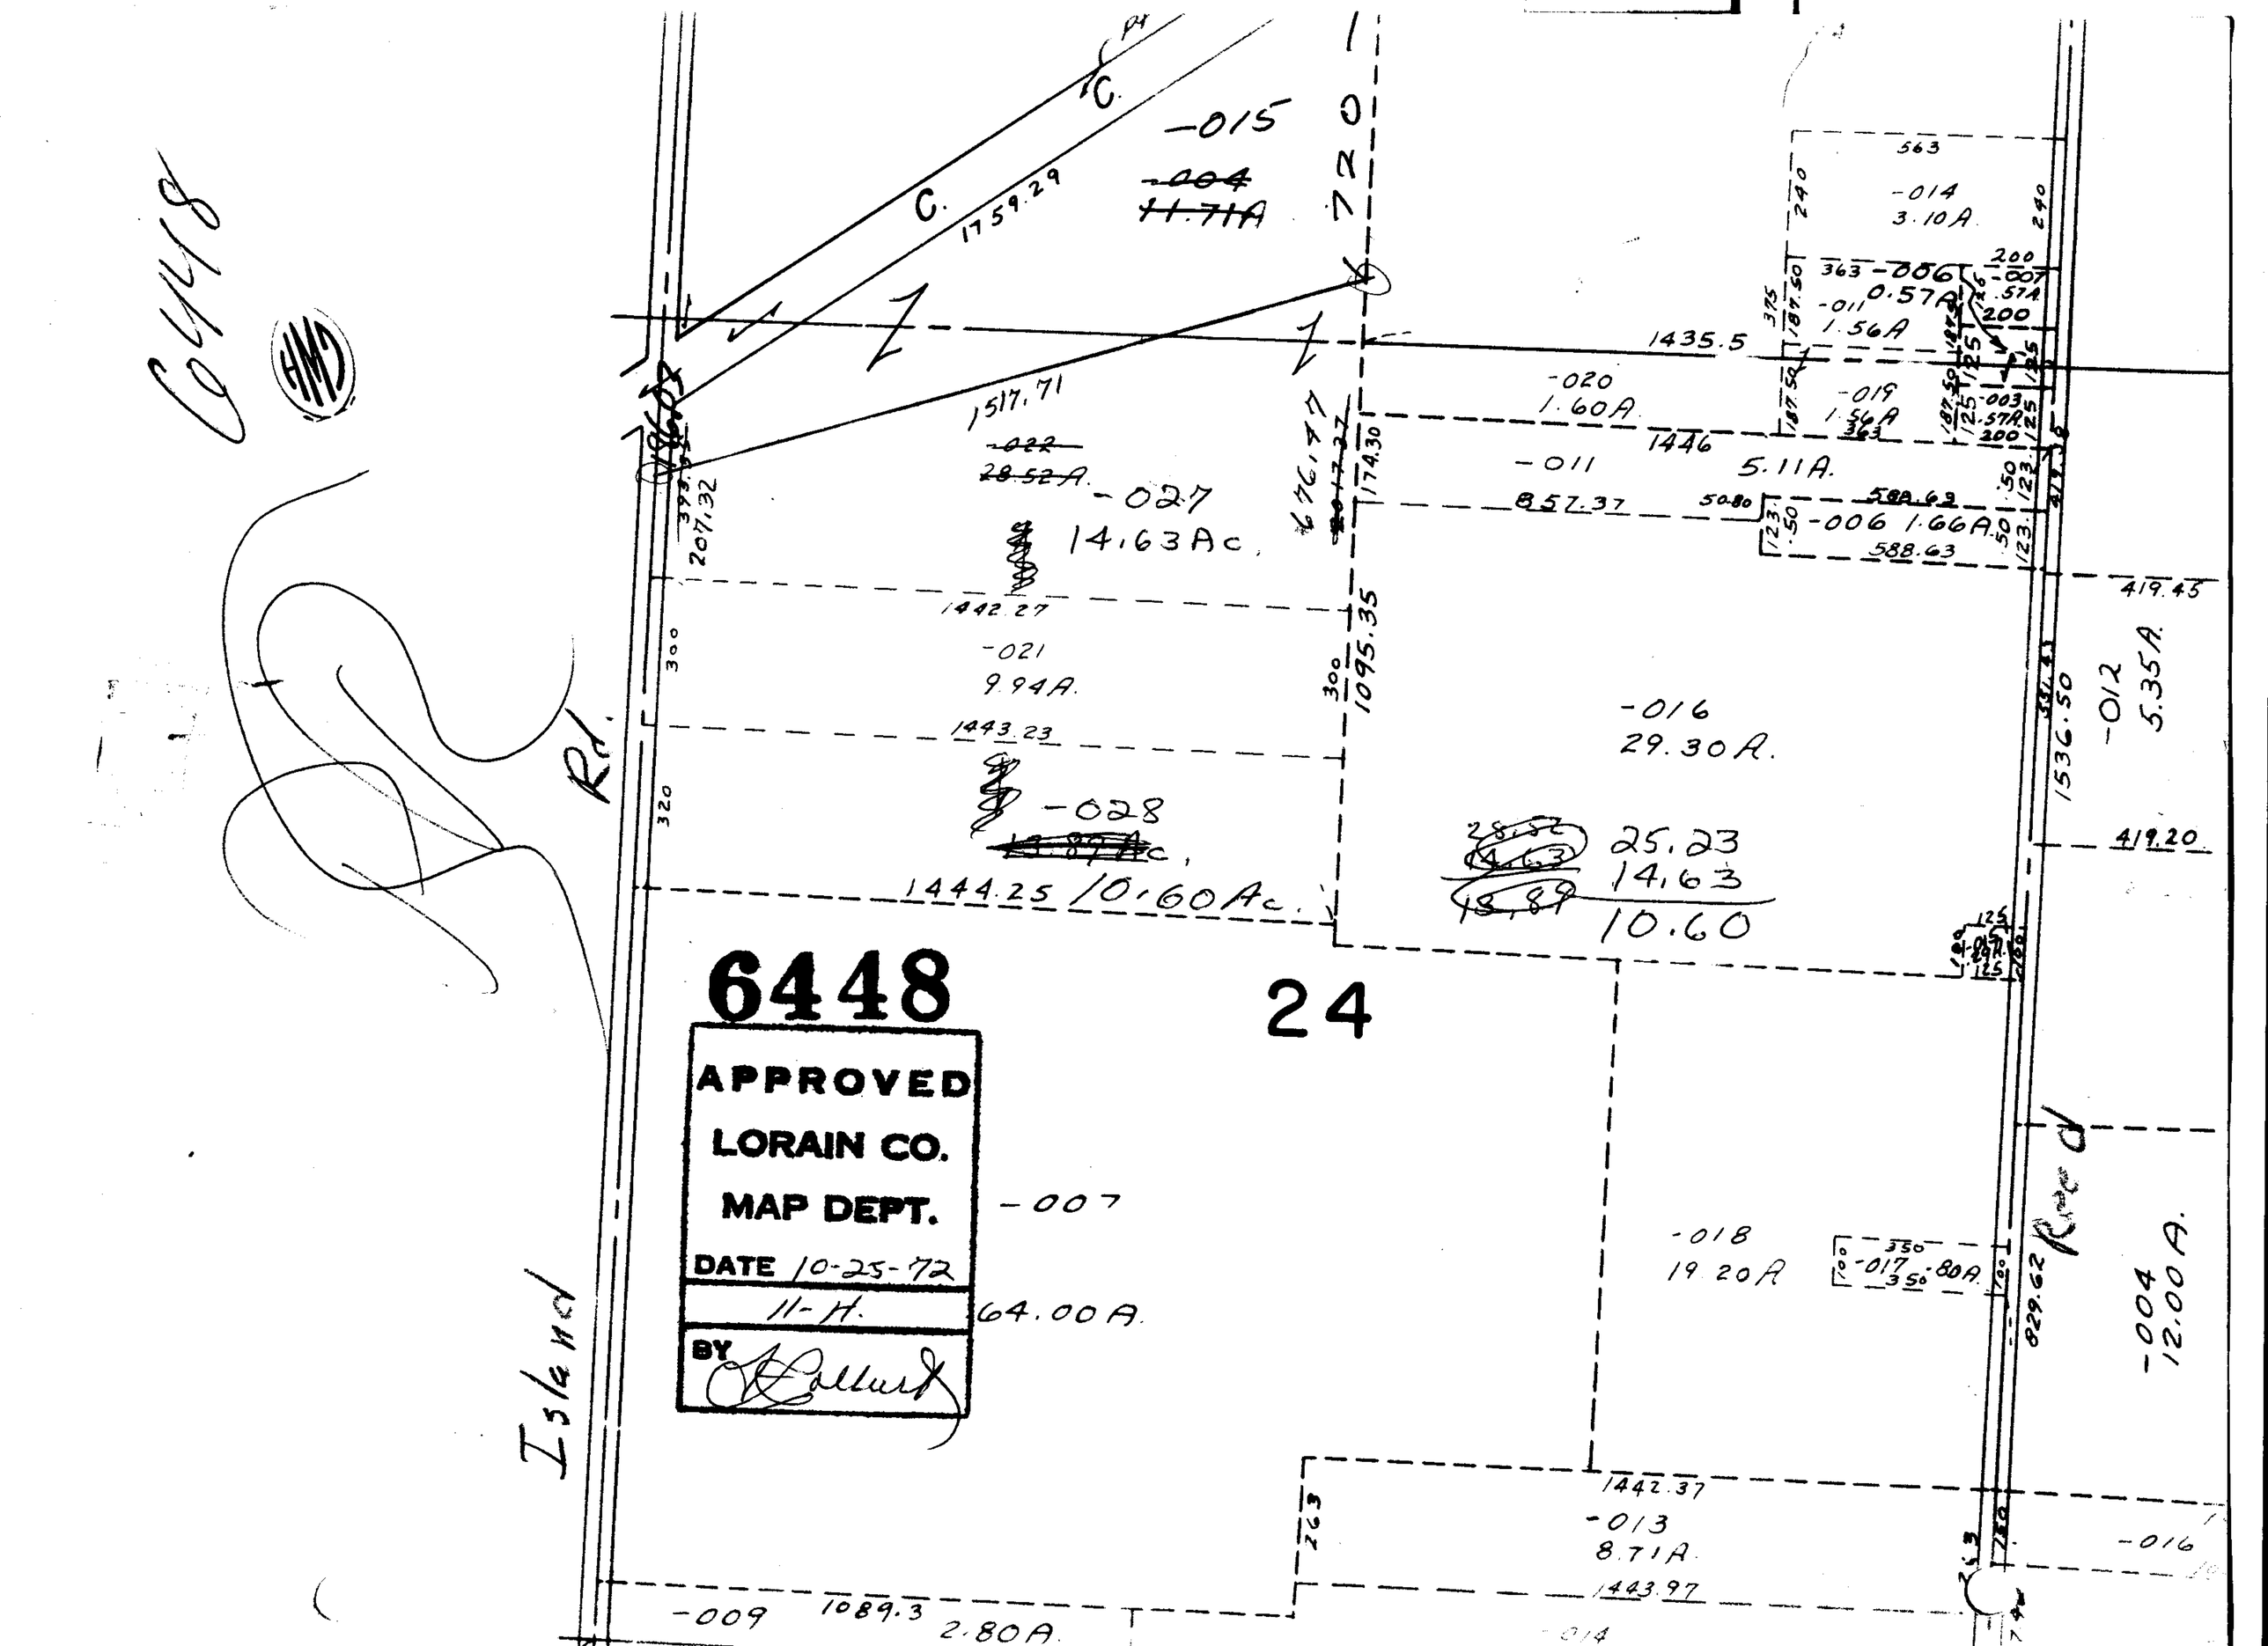
6448
APPROVED
LORAIN CO.
MAP DEPT.
DATE 10-25-72
11-H.
BY
24
Island Rd.
Road
-015
-004
11.71A
1759.29
720
1517.71
-022
28.52A
-027
14.63Ac.
1442.27
-021
9.94A.
1443.23
-028
1444.25 10.60Ac.
1095.35
-016
29.30A.
25.23
14.63
10.60
1435.5
-020
1.60A.
1446
-011
857.37
5.11A.
-006 1.66A.
588.63
-014
3.10A.
-006
0.57A
-011
1.56A
-019
1.56A
-003
.57A
-012
5.35A.
1536.50
419.45
419.20
-018
19.20A
-017
.80A
829.62
-004
12.00A.
-007
64.00A.
1442.37
-013
8.71A.
1443.97
-016
-009
1089.3
2.80A.
-014