


SEE 2-02-015-B

6454

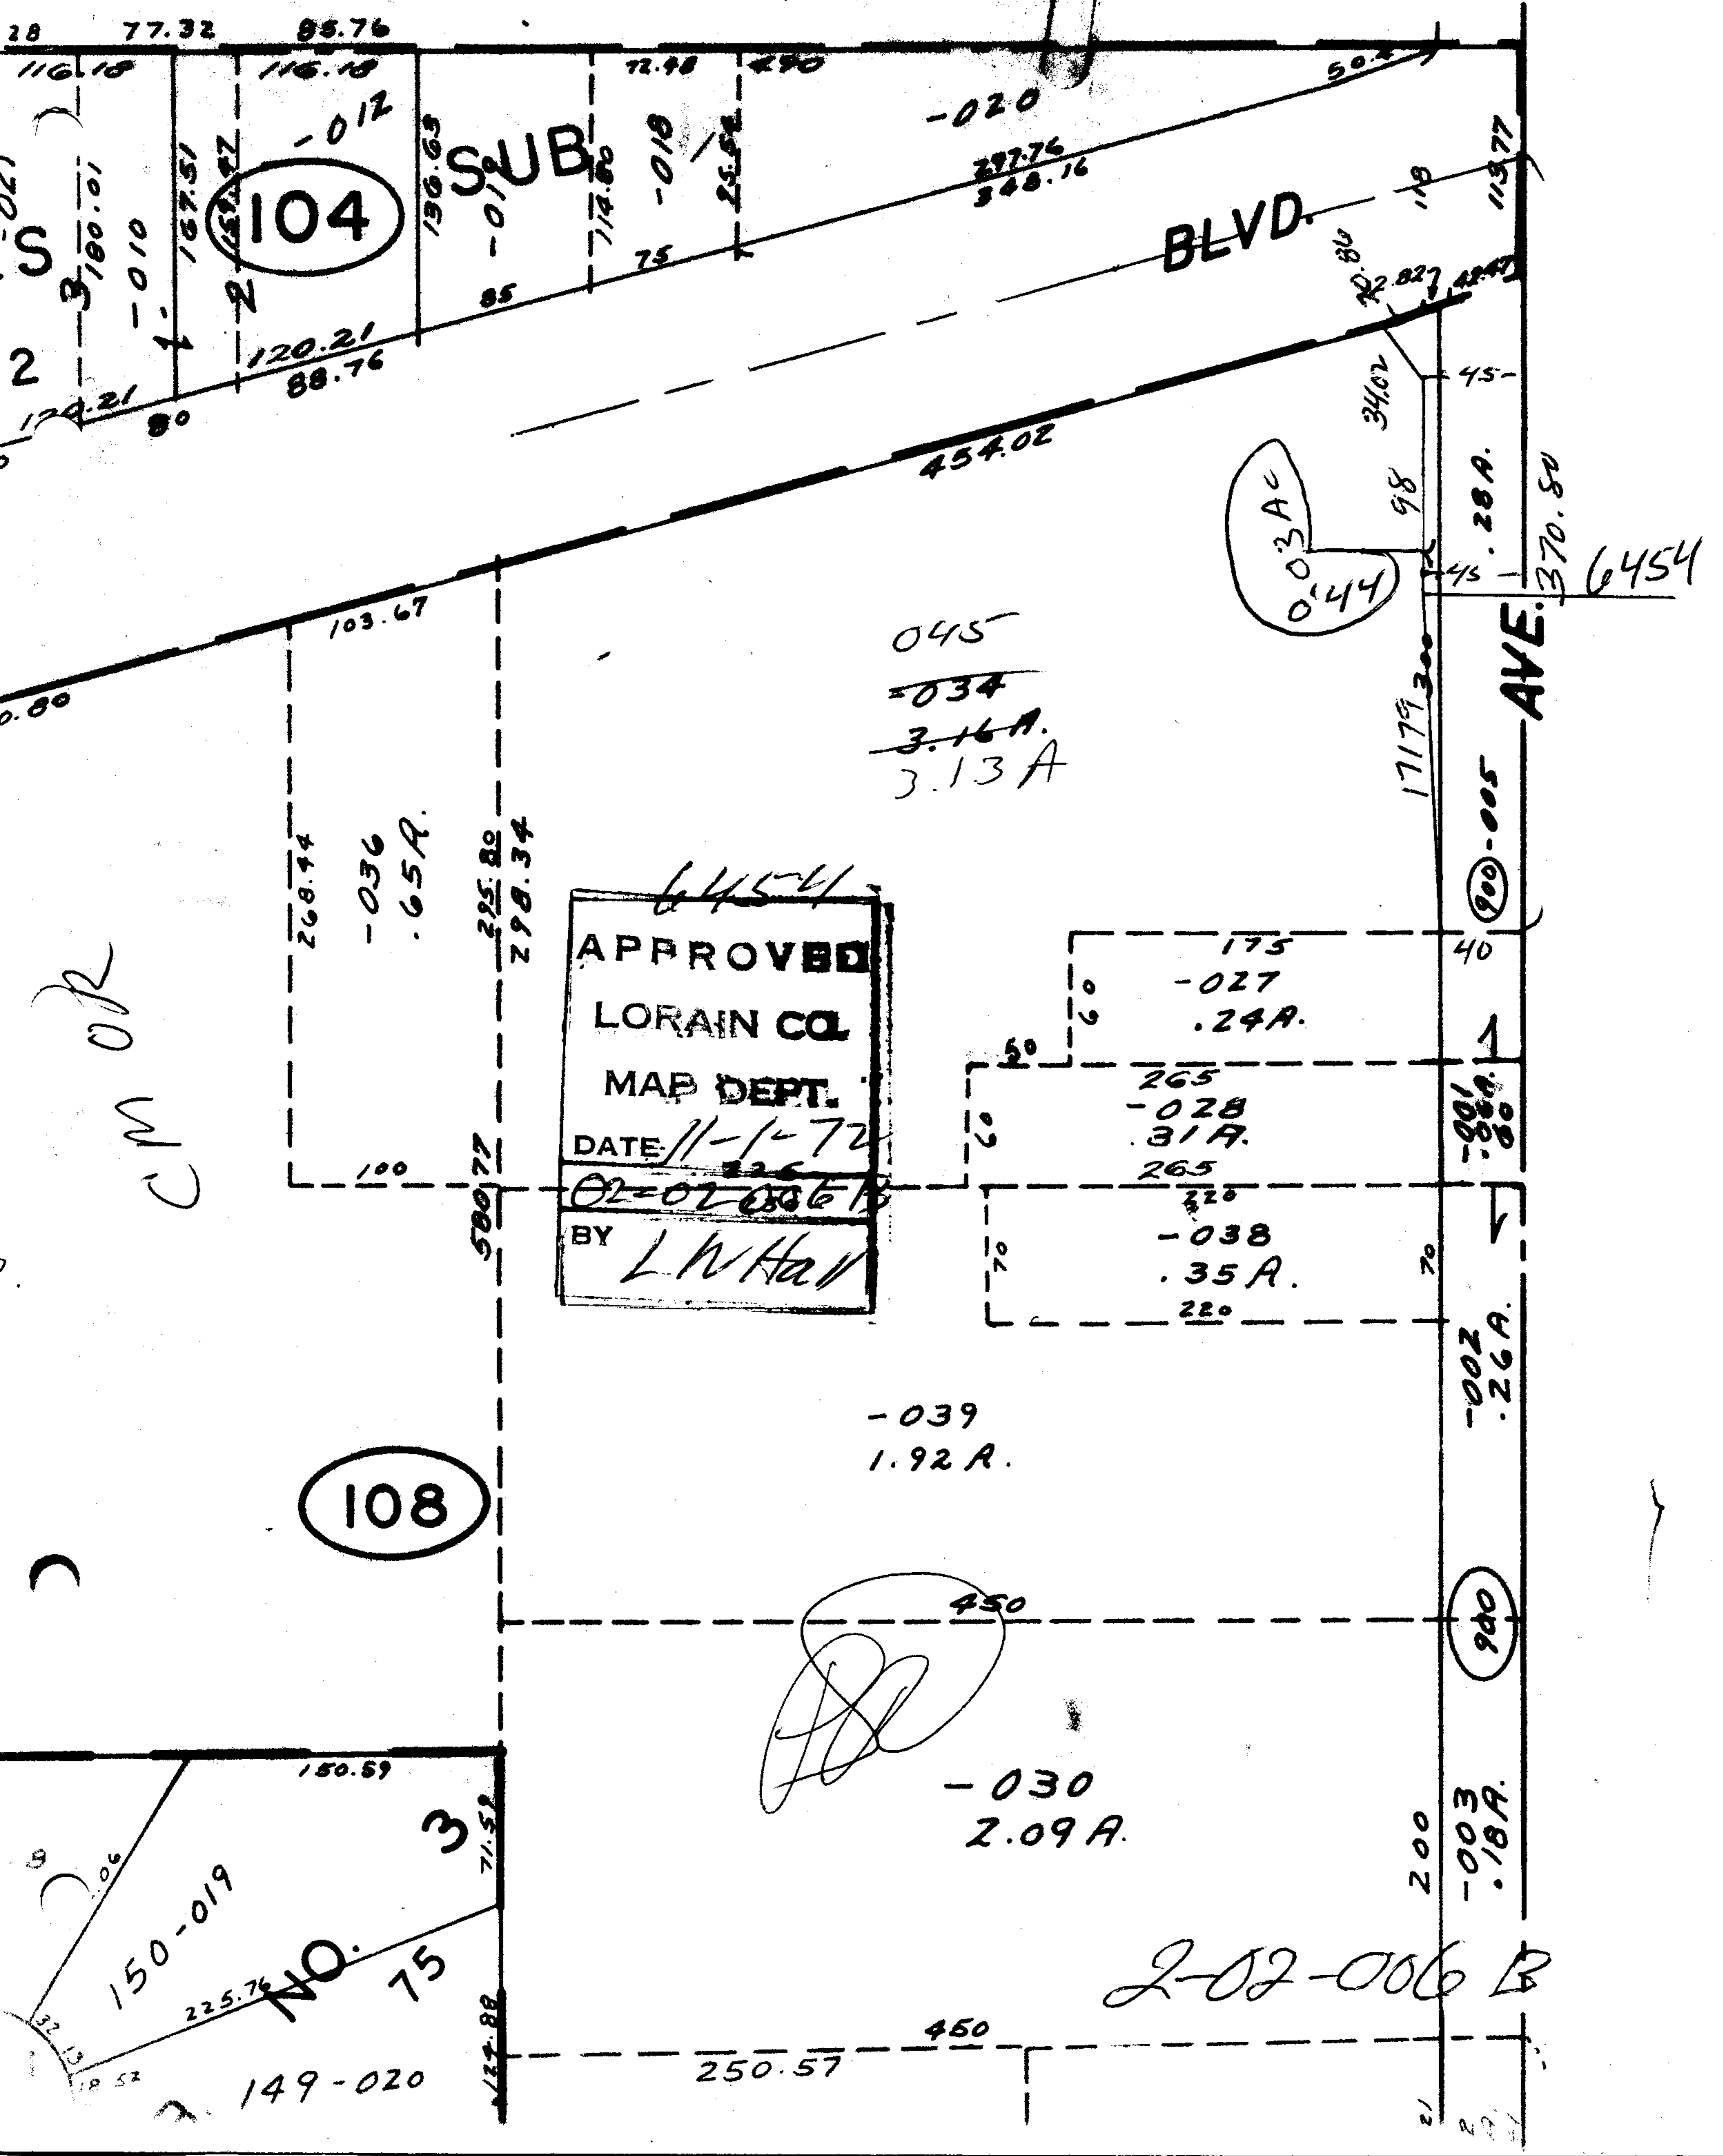

CM OR

6454
APPROVED
LORAIN CO.
MAP DEPT.
 DATE 11-1-72
 BY LWH

108

03AC
044

[Large scribble]

2-02-006 B

940

AVE.

BLVD.

6454