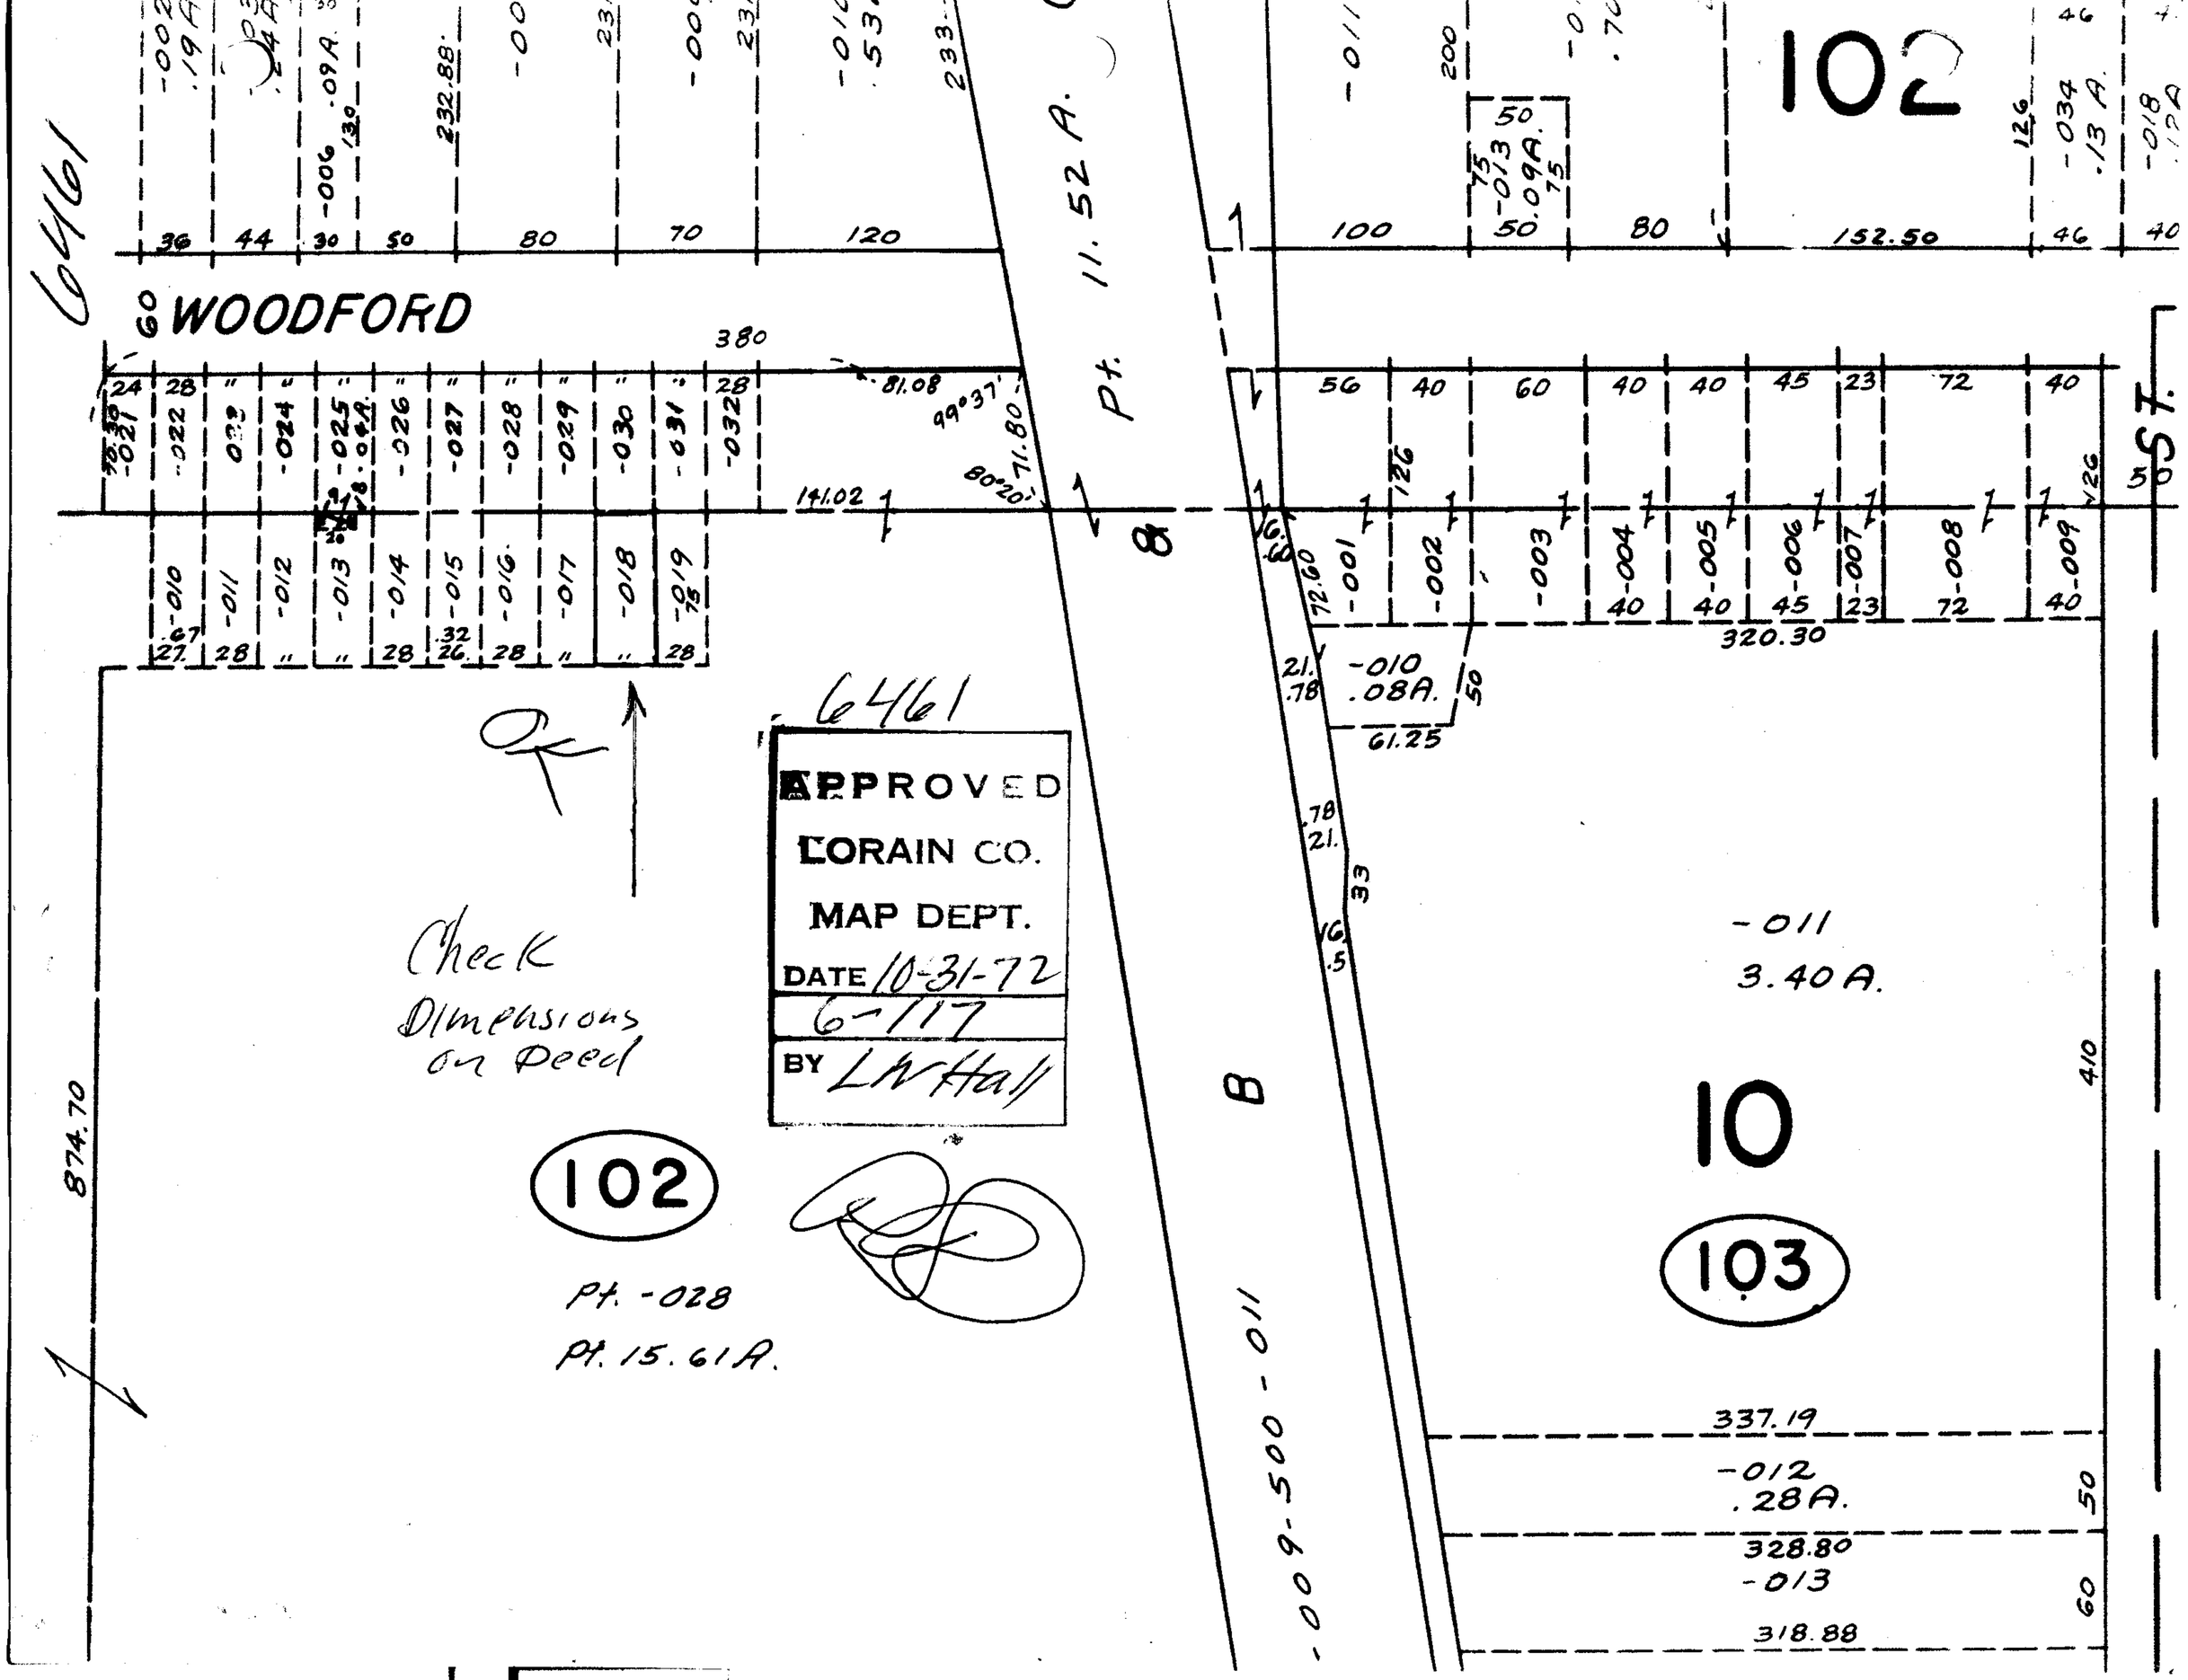

6461
WOODFORD
102
Pt. 11.52 A.
ST.
-011
3.40 A.
10
103
-012
.28 A.
-013
-009-500-011
Check
Dimensions
on Deed
102
Pt. -028
Pt. 15.61 A.
6461
APPROVED
LORAIN CO.
MAP DEPT.
DATE 10-31-72
6-117
BY LW Hall
874.70
320.30
61.25
337.19
328.80
318.88