6504

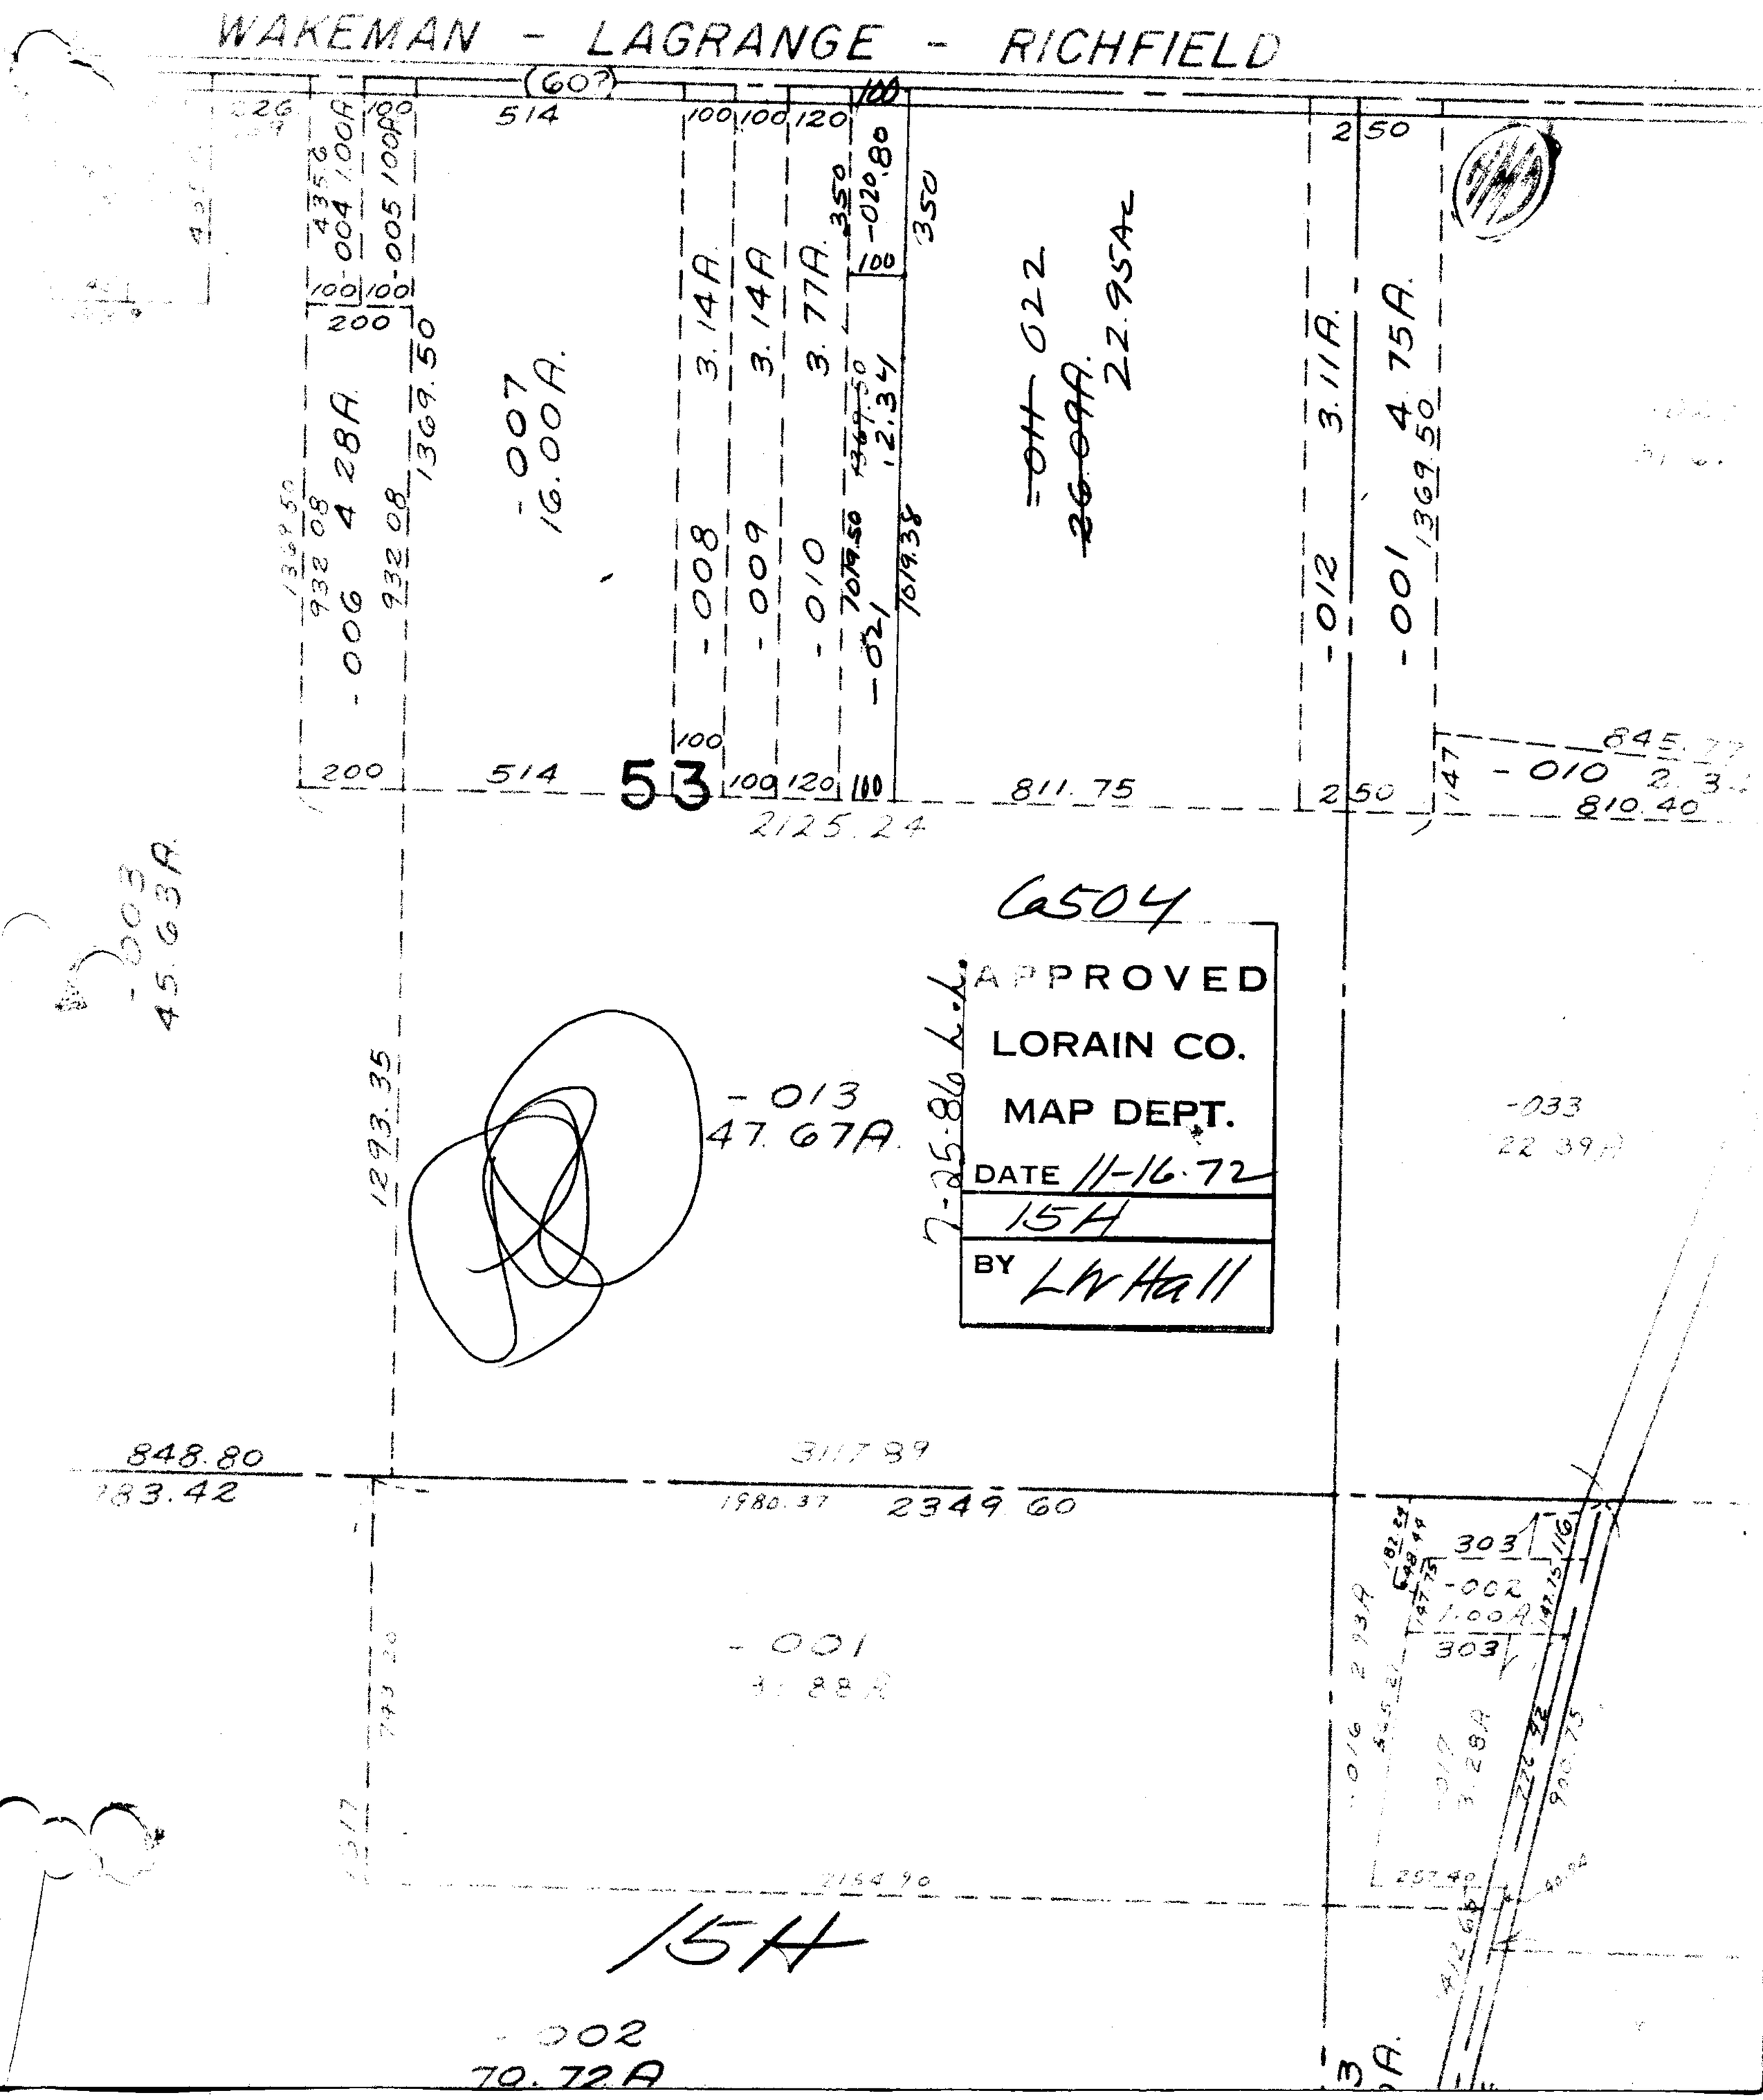
WAKEMAN - LAGRANGE - RICHFIELD
(60?)
514
100
100
120
100
350
-020 .80
350
2 50
-004 1.00A
-005 1.00A
100
100
200
4.28A
1369.50
932.08
-006
-007
16.00A.
3.14A
3.14A
3.77A
-008
-009
-010
-021
7019.50
7019.38
12.34
-011
26.09A.
22.95Ac
3.11A.
4.75A.
-012
-001
1369.50
845.72
-010
810.40
147
200
514
53
100
109
120
100
811.75
2 50
2125.24
6504
APPROVED
LORAIN CO.
MAP DEPT.
DATE 11-16-72
15H
BY LWHall
7-25-86
-003
45.63A.
1293.35
-013
47.67A.
-033
22.39A
848.80
183.42
3117.89
1980.37
2349.60
303
-002
1.00A
303
-001
41.88A
2164.90
15H
-002
70.72A
3A.