


GORE STRIP LOTS 13 & 14

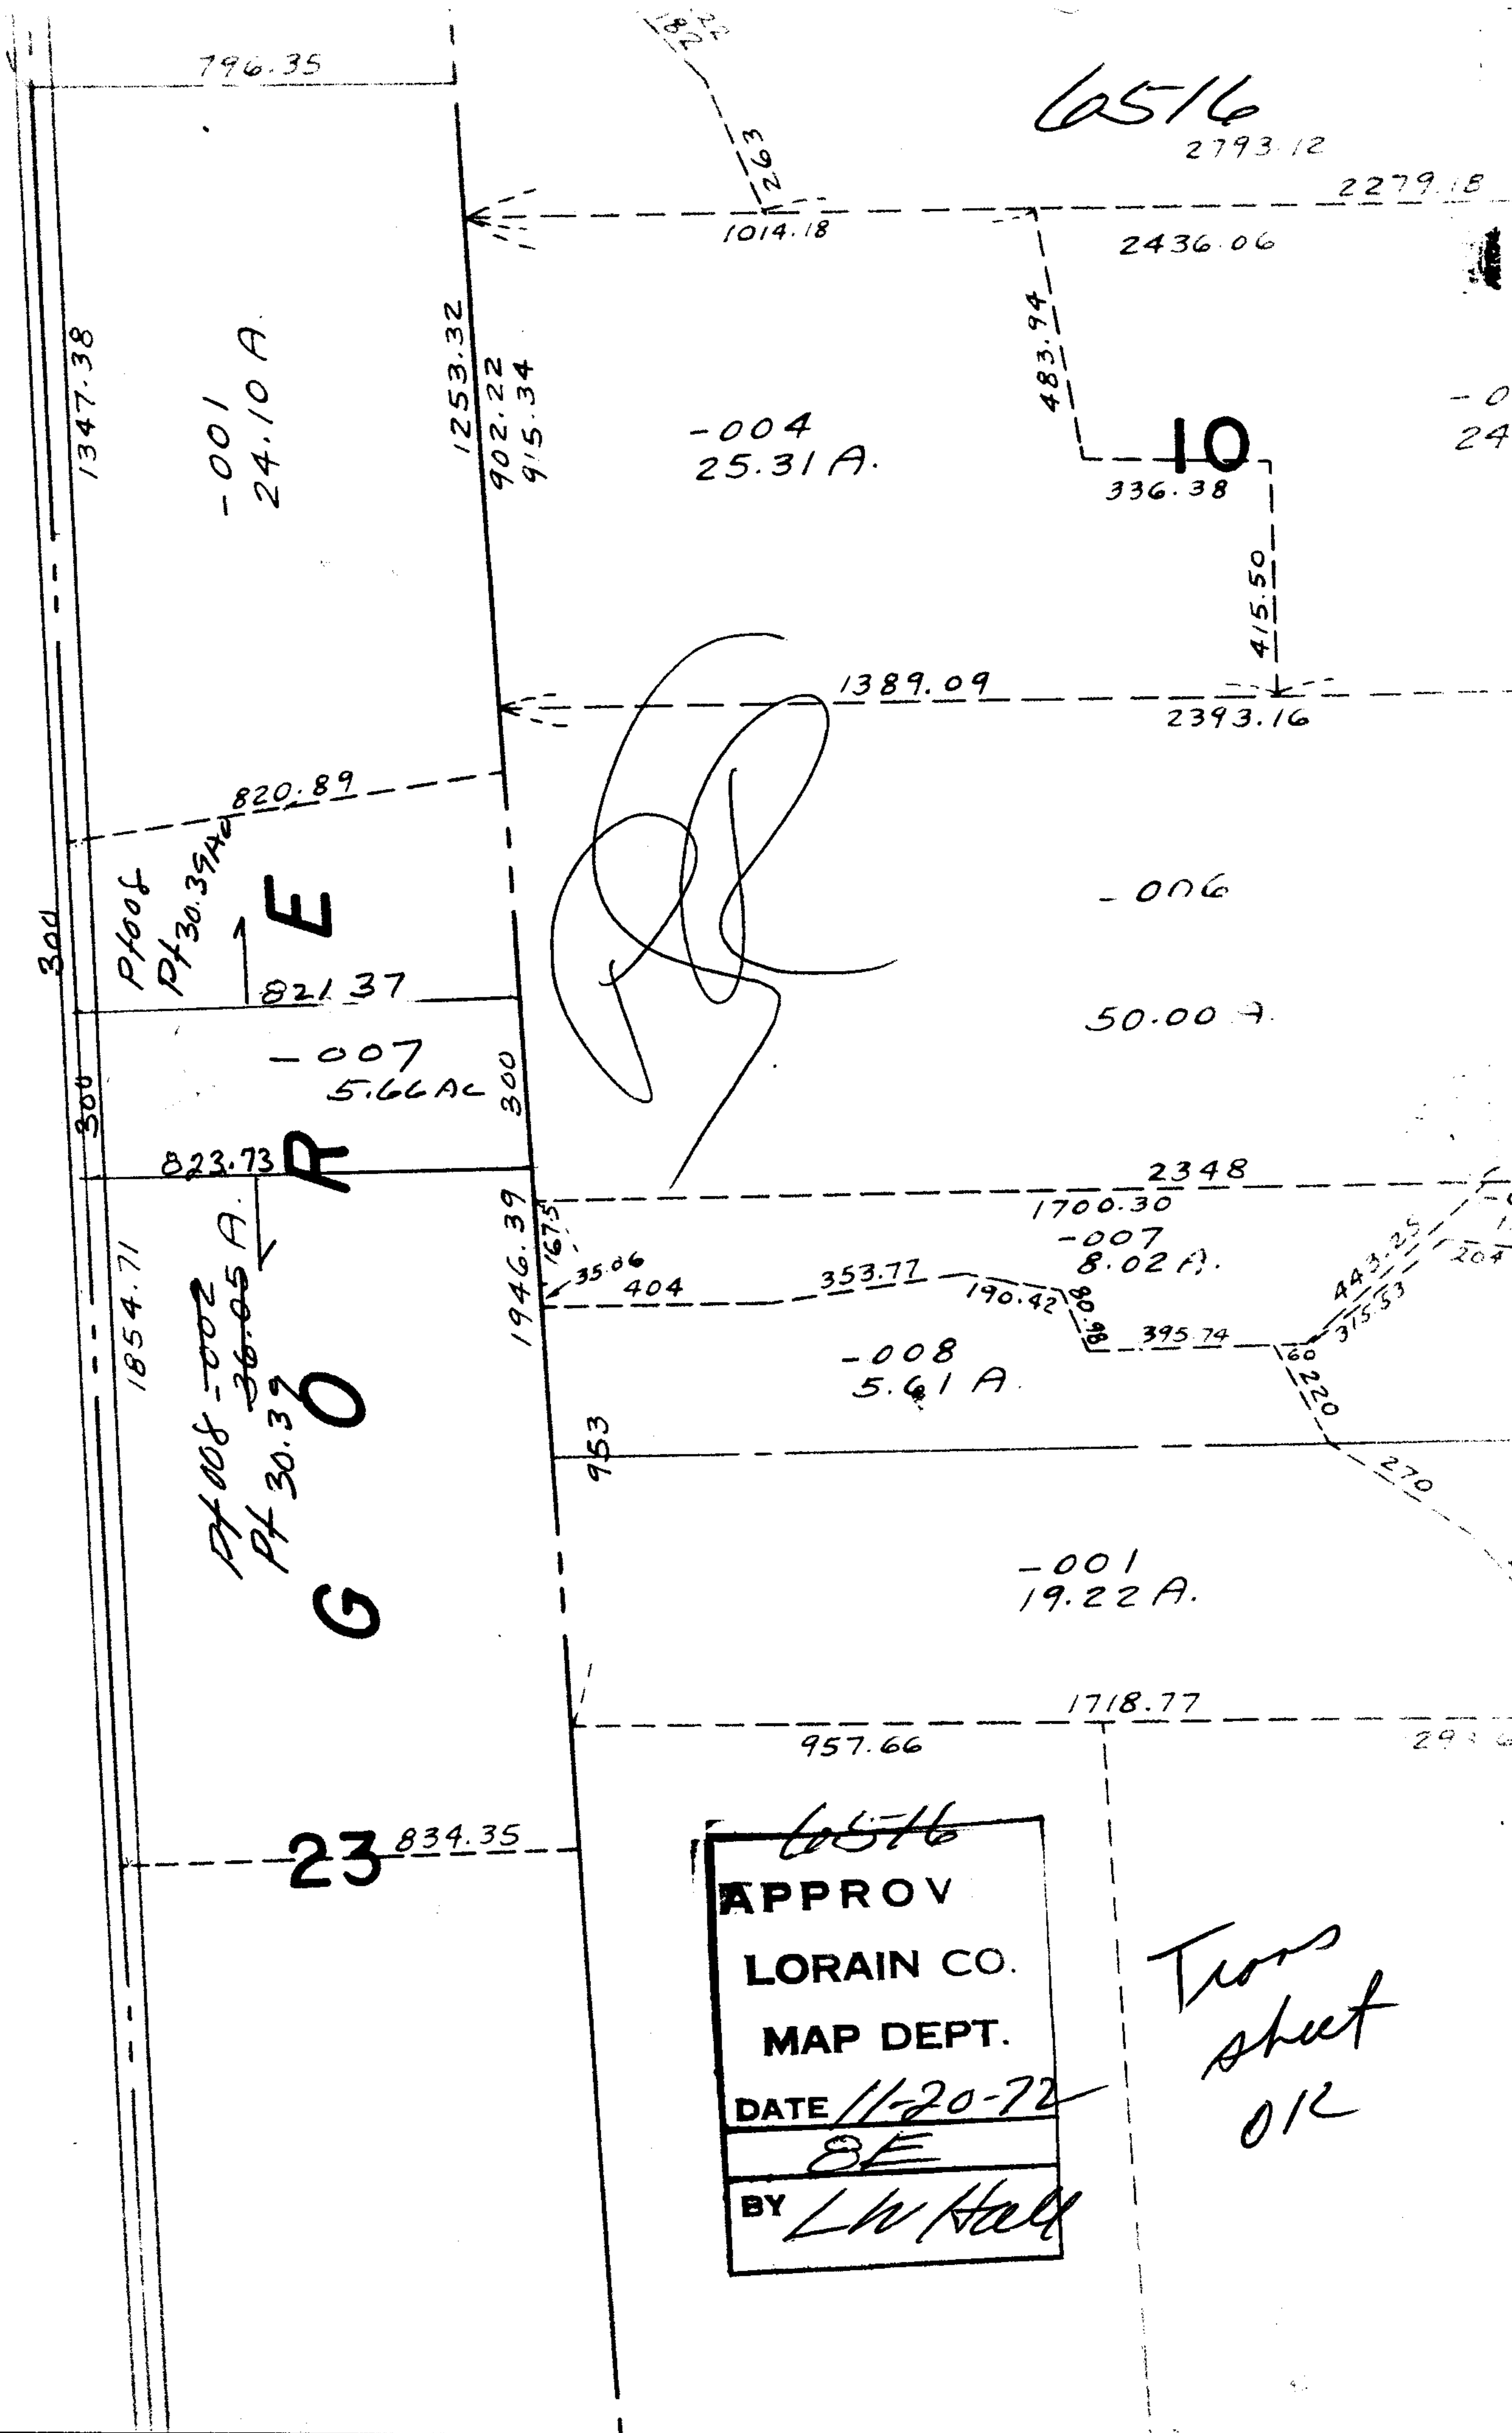

6516
2793.12

-001
24.10 A.

-004
25.31 A.

10
336.38

Proof
Pt 30.39 AC

E

-007
5.66 AC

R

Proof -002
36.05 A.
Pt 30.39

G
O

-008
5.61 A.

-001
19.22 A.

23 834.35

6516
APPROV
LORAIN CO.
MAP DEPT.
DATE 11-20-72
BE
BY *LW Hall*

*Trans
sheet
OK*