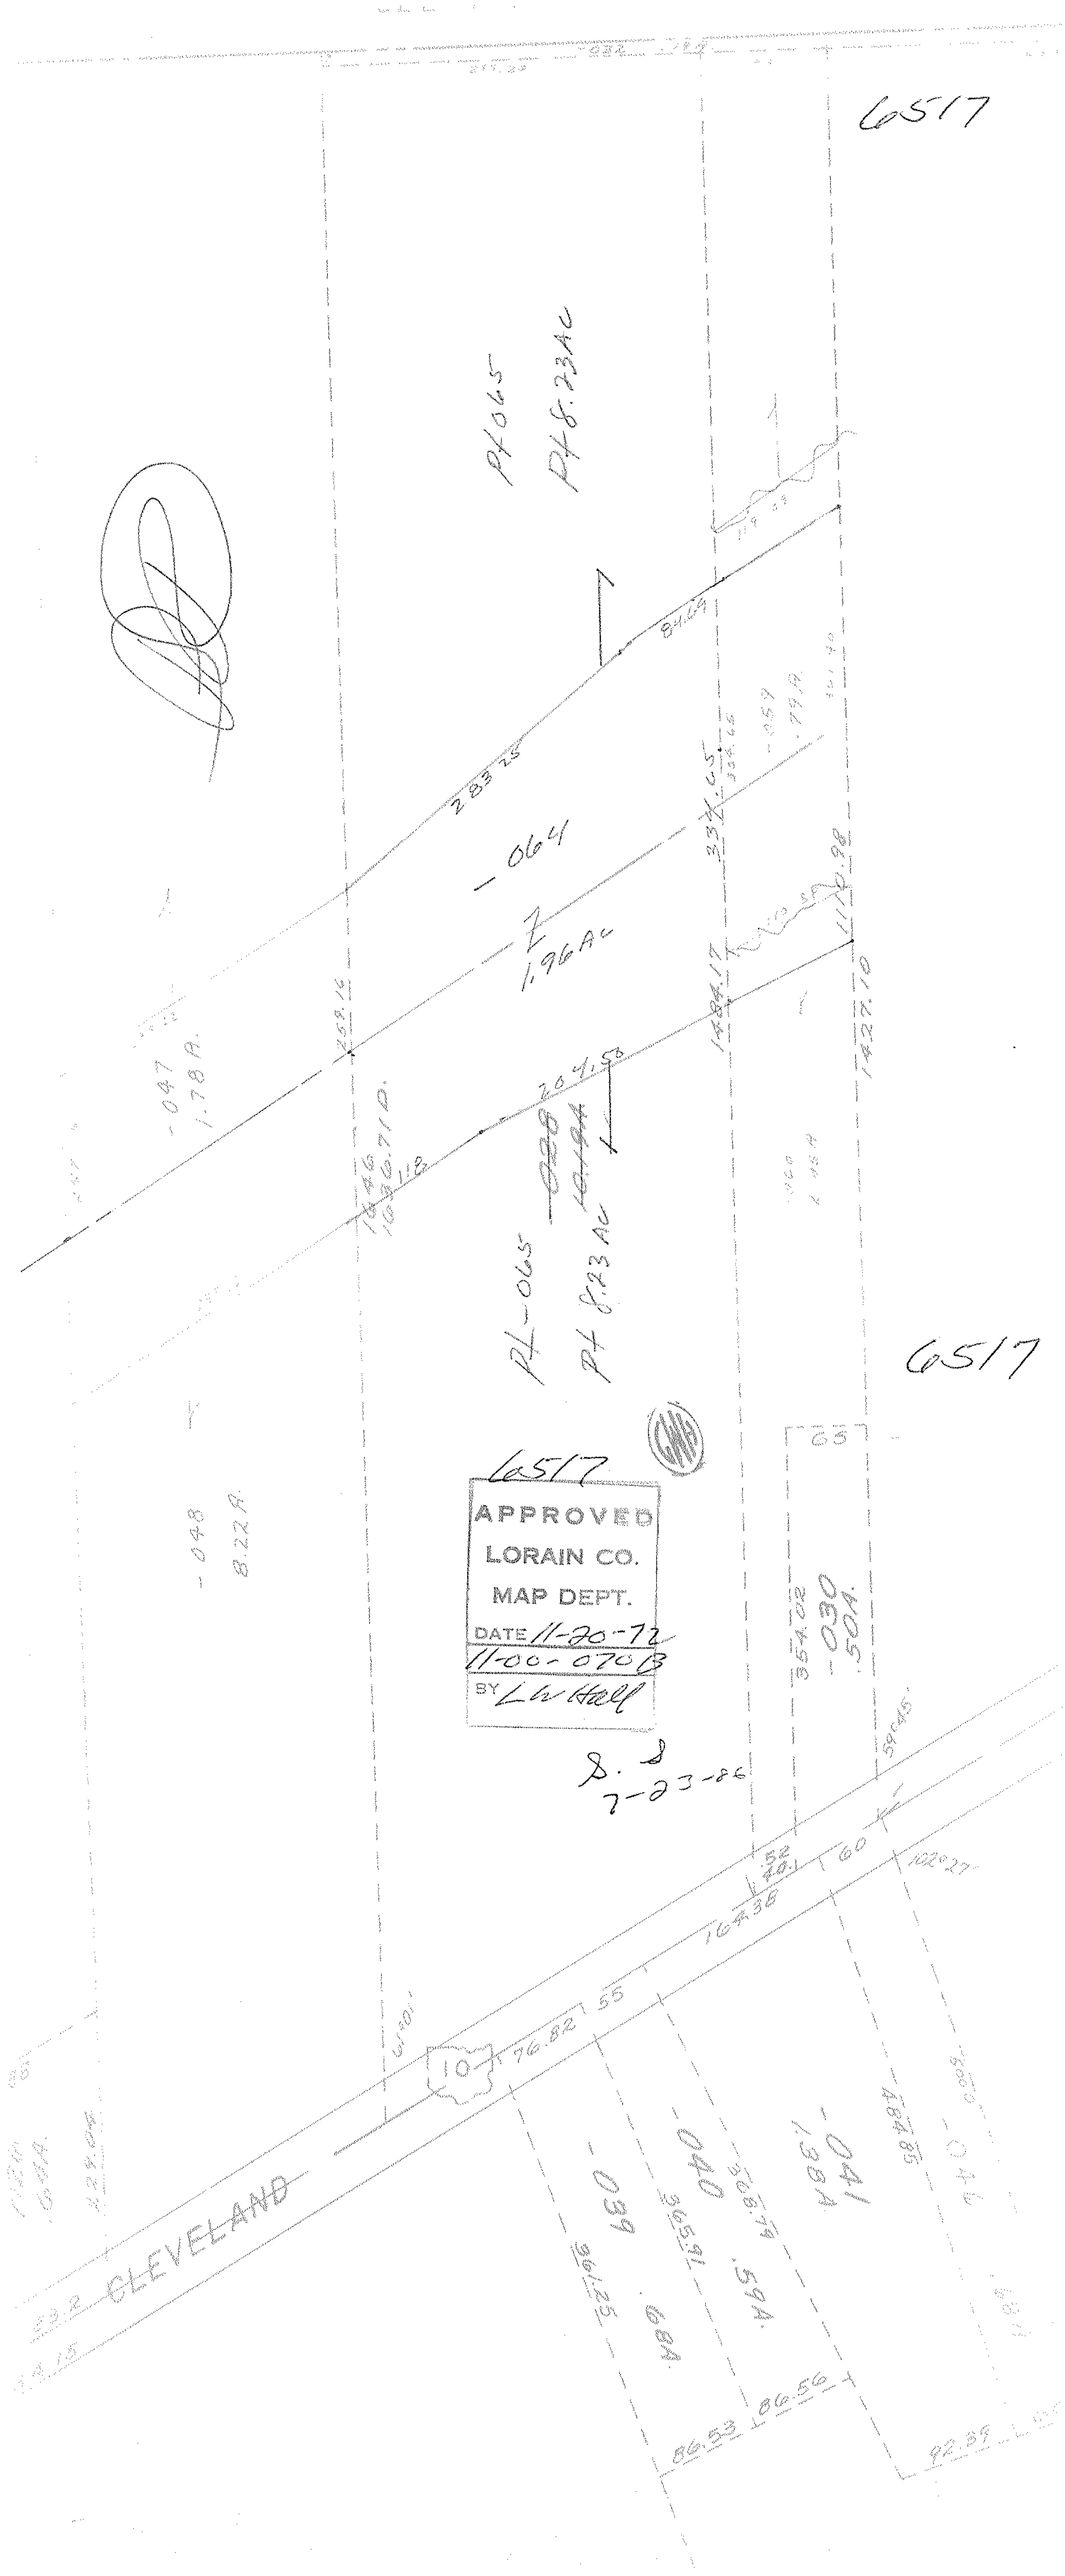
6517
Pt 065
Pt 8.23 Ac
283.25
84.69
-064
1.96 Ac
-047
1.78 A.
258.16
204.50
1484.17
1427.10
1110.98
Pt -065
Pt 8.23 Ac
6517
6517
APPROVED
LORAIN CO.
MAP DEPT.
DATE 11-20-72
11-00-070B
BY L W Hall
-048
8.22 A.
65
354.02
-030
.50A.
59°45'
52
40.1
60
102°27'
164.38
55
76.82
10
CLEVELAND
-039
.68A.
361.25
-040
.59A.
365.91
368.79
-041
1.38A
484.85
-046
86.53
86.56
92.39