


Pt. 06-24-088-5
Pt. 1.821
6518
TUSCARAWAS

YURON

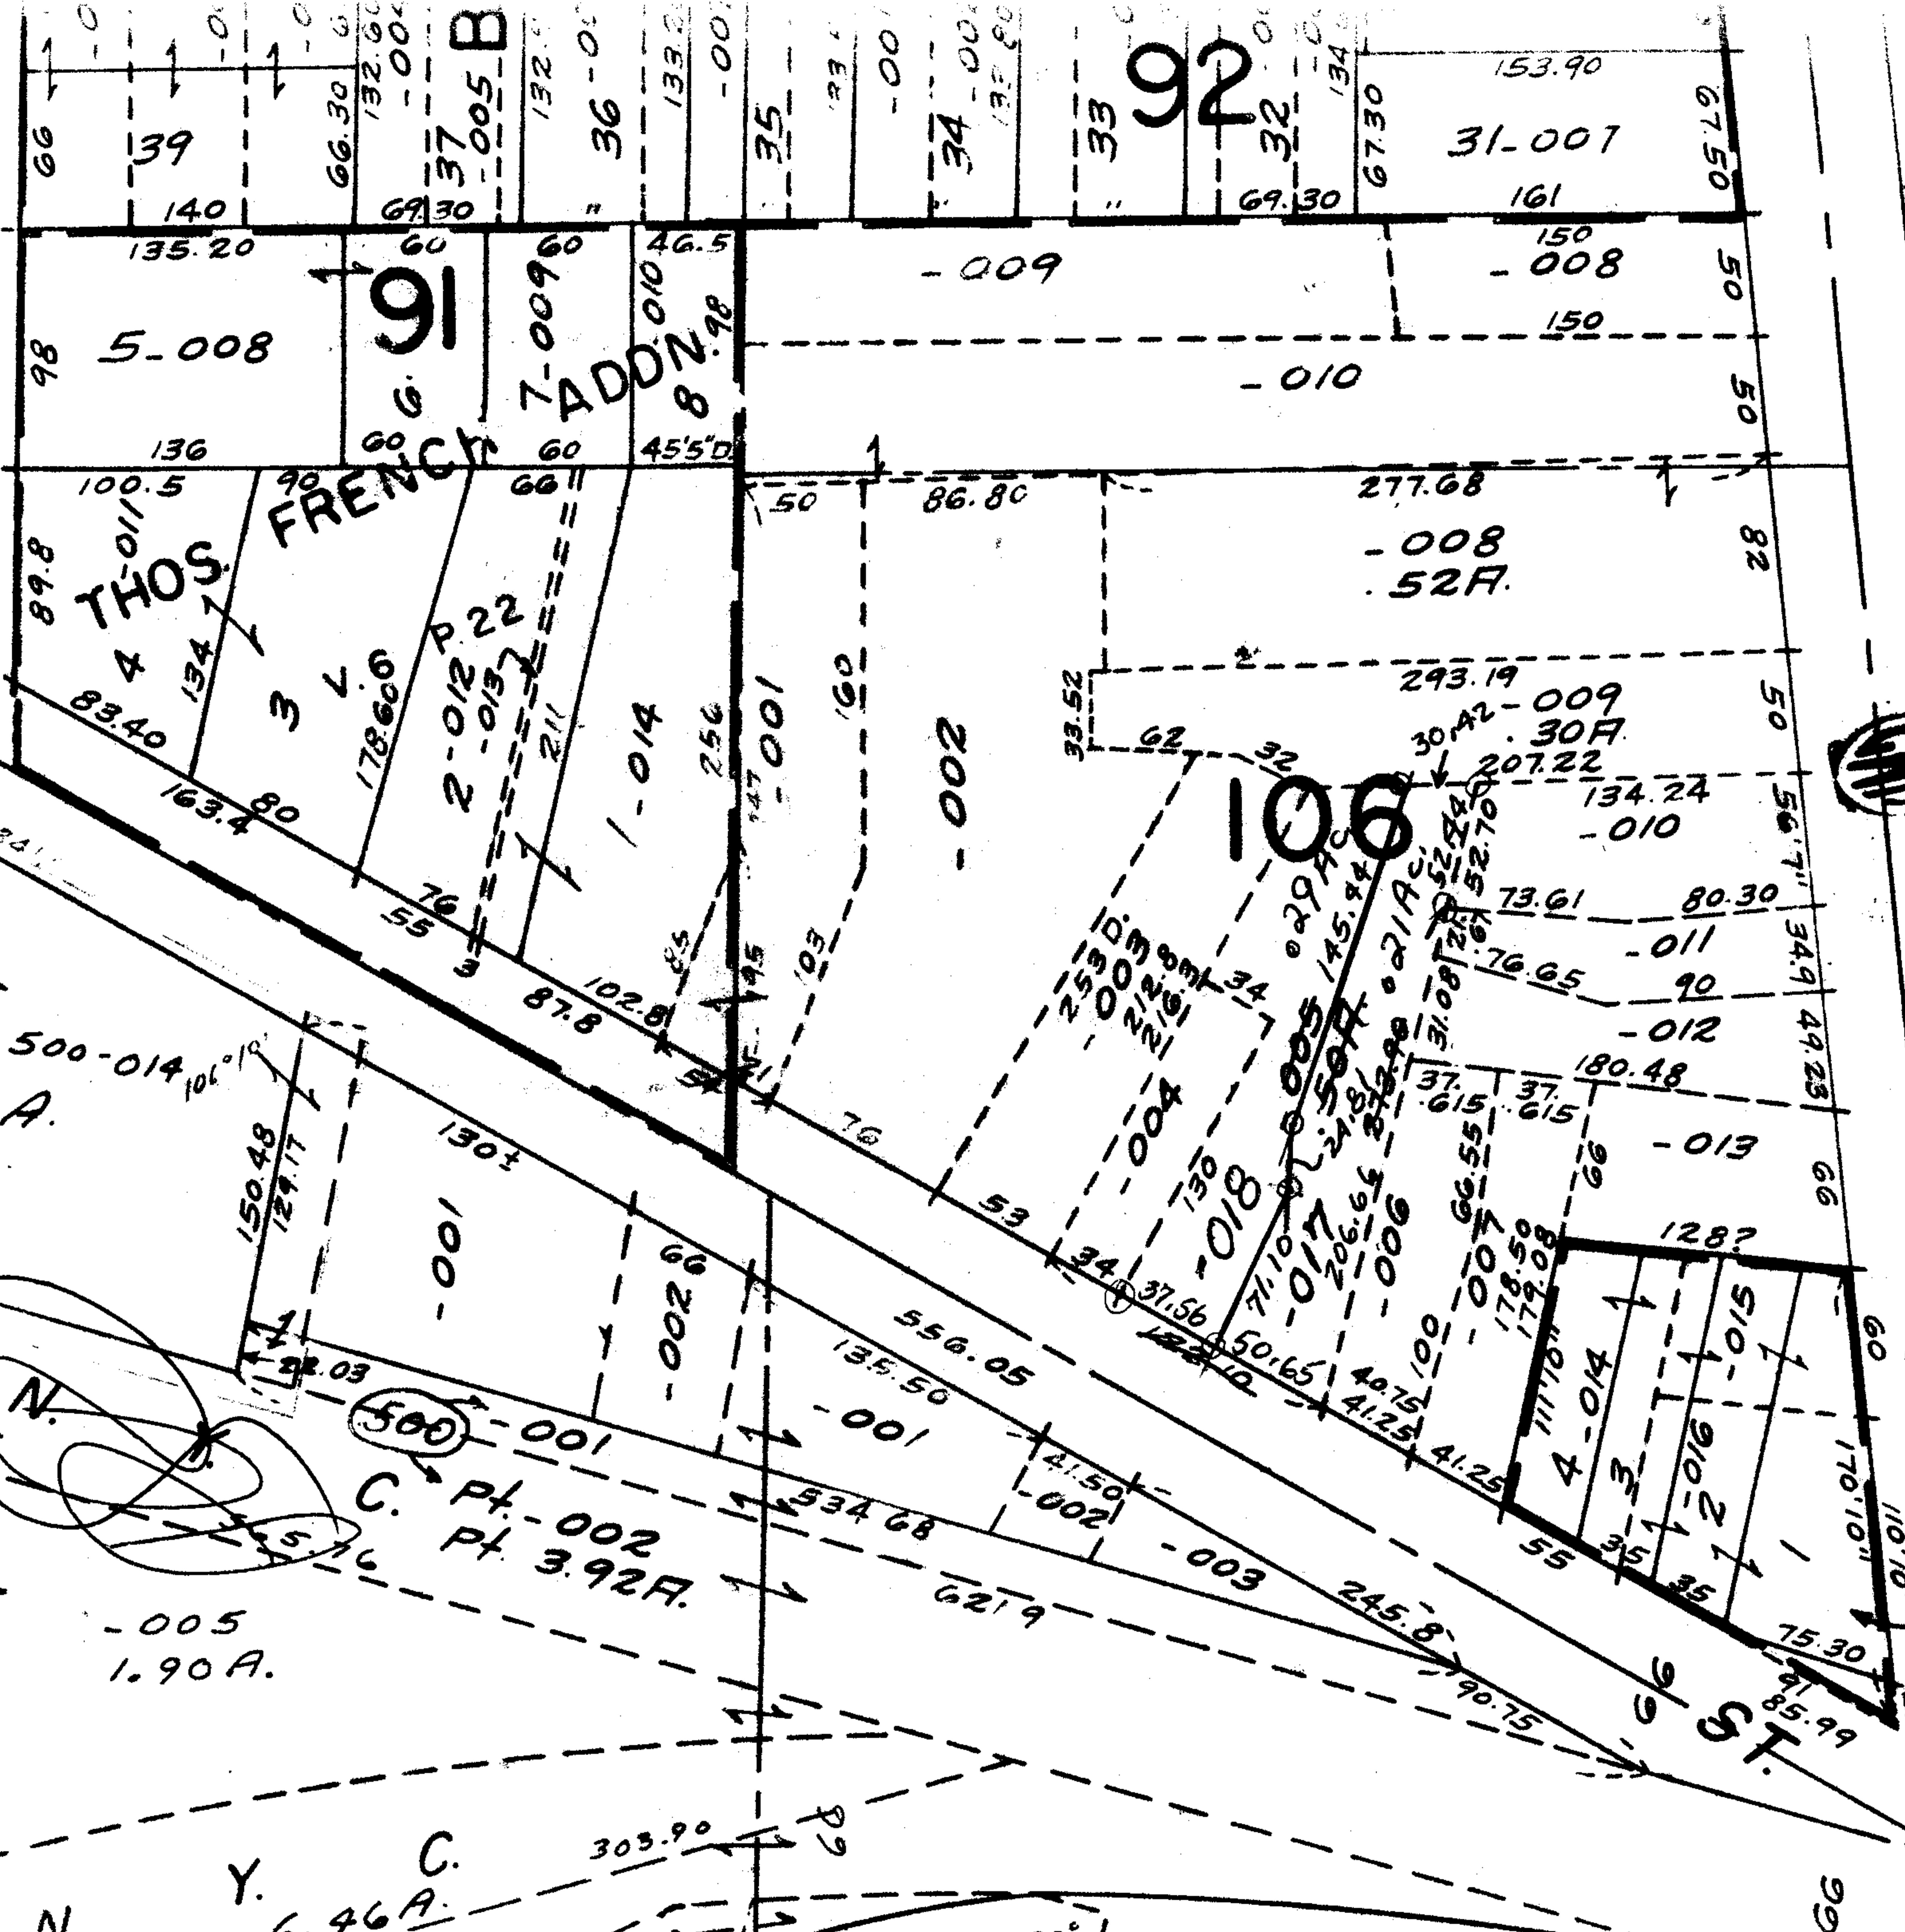

273.90
52.70
221.20
221.67
200

6518

APPROVED
LORAIN CO.
MAP DEPT.
DATE 11-21-72
6-99
BY *Edwert*

H. H. LAKES
V. 2 P. 2

R. P.

06-24-094-500-014 10°
1.29 A.

-005
1.90 A.

C. Pt. -002
Pt. 3.92 F.

N. Y. C.
6.46 A.

93

105

94