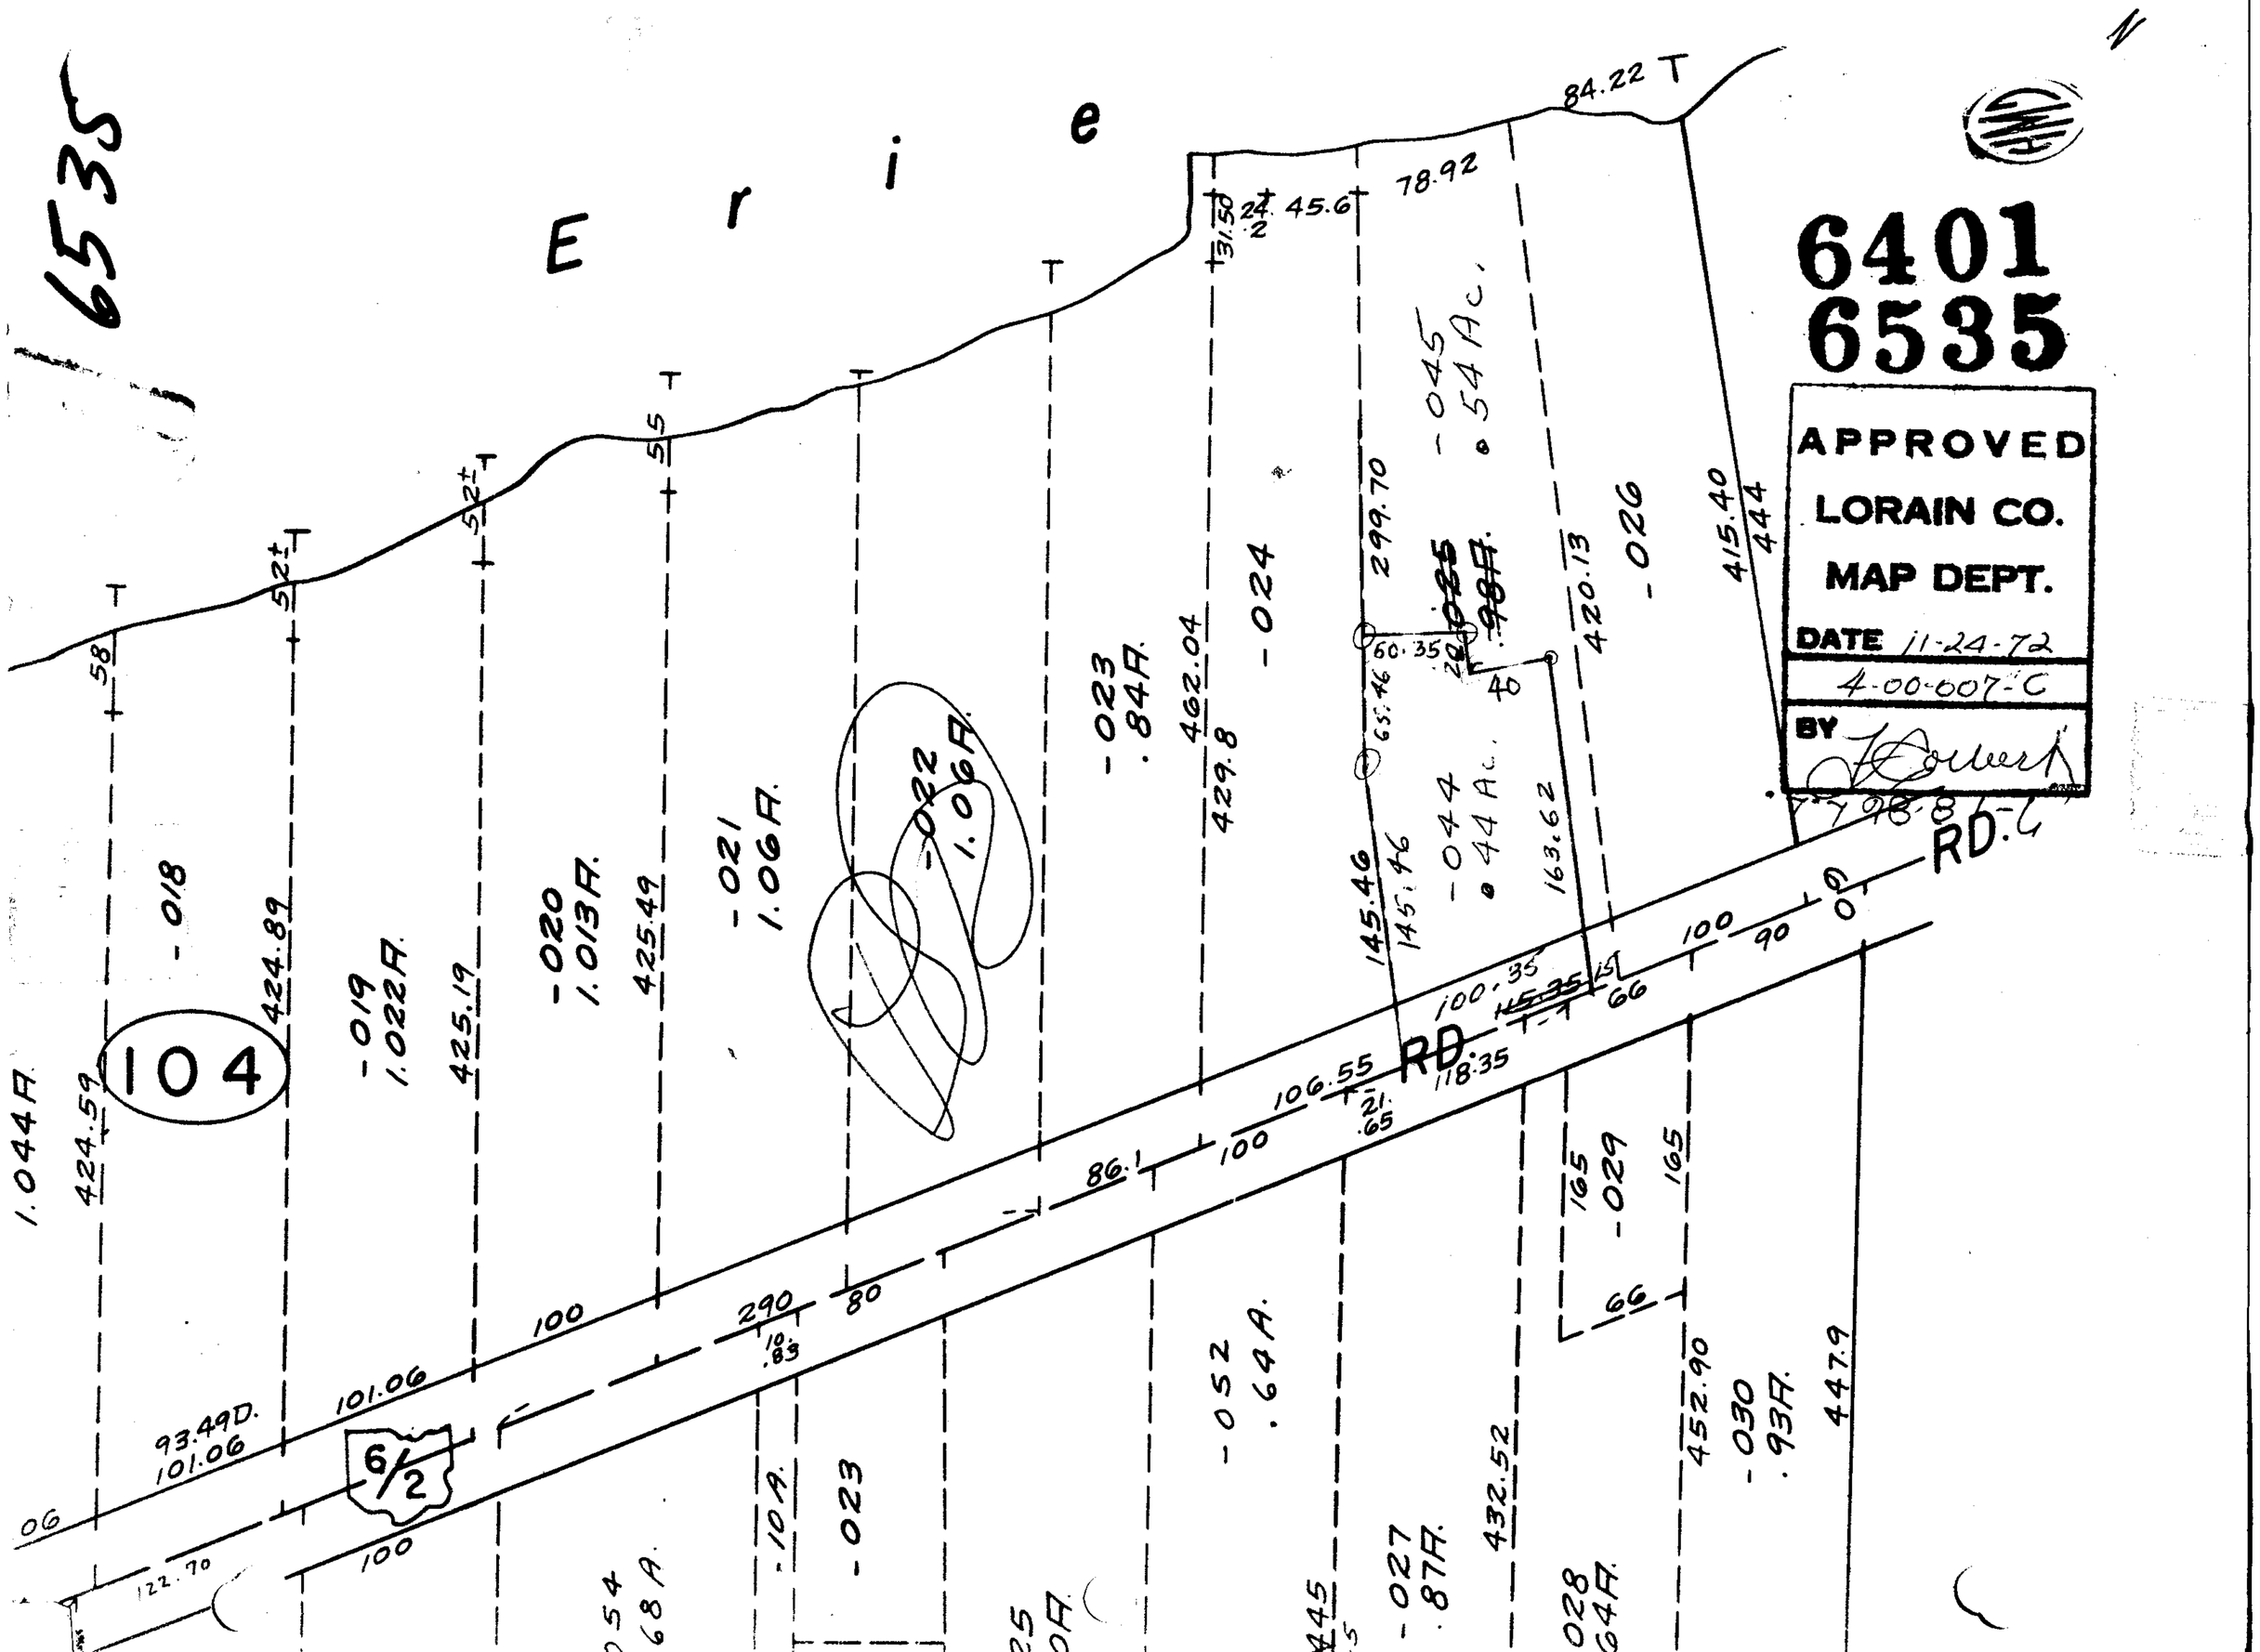
6535
Erie
6401
6535
APPROVED
LORAIN CO.
MAP DEPT.
DATE 11-24-72
4-00-007-C
BY
104
6/2
RD.
RD.
84.22 T
78.92
45.6
24.2
31.50
-045
.54 Ac.
-044
.44 Ac.
-026
-024
-023
.84A.
-022
1.06A.
-021
1.06A.
-020
1.013A.
-019
1.022A.
-018
1.044A.
424.59
424.89
425.19
425.49
462.04
429.8
299.70
420.13
415.40
444
145.46
145.46
163.62
60.35
65.46
40
100.35
115.35
118.35
106.55
21.65
86.1
100
290
80
10.83
101.06
93.49D.
101.06
122.70
-052
.64A.
-027
.87A.
432.52
-029
165
165
66
452.90
-030
.93A.
447.9
-10A.
-023
-028
.64A.
-054
.68A.
58
52±
52±
55
100
90
66
0