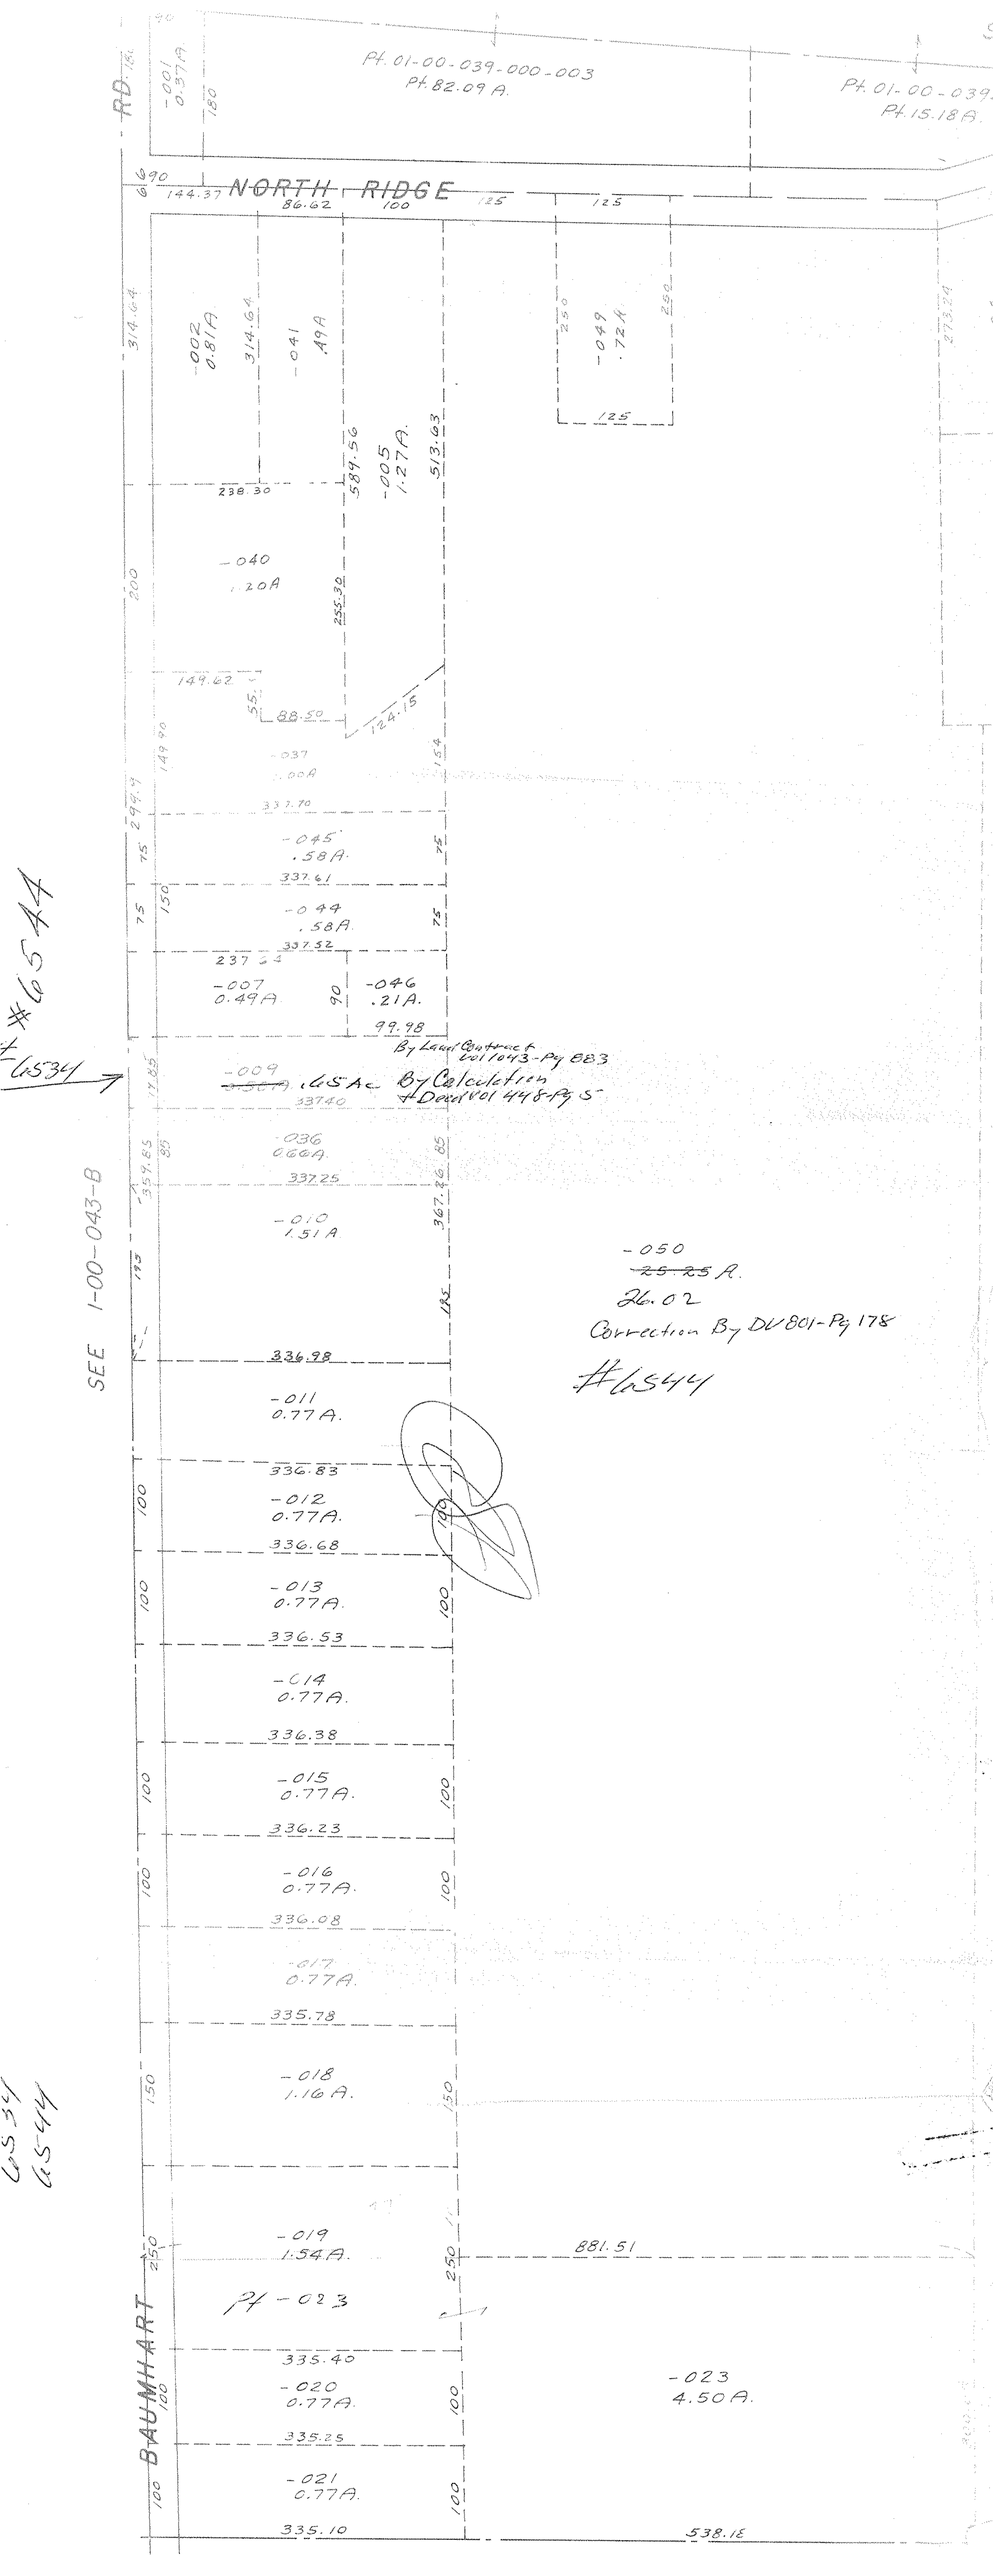

Pt. 01-00-039-000-003
Pt. 82.09 A.
Pt. 01-00-039
Pt. 15.18 A.
NORTH RIDGE
RD.
-001
0.37 A
-002
0.81 A
-041
.49 A
-049
.72 A
-005
1.27 A.
-040
1.20 A
-037
1.00 A
-045
.58 A.
-044
.58 A.
-007
0.49 A
-046
.21 A.
-009
.65 Ac
By Land Contract Vol 1043-Pg 883
By Calculation & Deed Vol 448-Pg 5
-036
0.66 A.
-010
1.51 A
-050
~~25.25~~ A.
26.02
Correction By DV 801-Pg 178
#6544
-011
0.77 A.
-012
0.77 A.
-013
0.77 A.
-014
0.77 A.
-015
0.77 A.
-016
0.77 A.
-017
0.77 A.
-018
1.16 A.
-019
1.54 A.
Pt -023
-020
0.77 A.
-021
0.77 A.
-023
4.50 A.
BAUMHART
SEE 1-00-043-B
#6544
#6534
6534
6544
881.51
538.18