


14-B

6545

RD

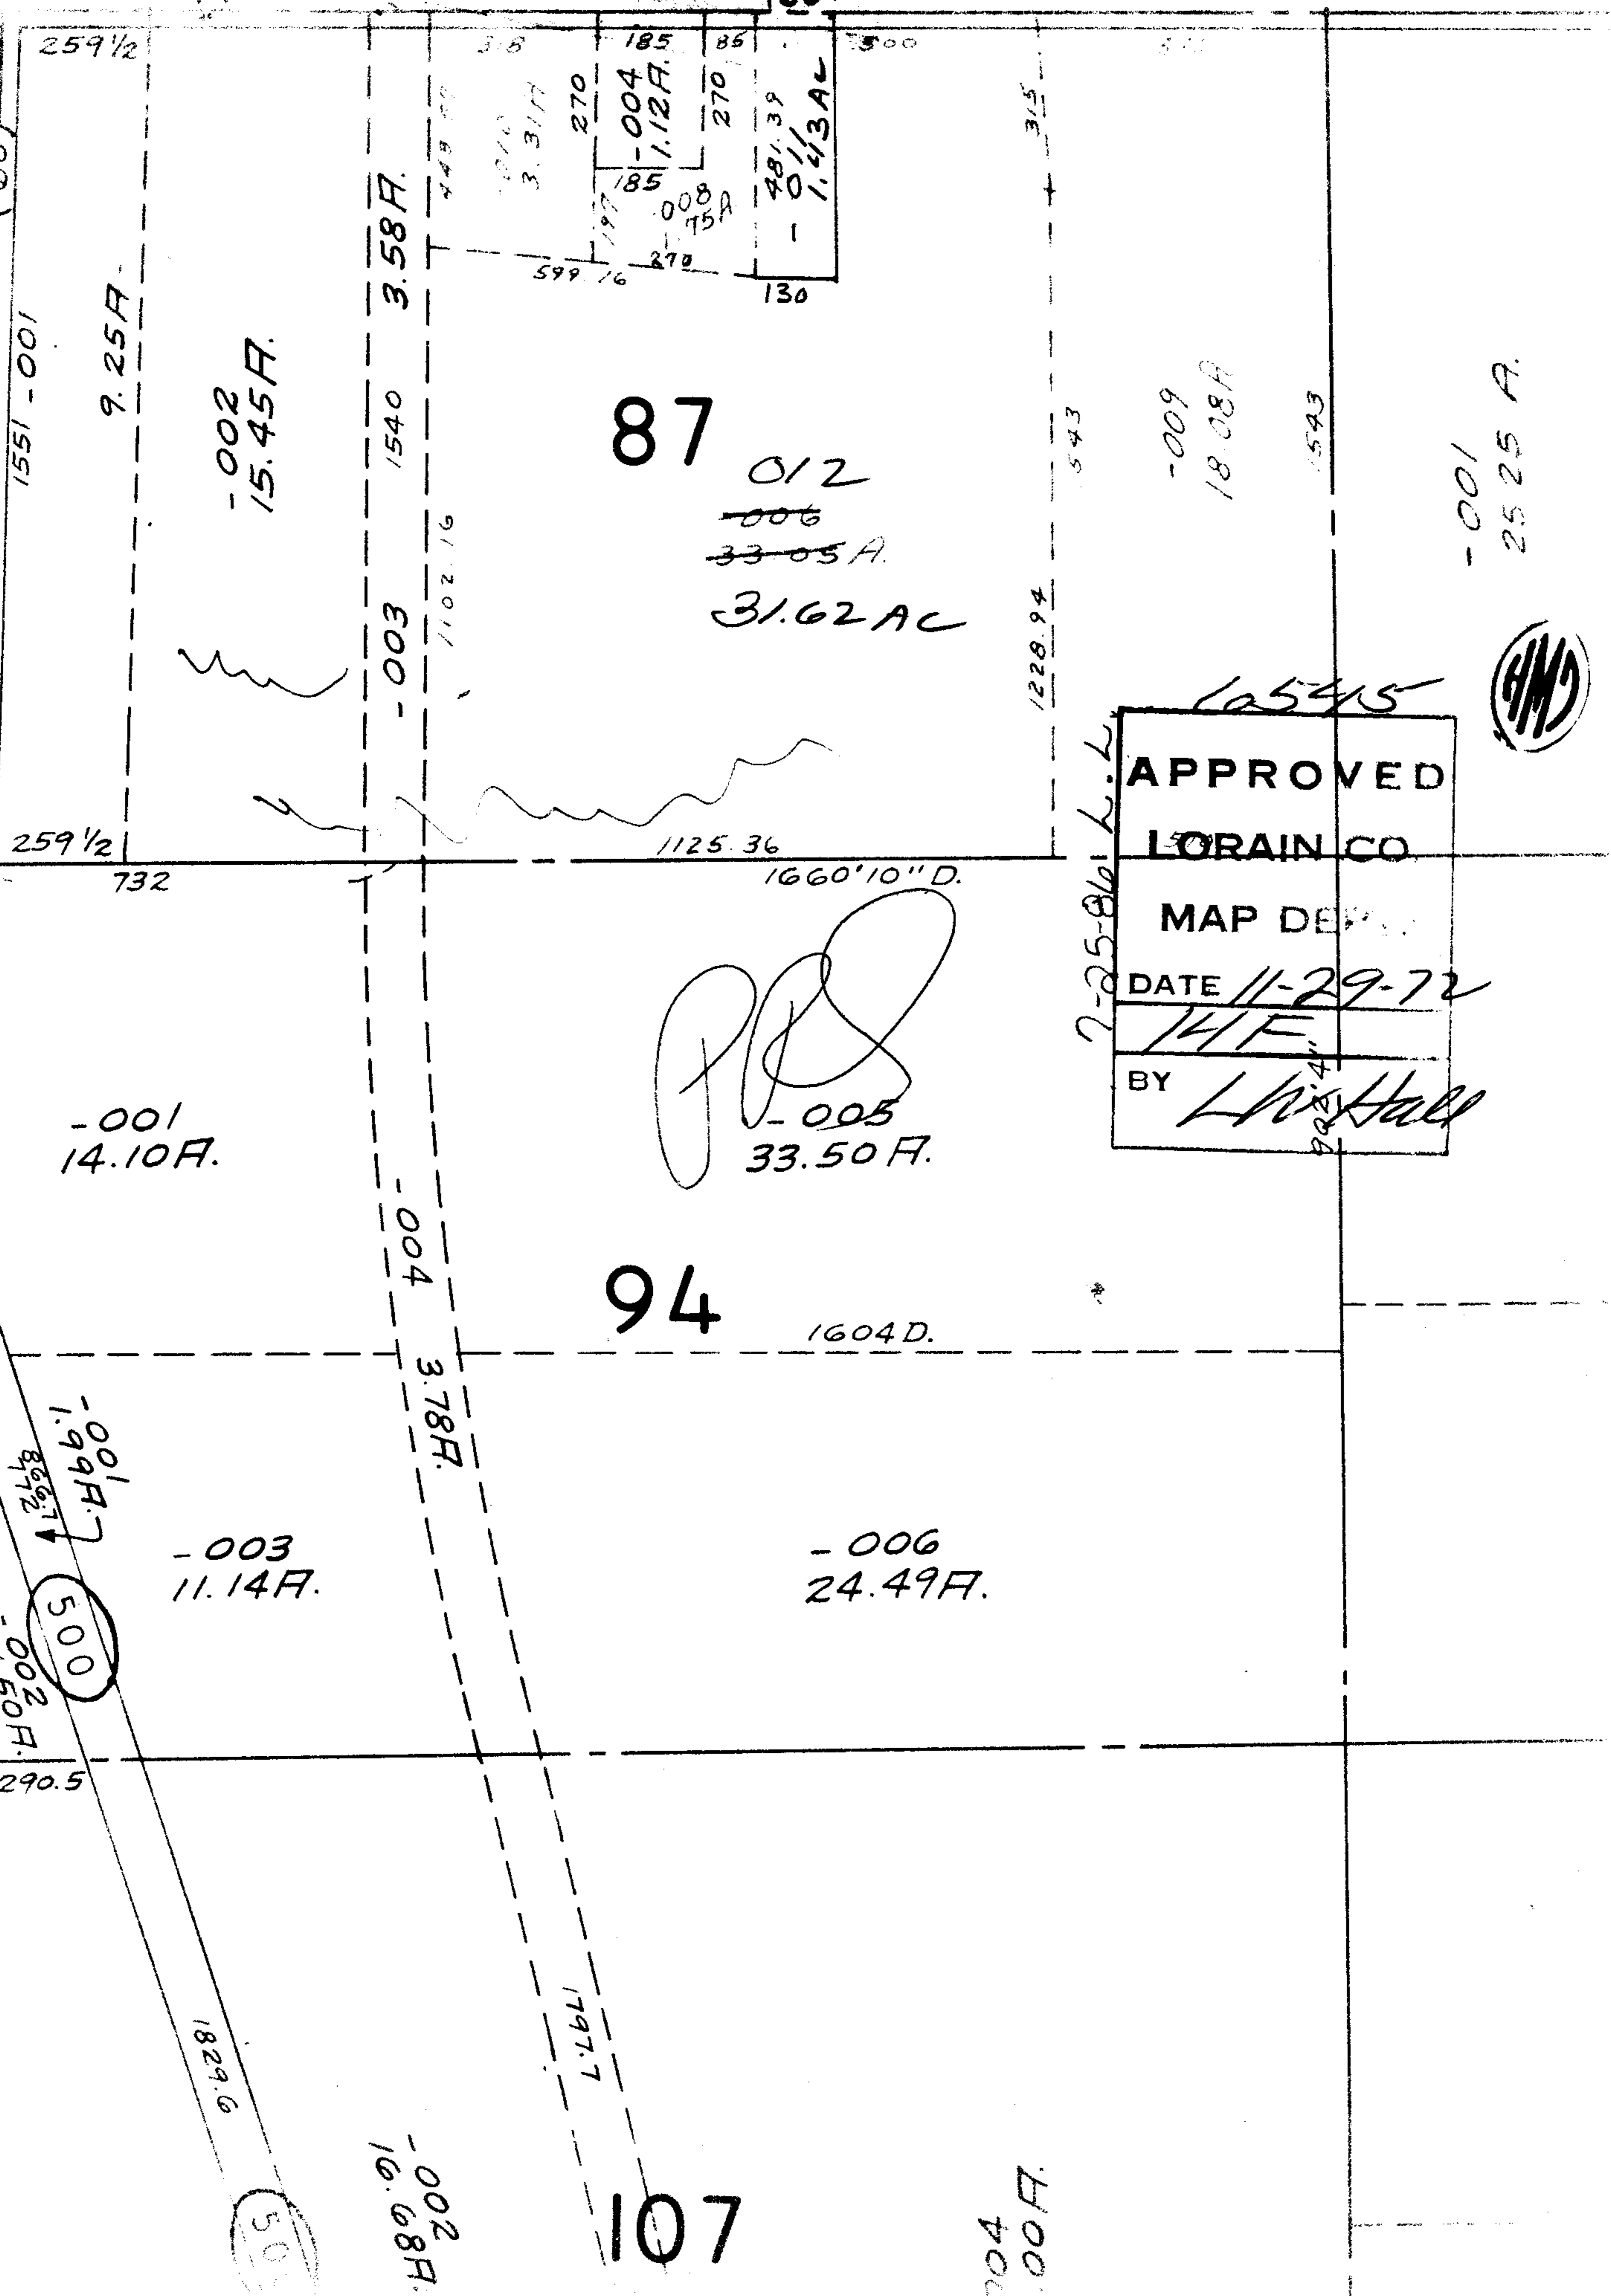

87
 012
~~006~~
~~33.05 A.~~
 31.62 AC

6545
APPROVED
LORAIN CO.
 MAP DEPT.
 DATE 11-29-72
 W.F.
 BY L. Hall



94
 1604 D.

107

-002
 15.45 F.

-001
 14.10 F.

-003
 11.14 F.

-006
 24.49 F.

-002
 16.68 F.

-001
 25.25 A.

-009
 18.08 F.

