


GARFIELD

6553

APPROVED
 LORAIN CO.
 MAP DEPT.
 DATE 11-30-72
 3-00-050
 BY *[Signature]*

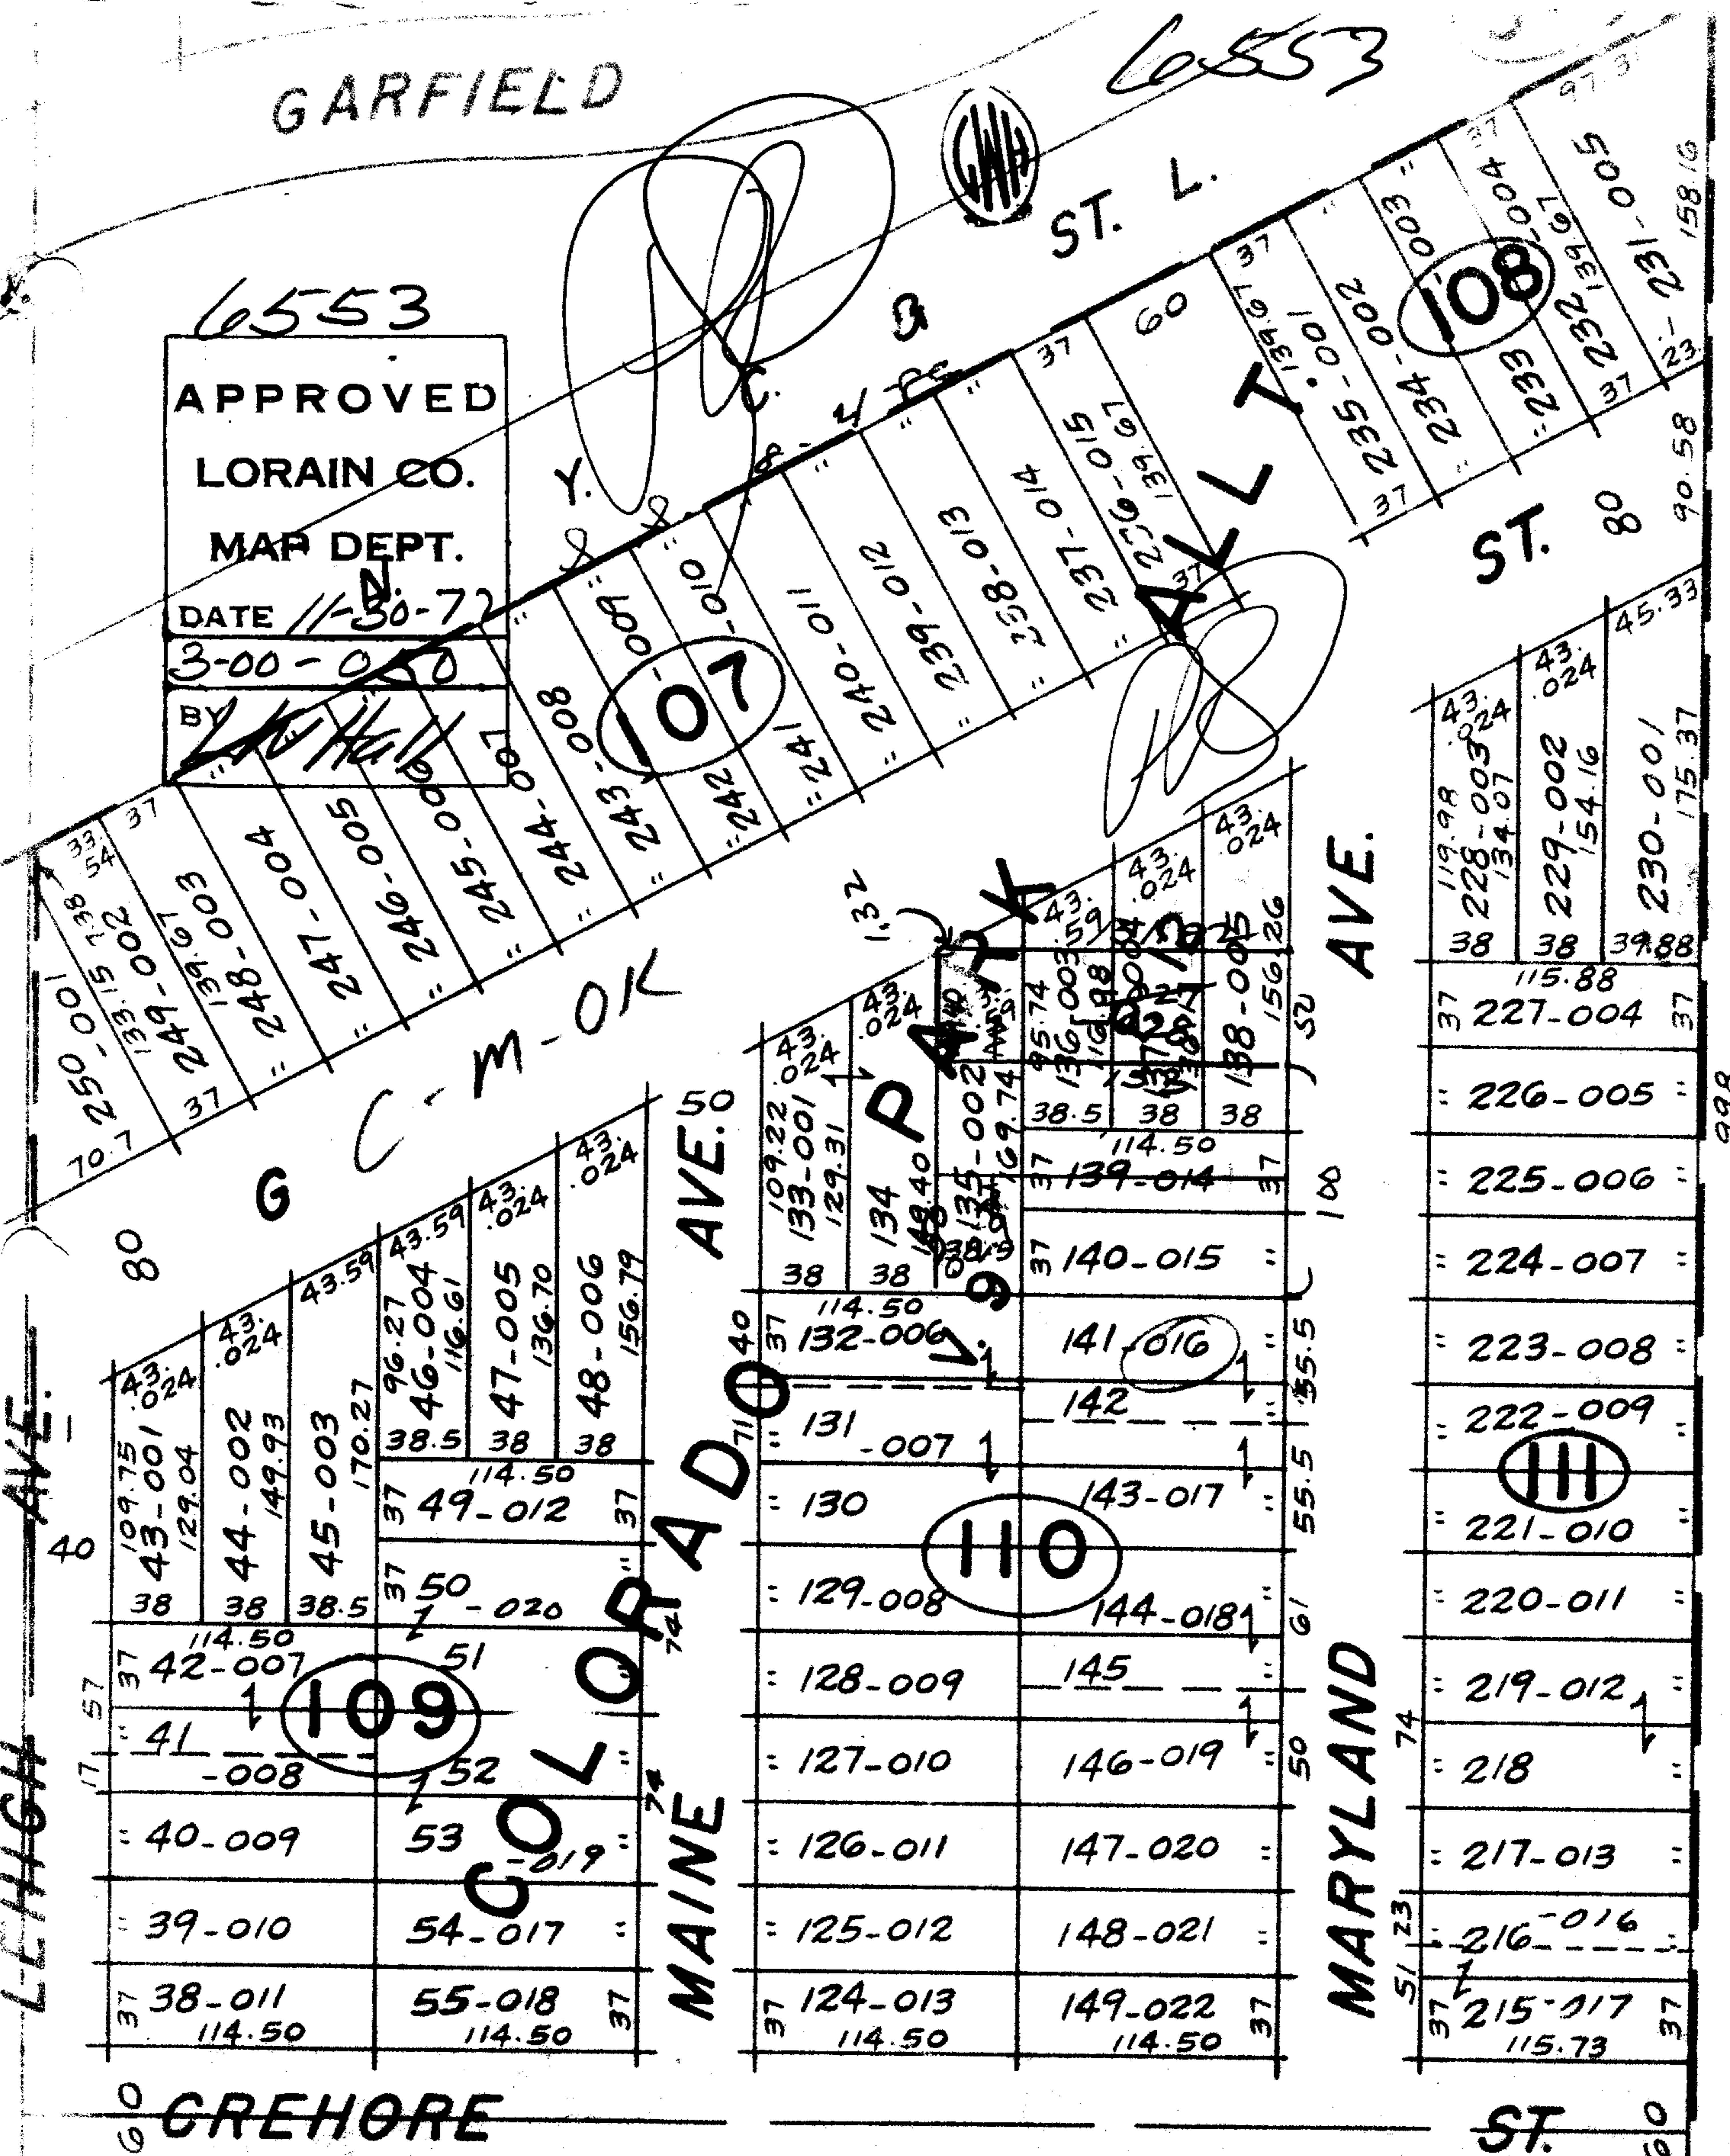

SHEFFIELD TWP.

SCALE: 1" = 100'

SEE 3-00-05.