
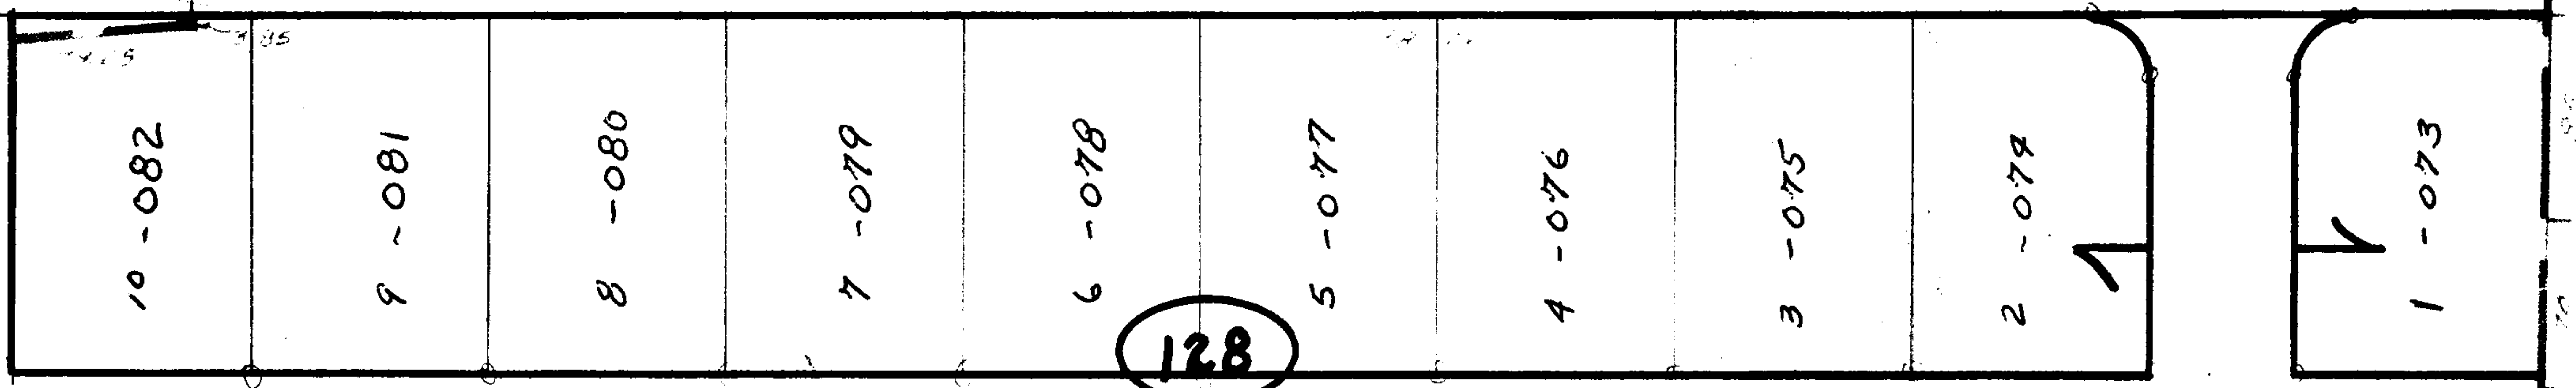


6556

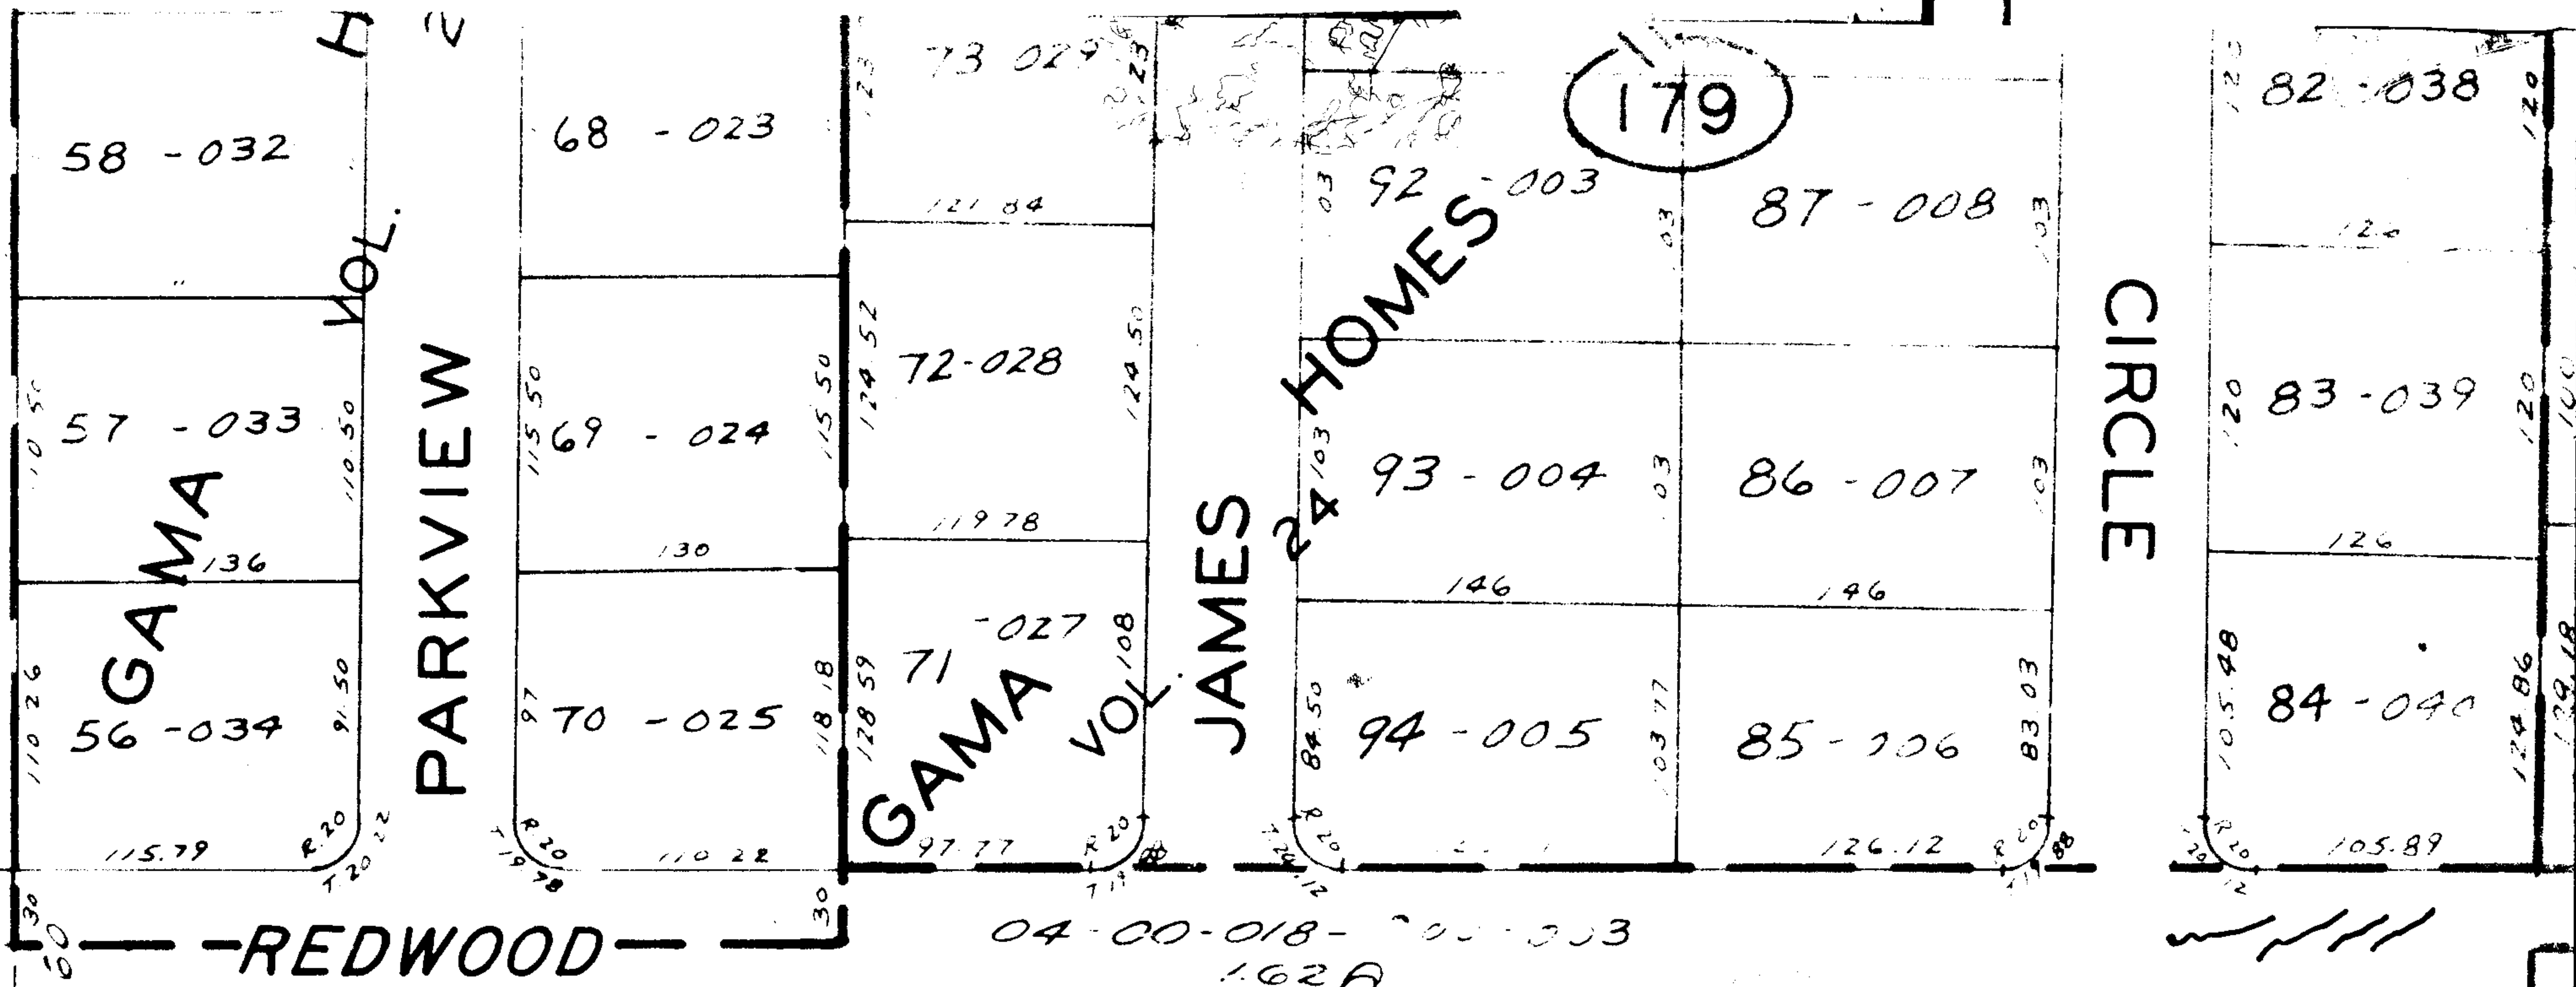

C.M. OK

~~120.006~~
~~120.006~~
~~120.006~~

V. 28 P. 5
 Washington Park Sub No. 5
 # 6556

~~120.006~~

Remainder
 -083
 21.64 Ac.

~~25.08~~
~~25.09~~
~~21.64~~