


6562

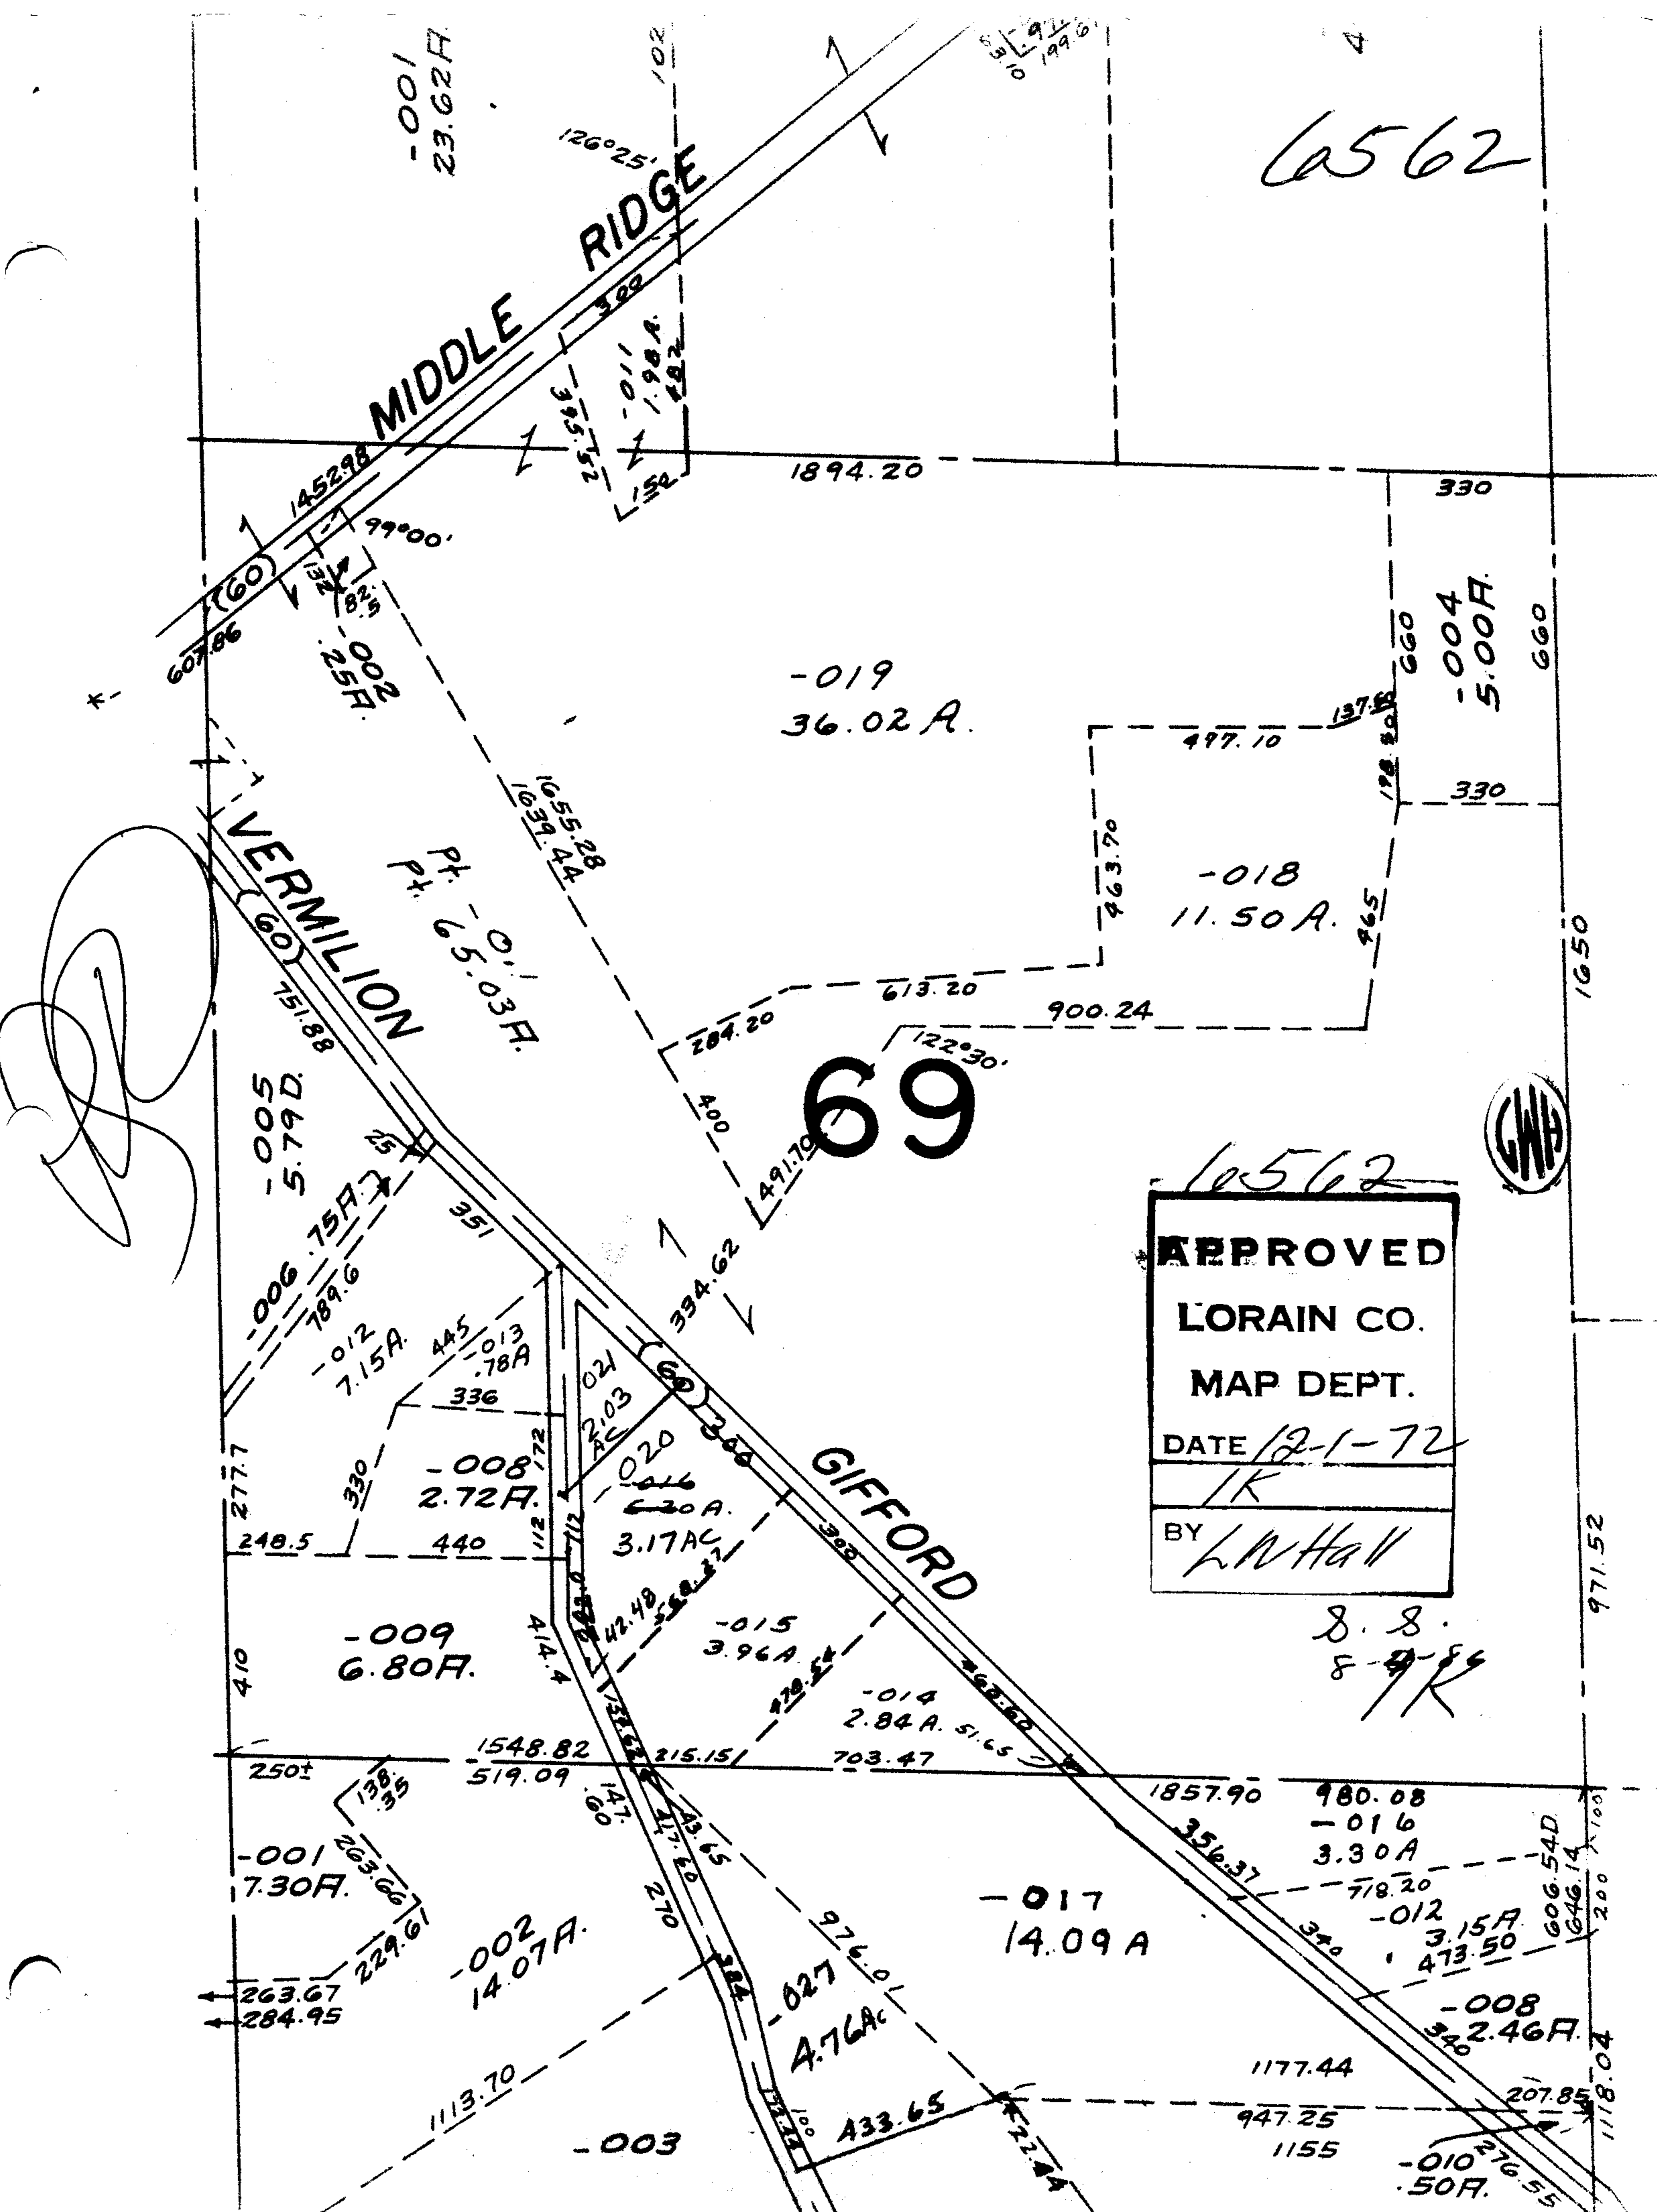

-019
36.02 A.

-018
11.50 A.

69

10562

APPROVED

LORAIN CO.

MAP DEPT.

DATE 12-1-72

IK

BY L.N. Hall

S.S.
8-9-56



971.52

606.54D.
646.14
200

1118.04