



6563

5

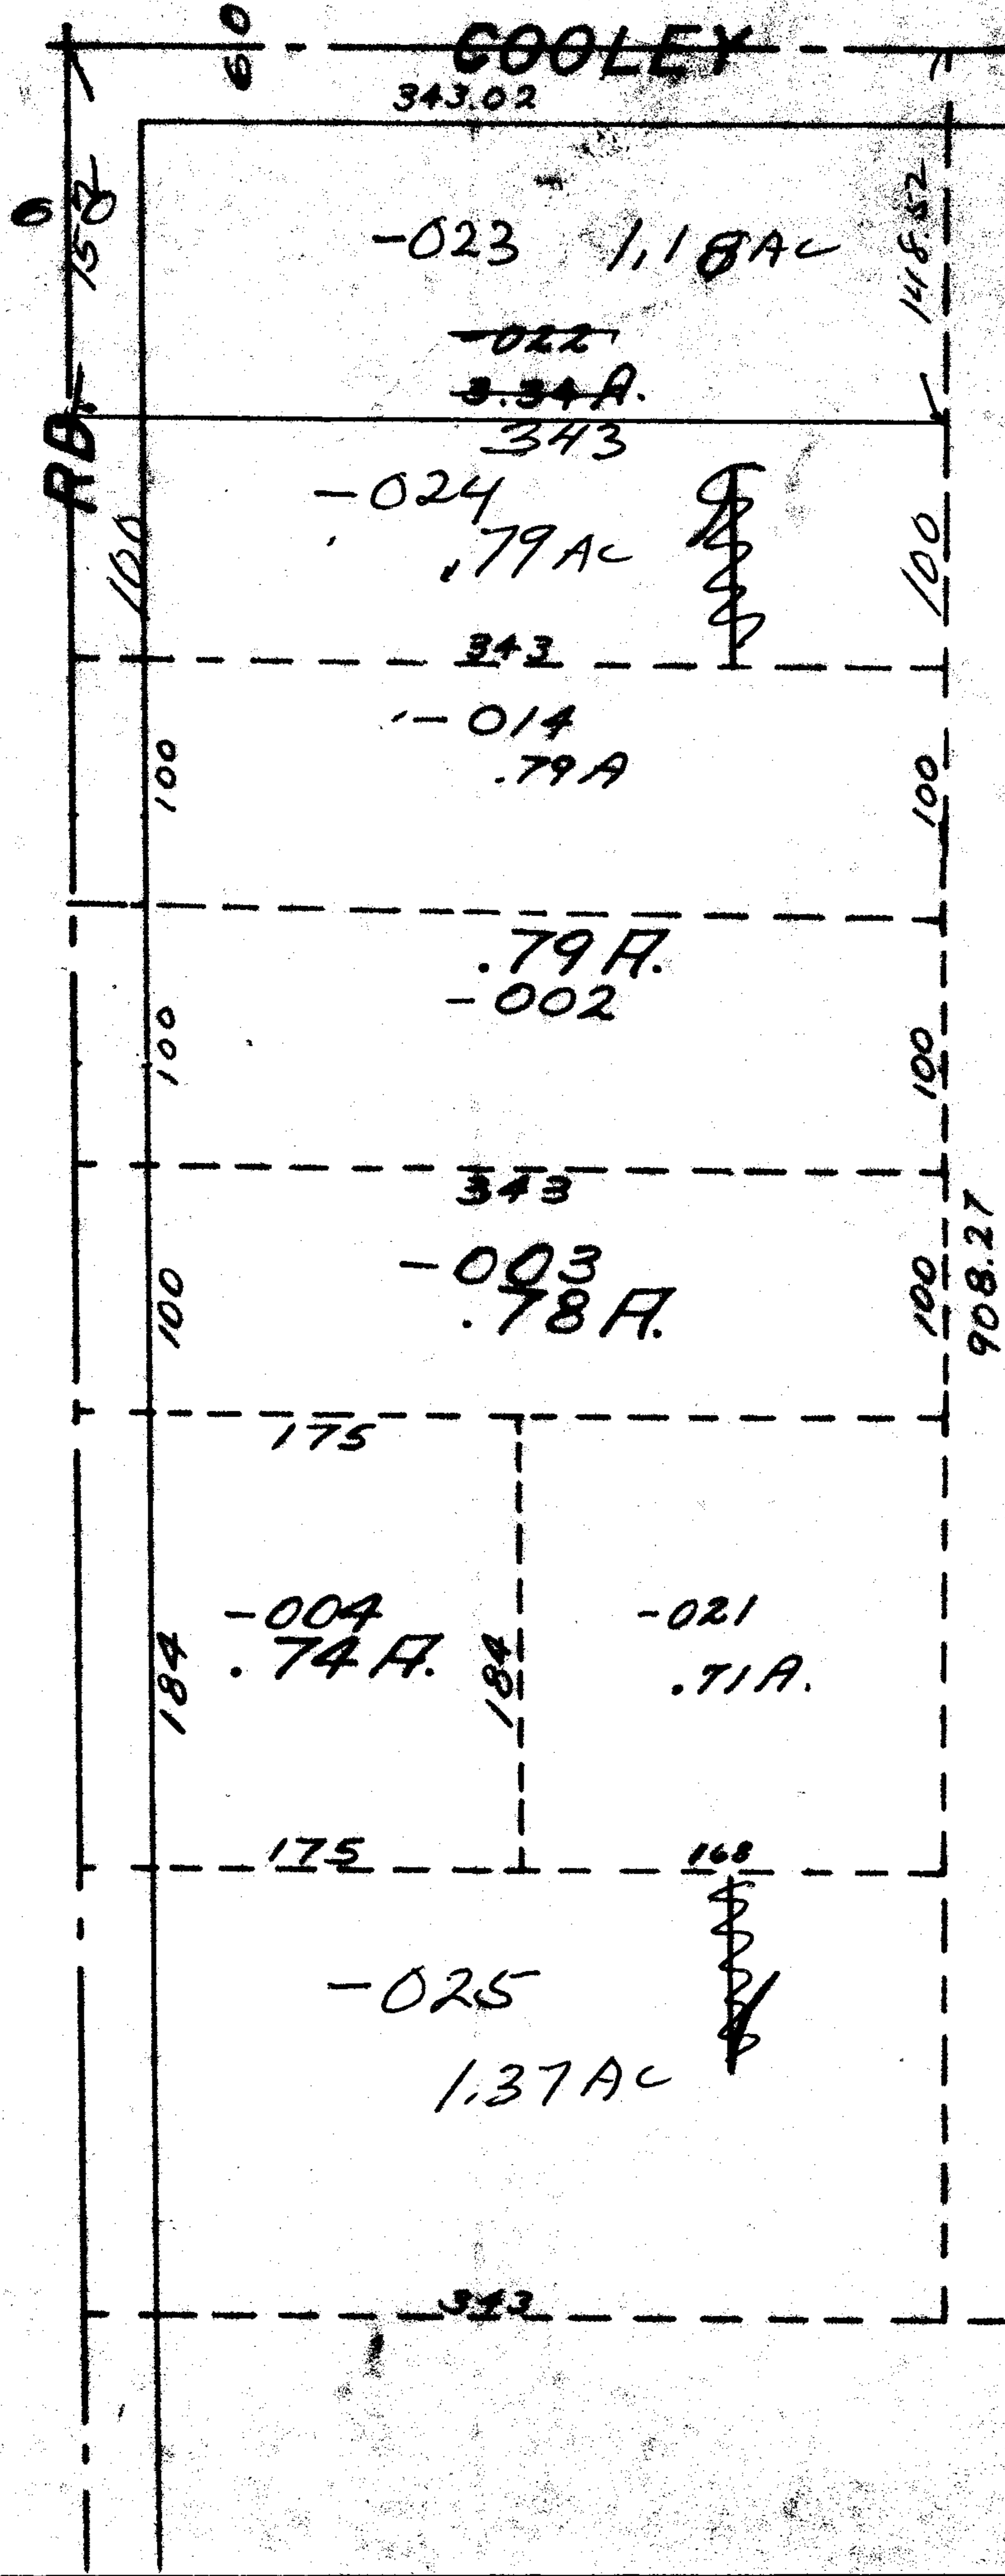

C-M-OK

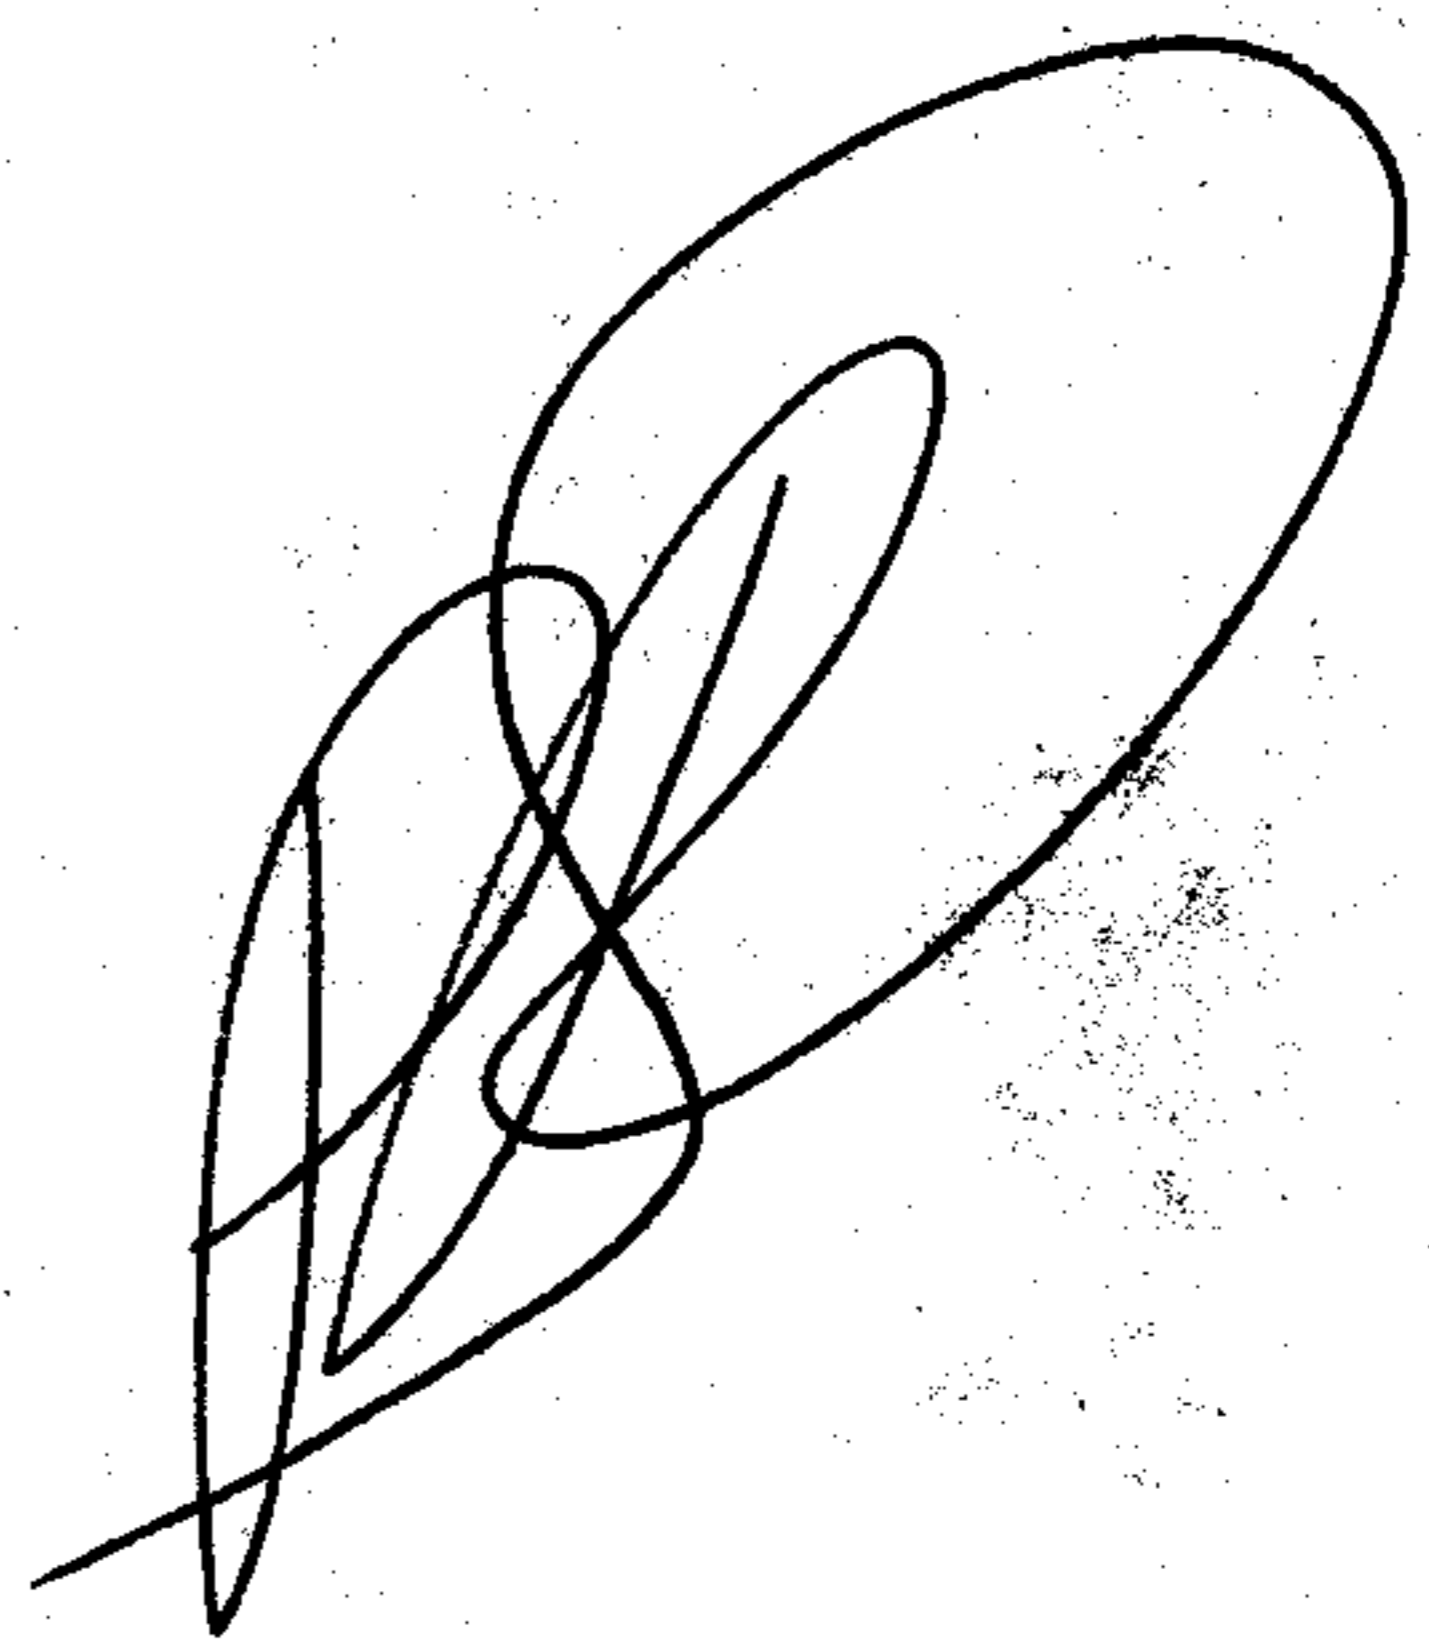

6563

APPROVED
LORAIN CO.
MAP DEPT.
DATE 12-4-72
11-00-027A
BY LWH

JJ
7-23-86

11-00-027A

C-M-OK