


6569

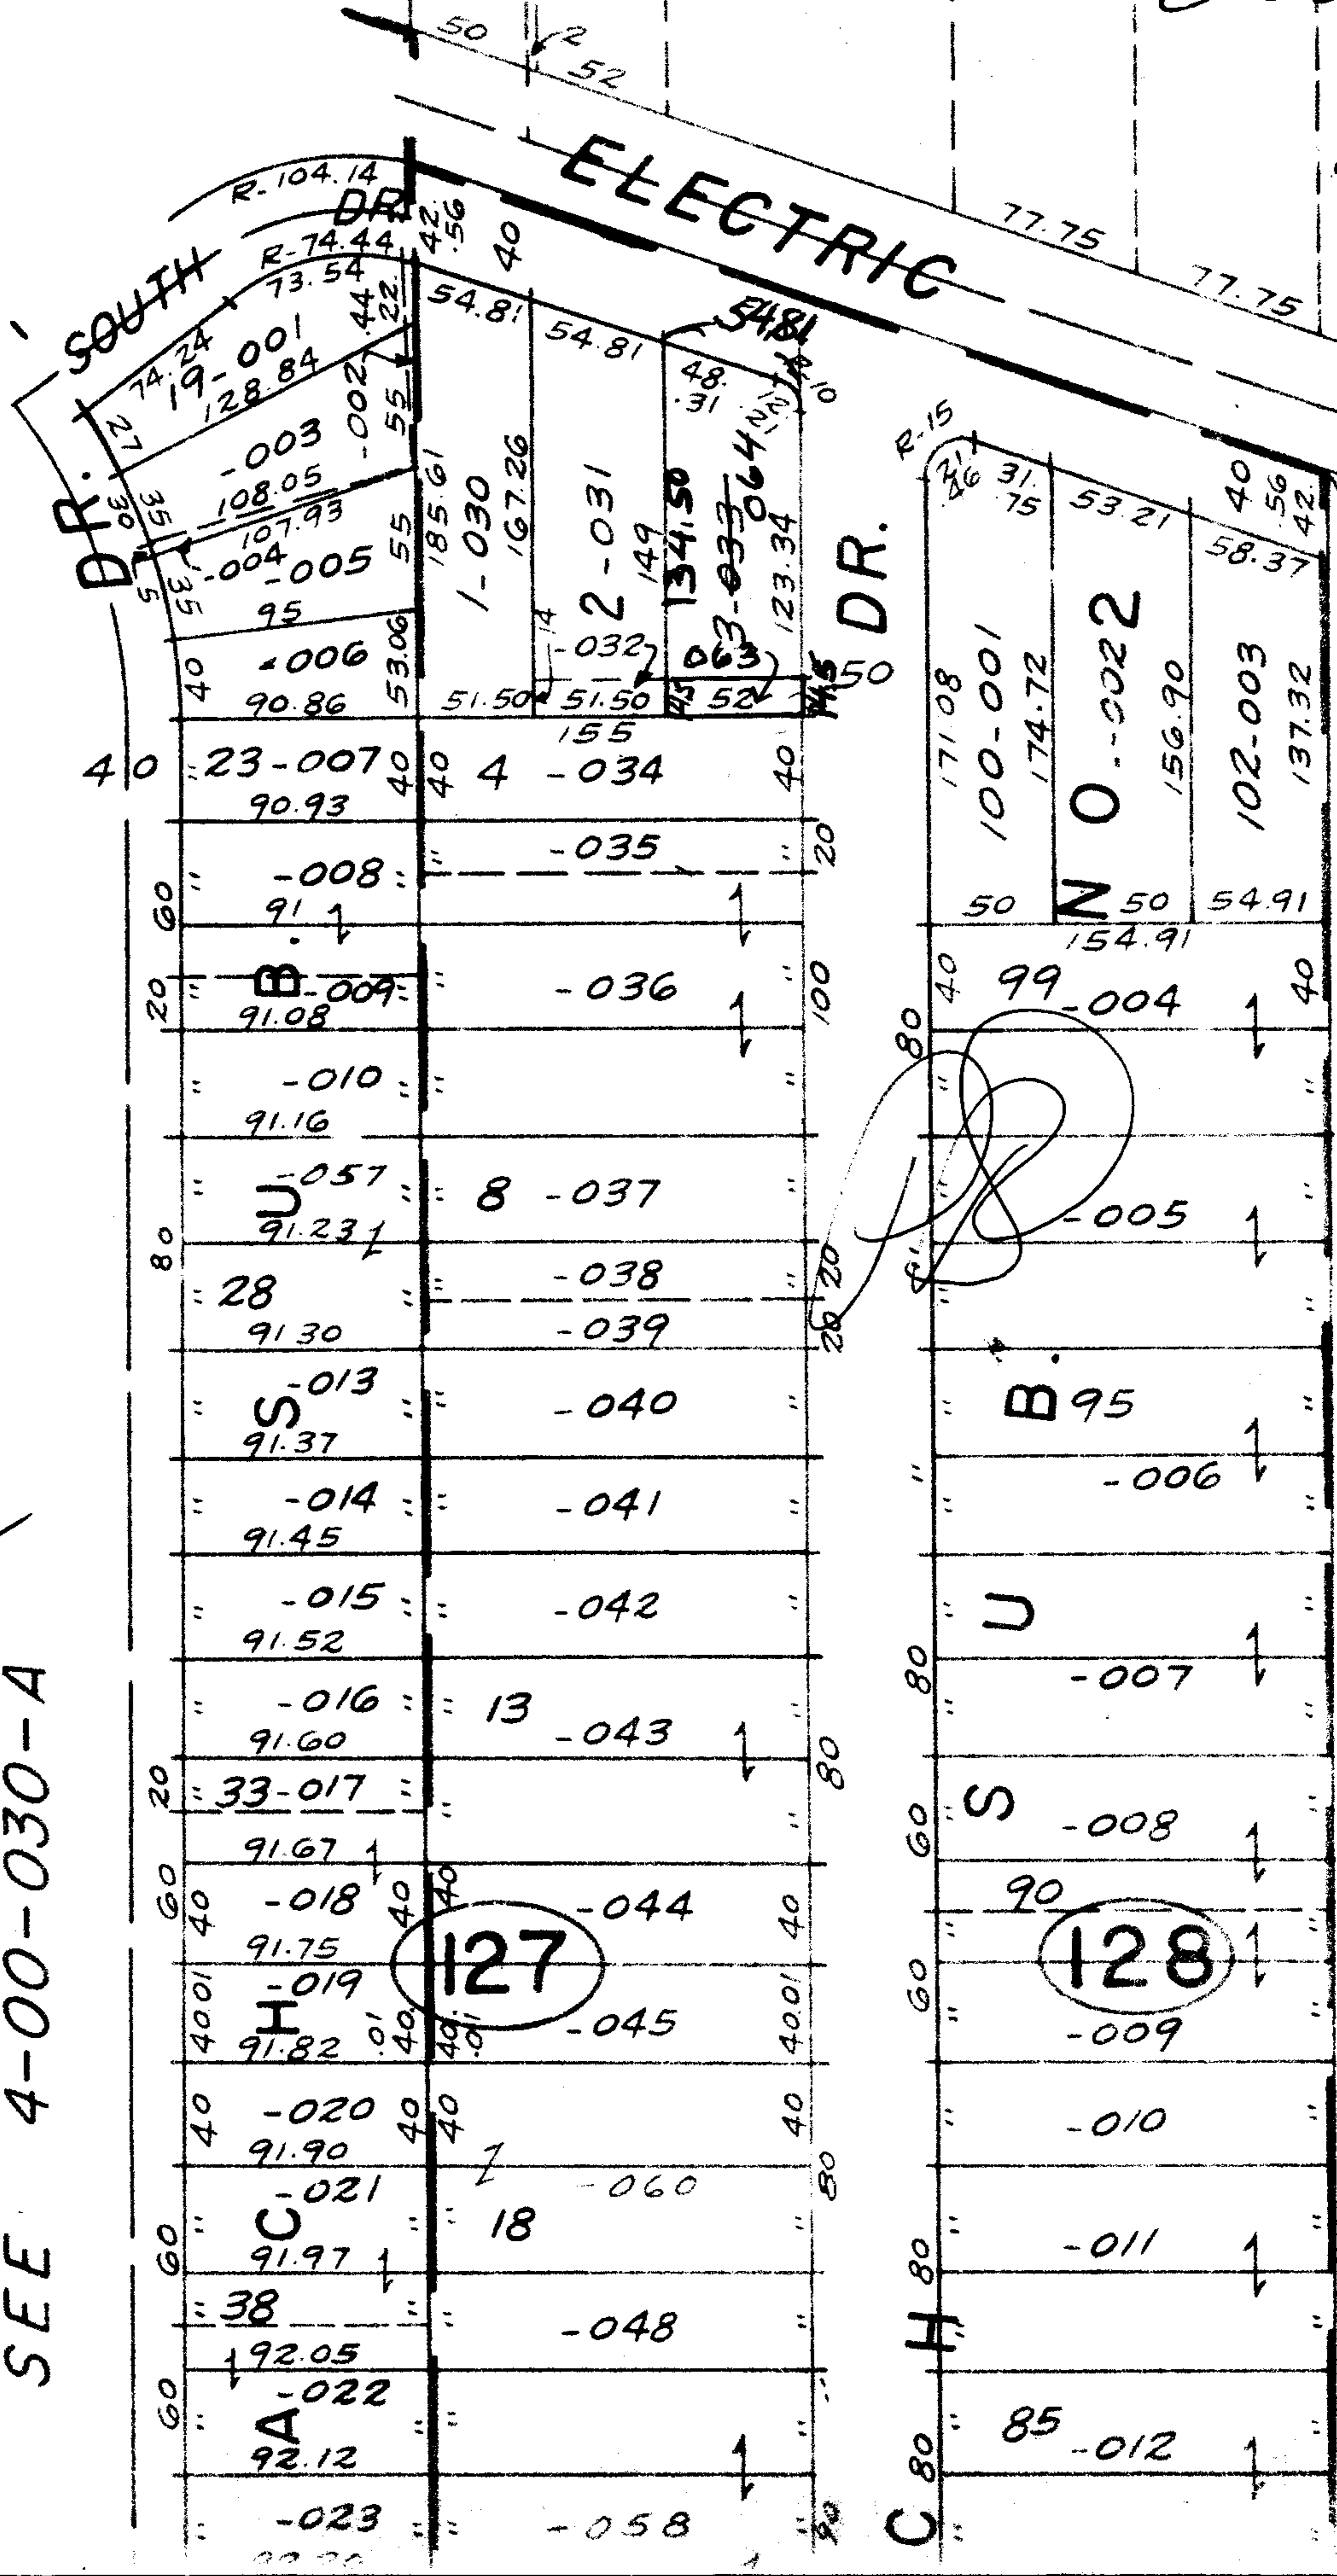

6569

APPROVED
LORAIN CO.
MAP DEPT.
 DATE 12-5-71
 4-00-030B
 BY LWHall

SEE 4-00-030-A

2689.4