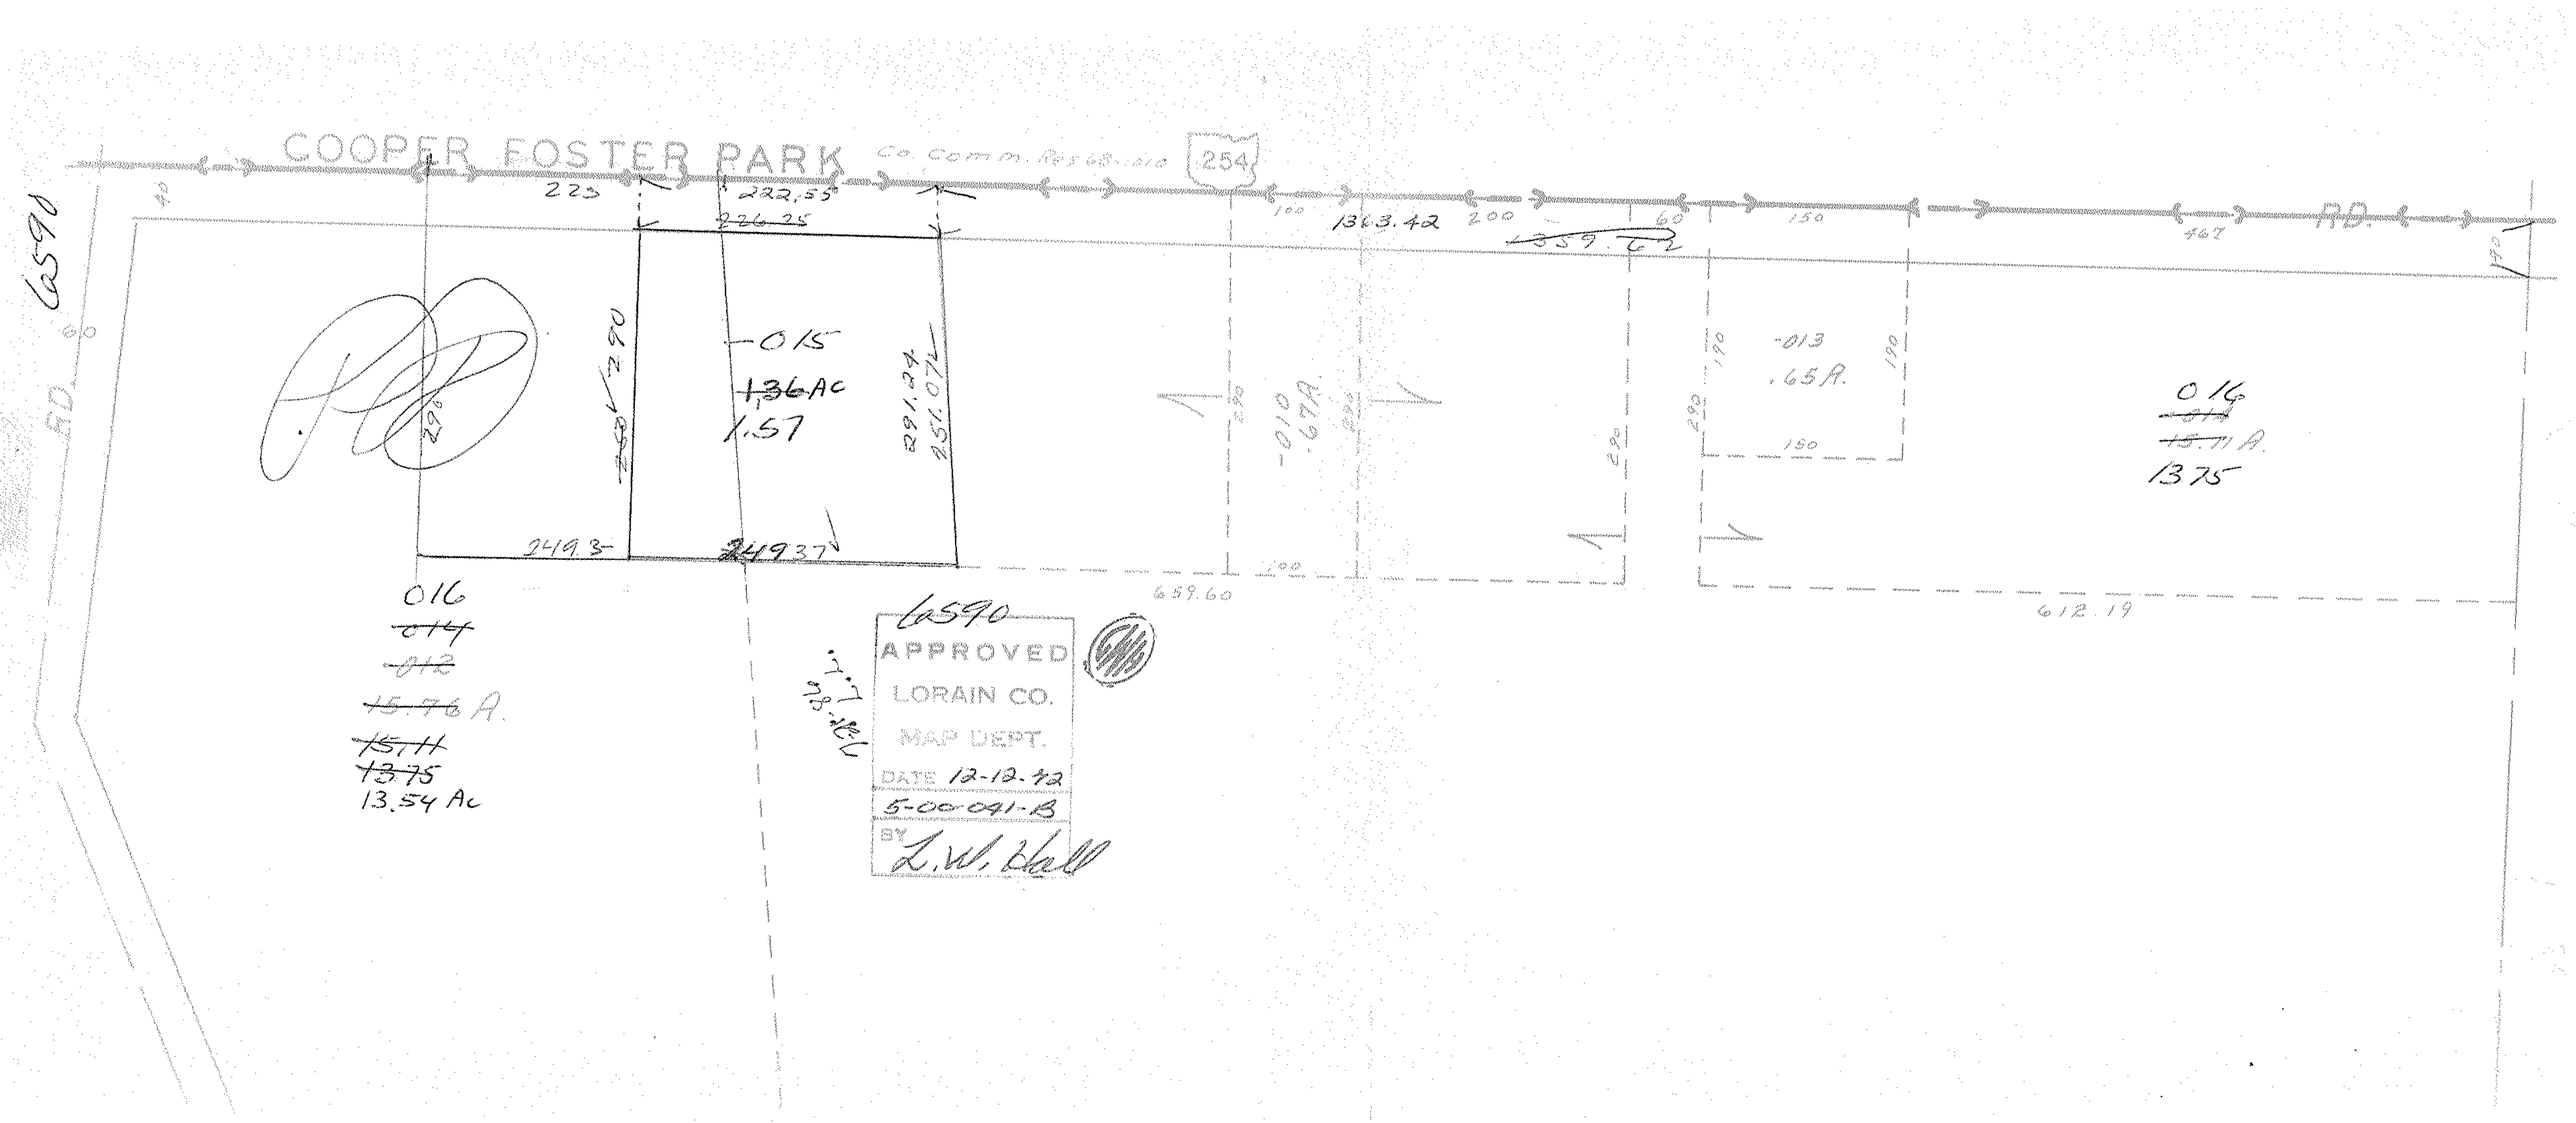
COOPER FOSTER PARK
Co. comm. Reservation
254
6591
40
225
222.55
226.25
100
136.3.42
200
60
150
359.62
467
RD.
015
1.36Ac
1.57
291.07
251.07
249.3
249.37
010
.67A.
280
280
013
.65A.
190
190
150
016
014
15.11A.
1375
659.60
612.19
016
014
012
15.76A.
15.11
1375
13.54 Ac
6590
APPROVED
LORAIN CO.
MAP DEPT.
DATE 12-12-92
5-00-091-B
BY L.W. Hall