6592

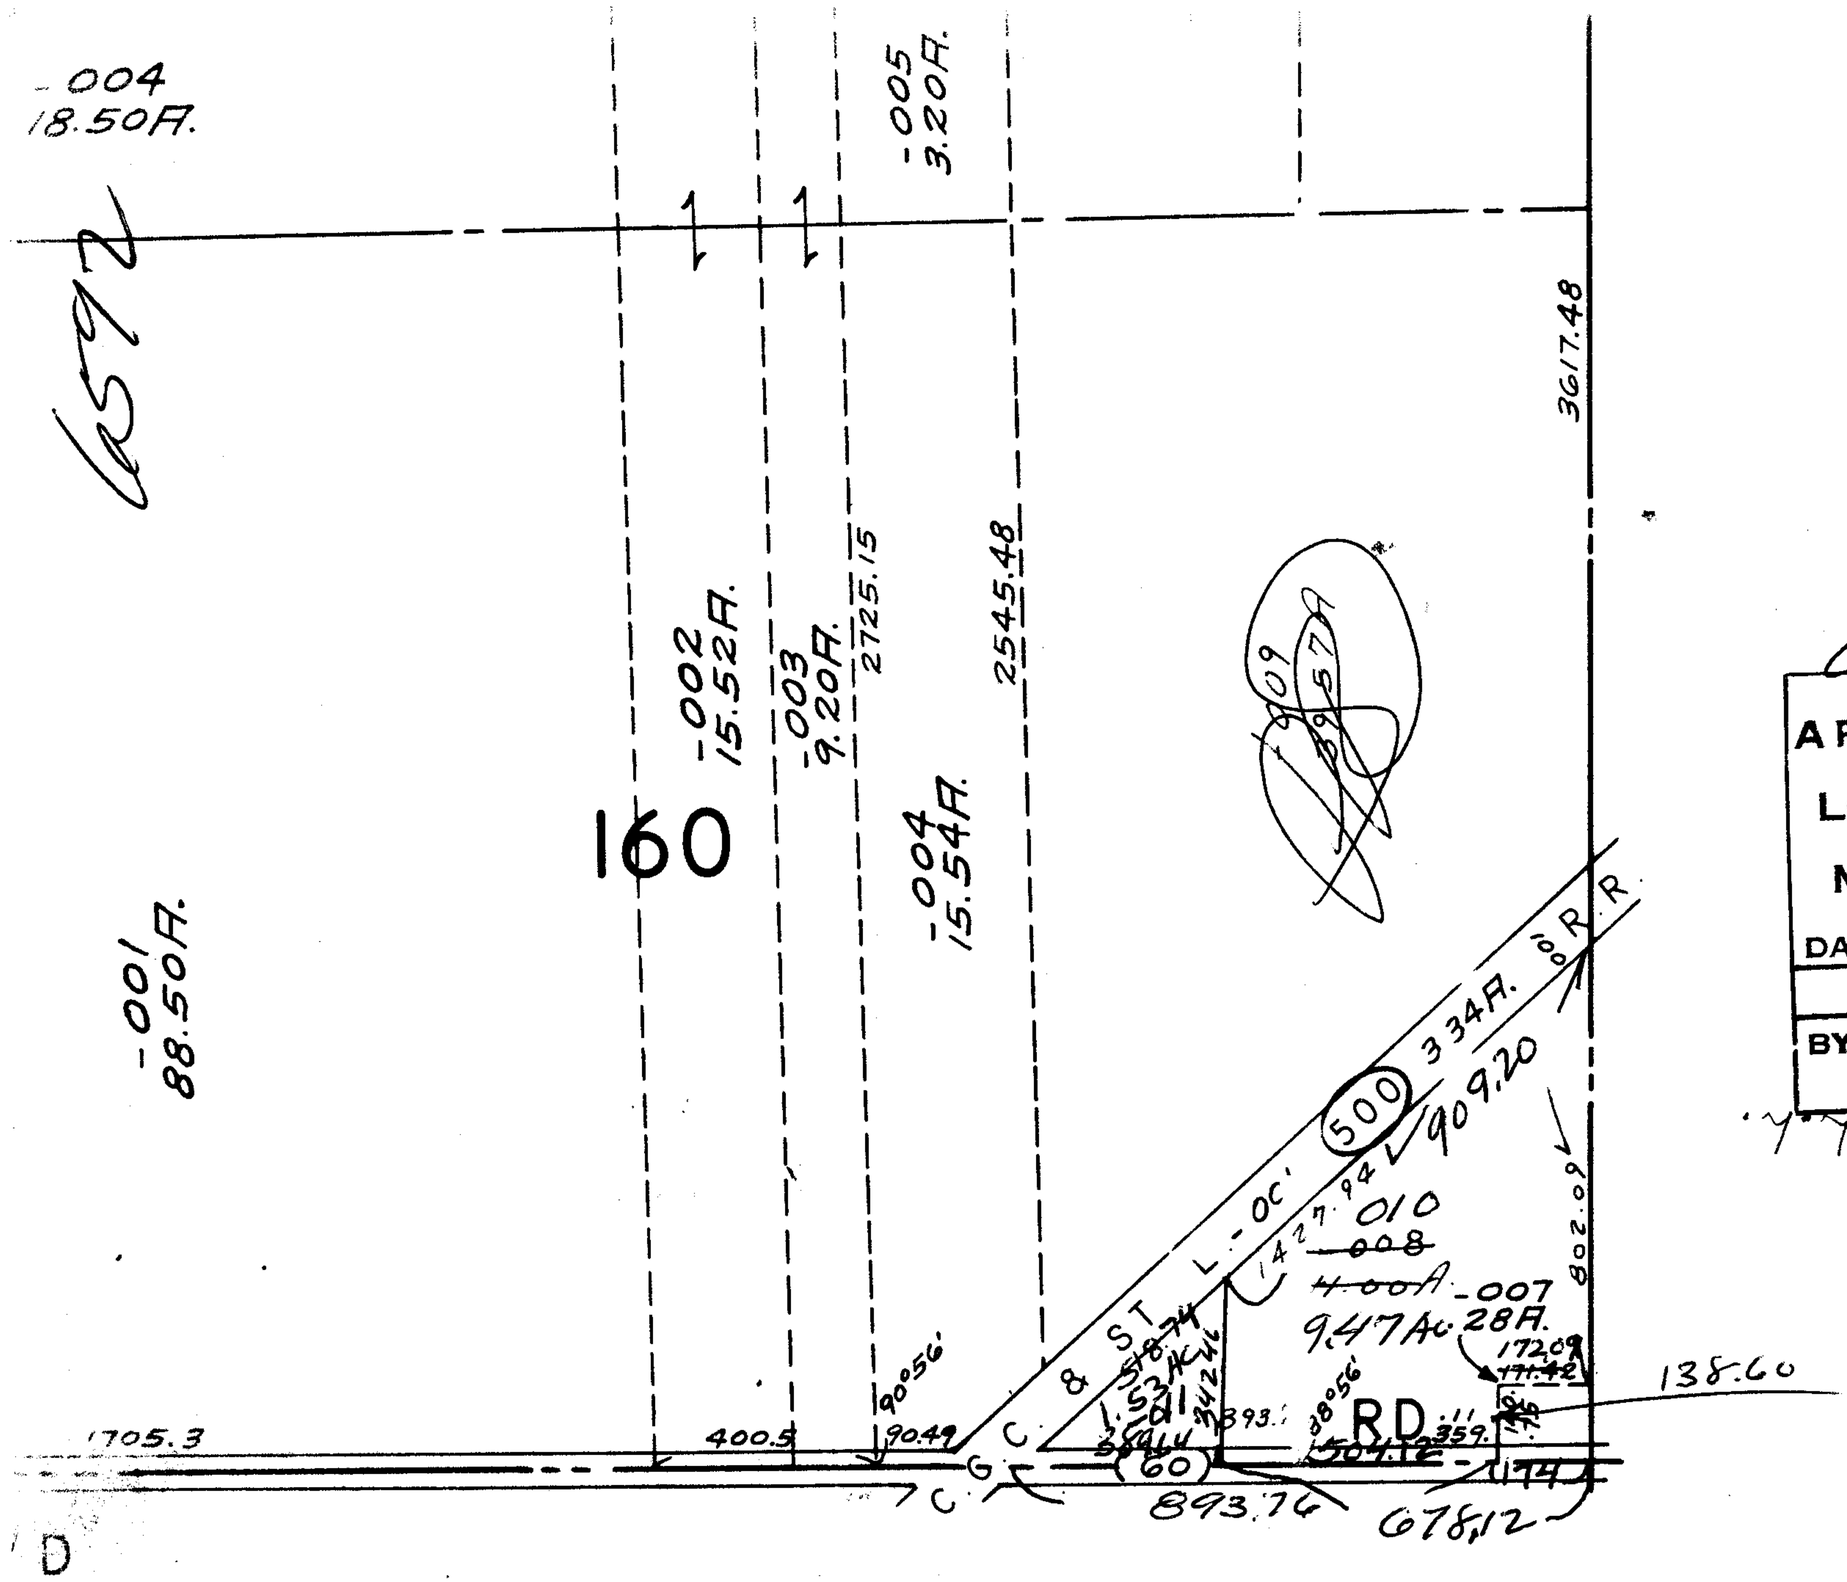

6592

APPROVED
LORAIN CO.
MAP DEPT.
DATE 12-14-72
14 H
BY LW Hall

LOTS 81, 82, 99 THRU 102, 119
THRU 122, 139 THRU 142, 158, 160

Copyright 1963

Revised 6-1-72

K-H