


6596

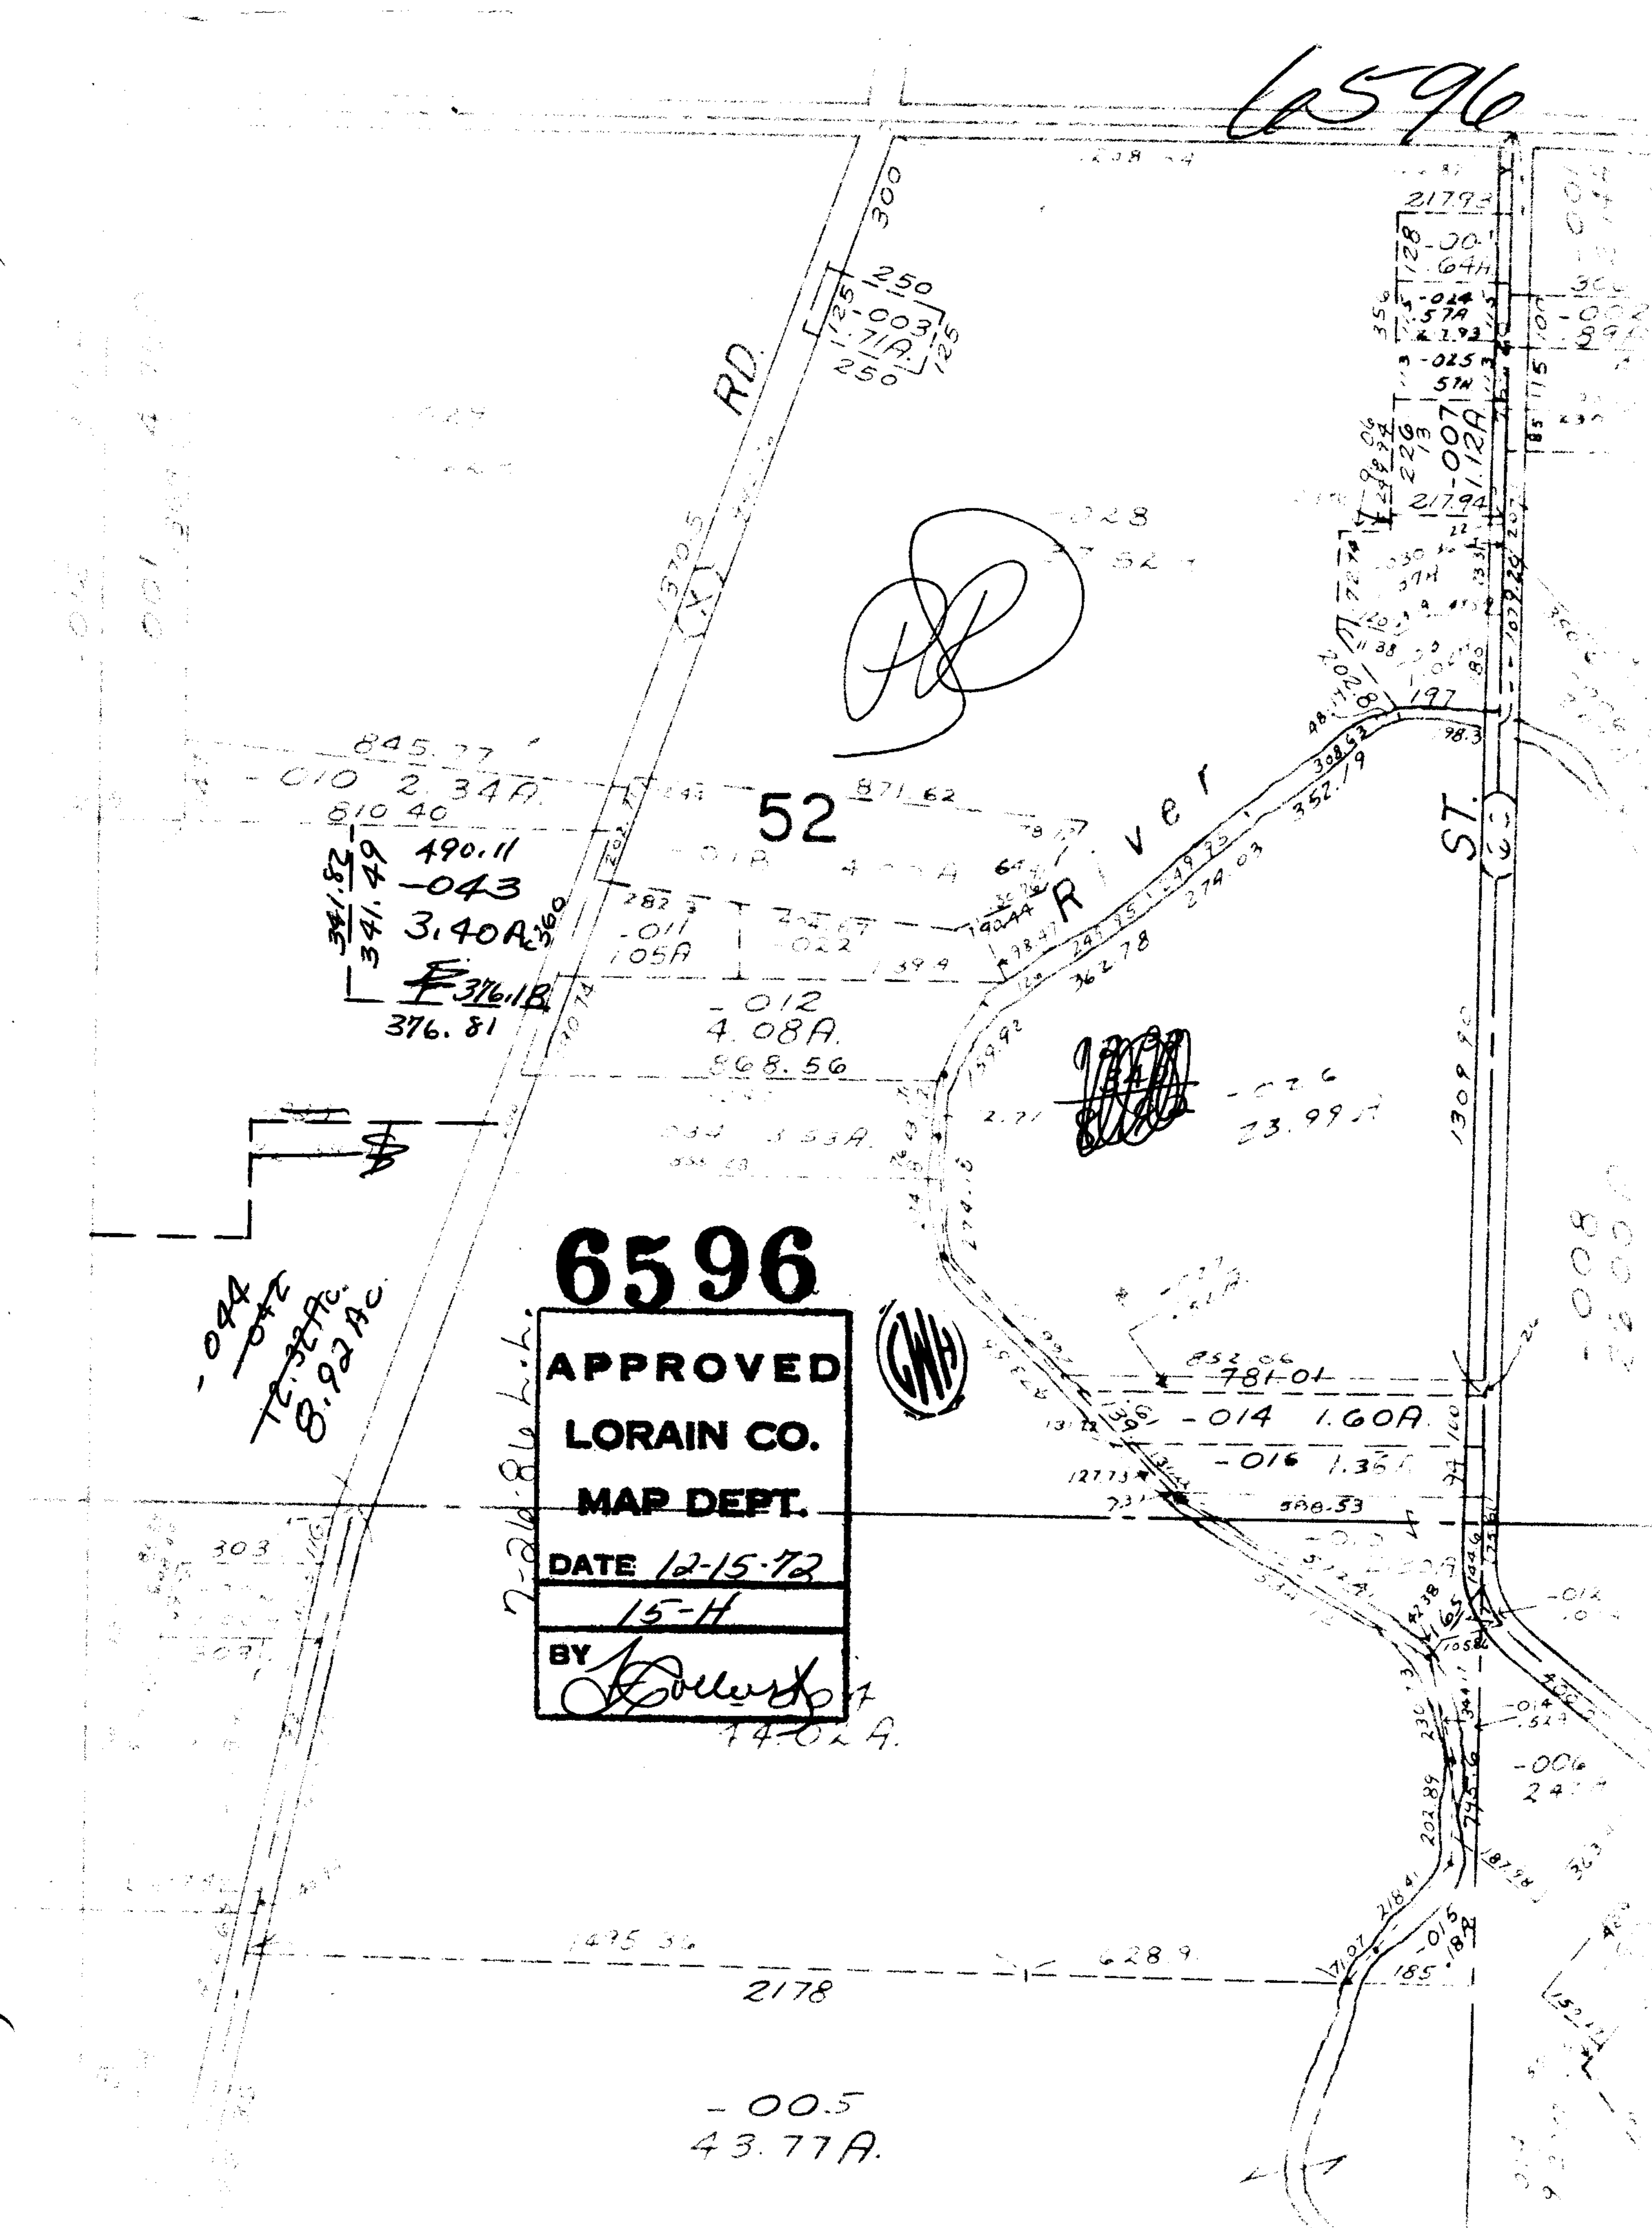

6596

**APPROVED**  
**LORAIN CO.**  
**MAP DEPT.**  
**DATE 12-15-72**  
**15-H**  
**BY [Signature]**

-044  
-042  
72-327A  
8.92 AC

341.82  
341.49  
490.11  
-043  
3.40A  
F 376.11B  
376.81

52

-012  
4.08A  
868.56

-005  
43.77A

-026  
23.99A

-014 1.60A

-016 1.36A

-008  
26.00A