6603

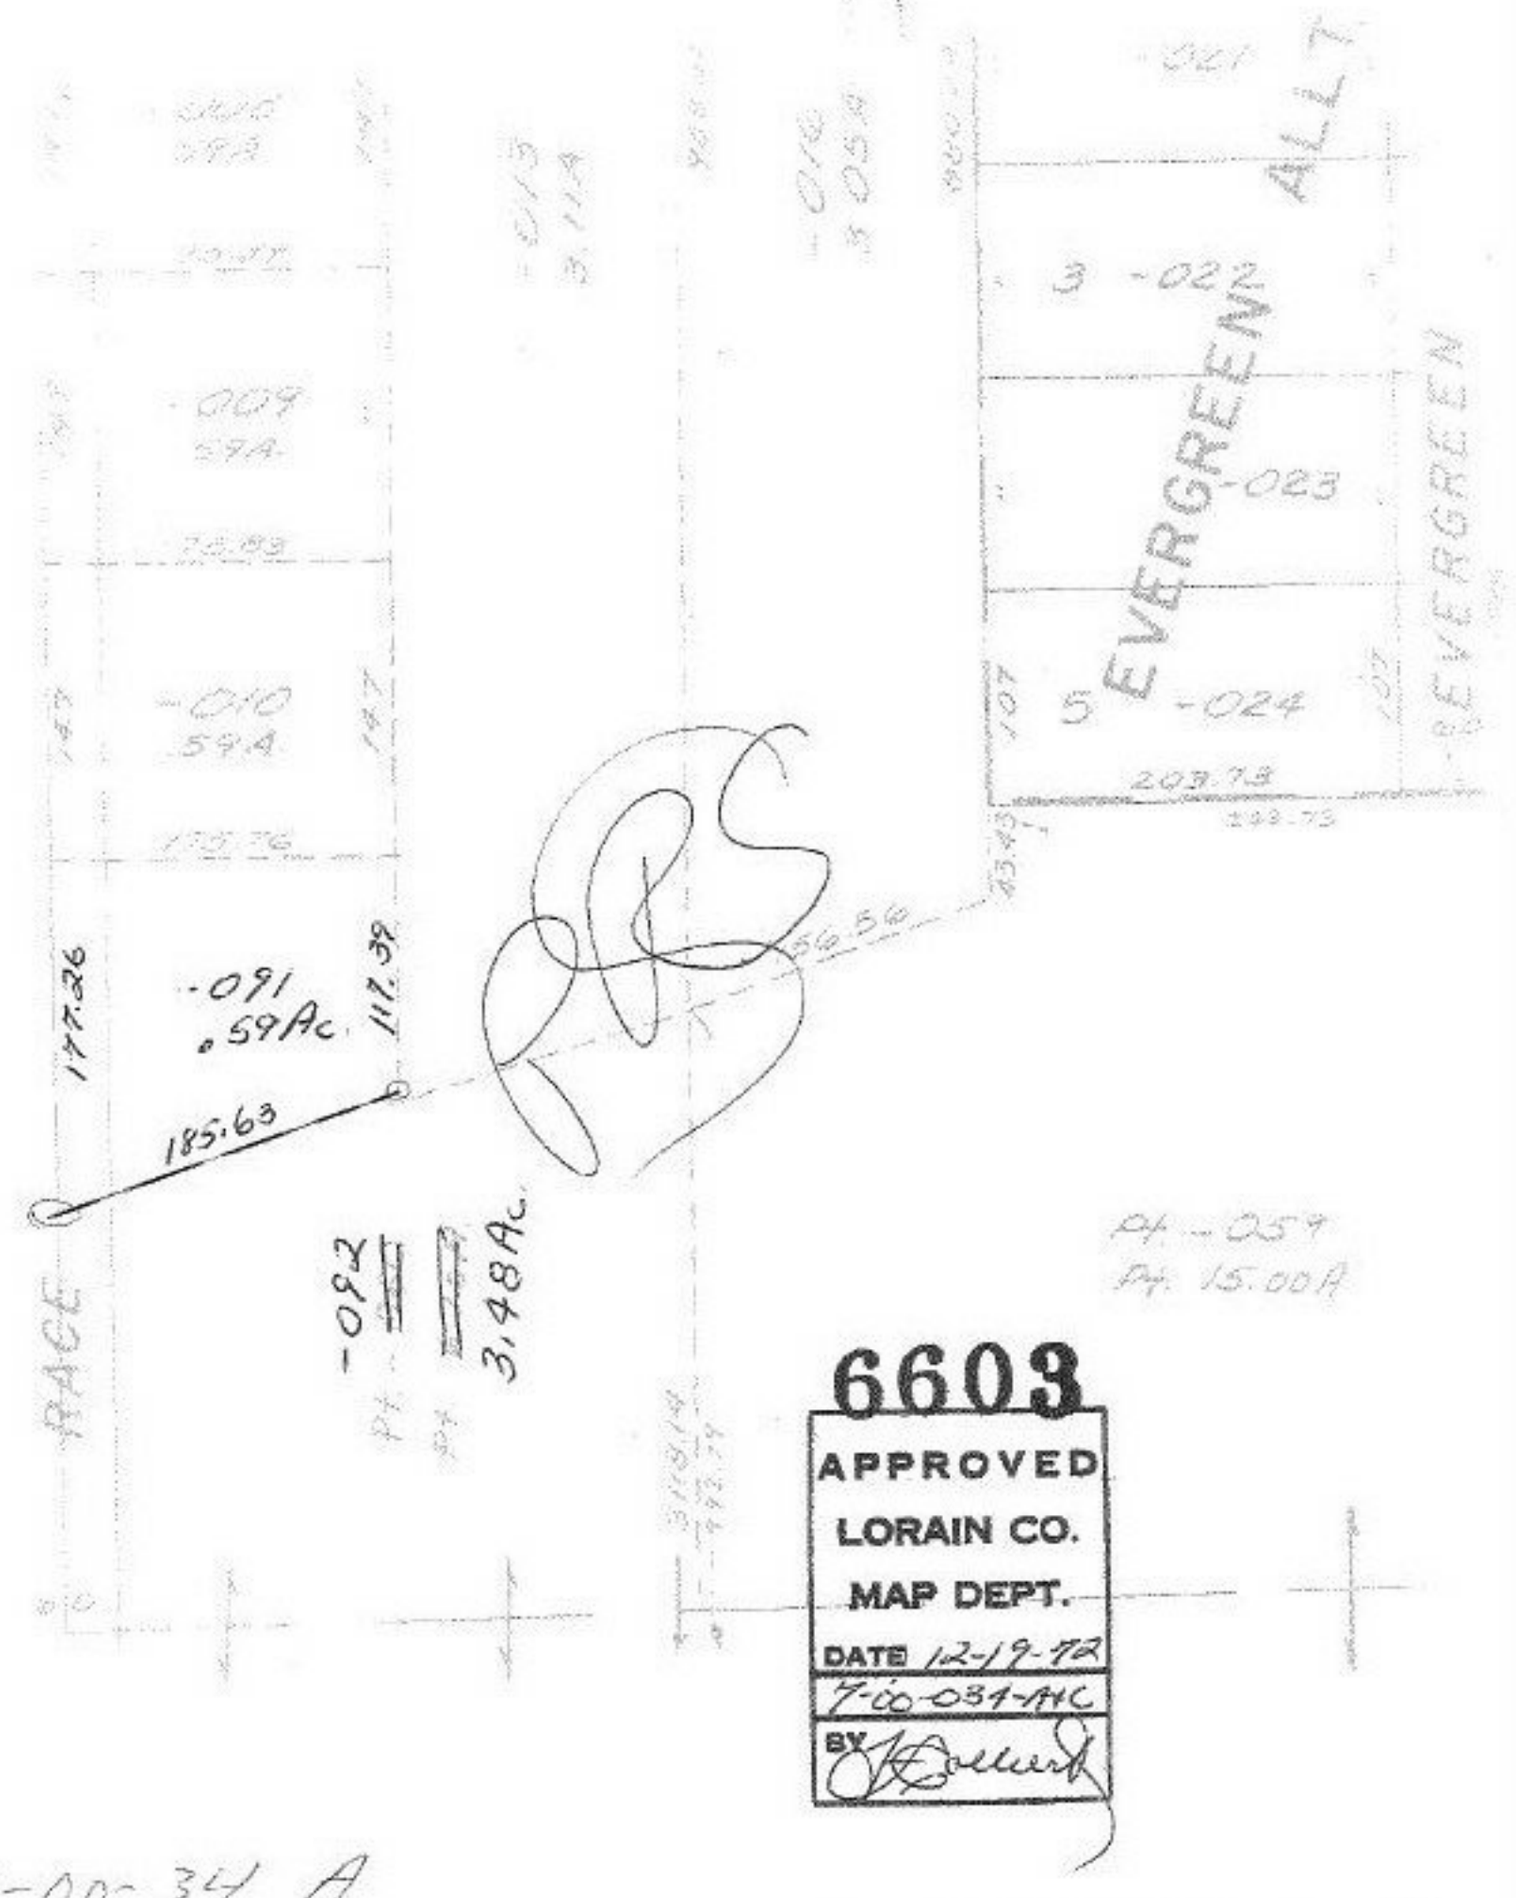

7-00-34 A

RIDGEVILLE