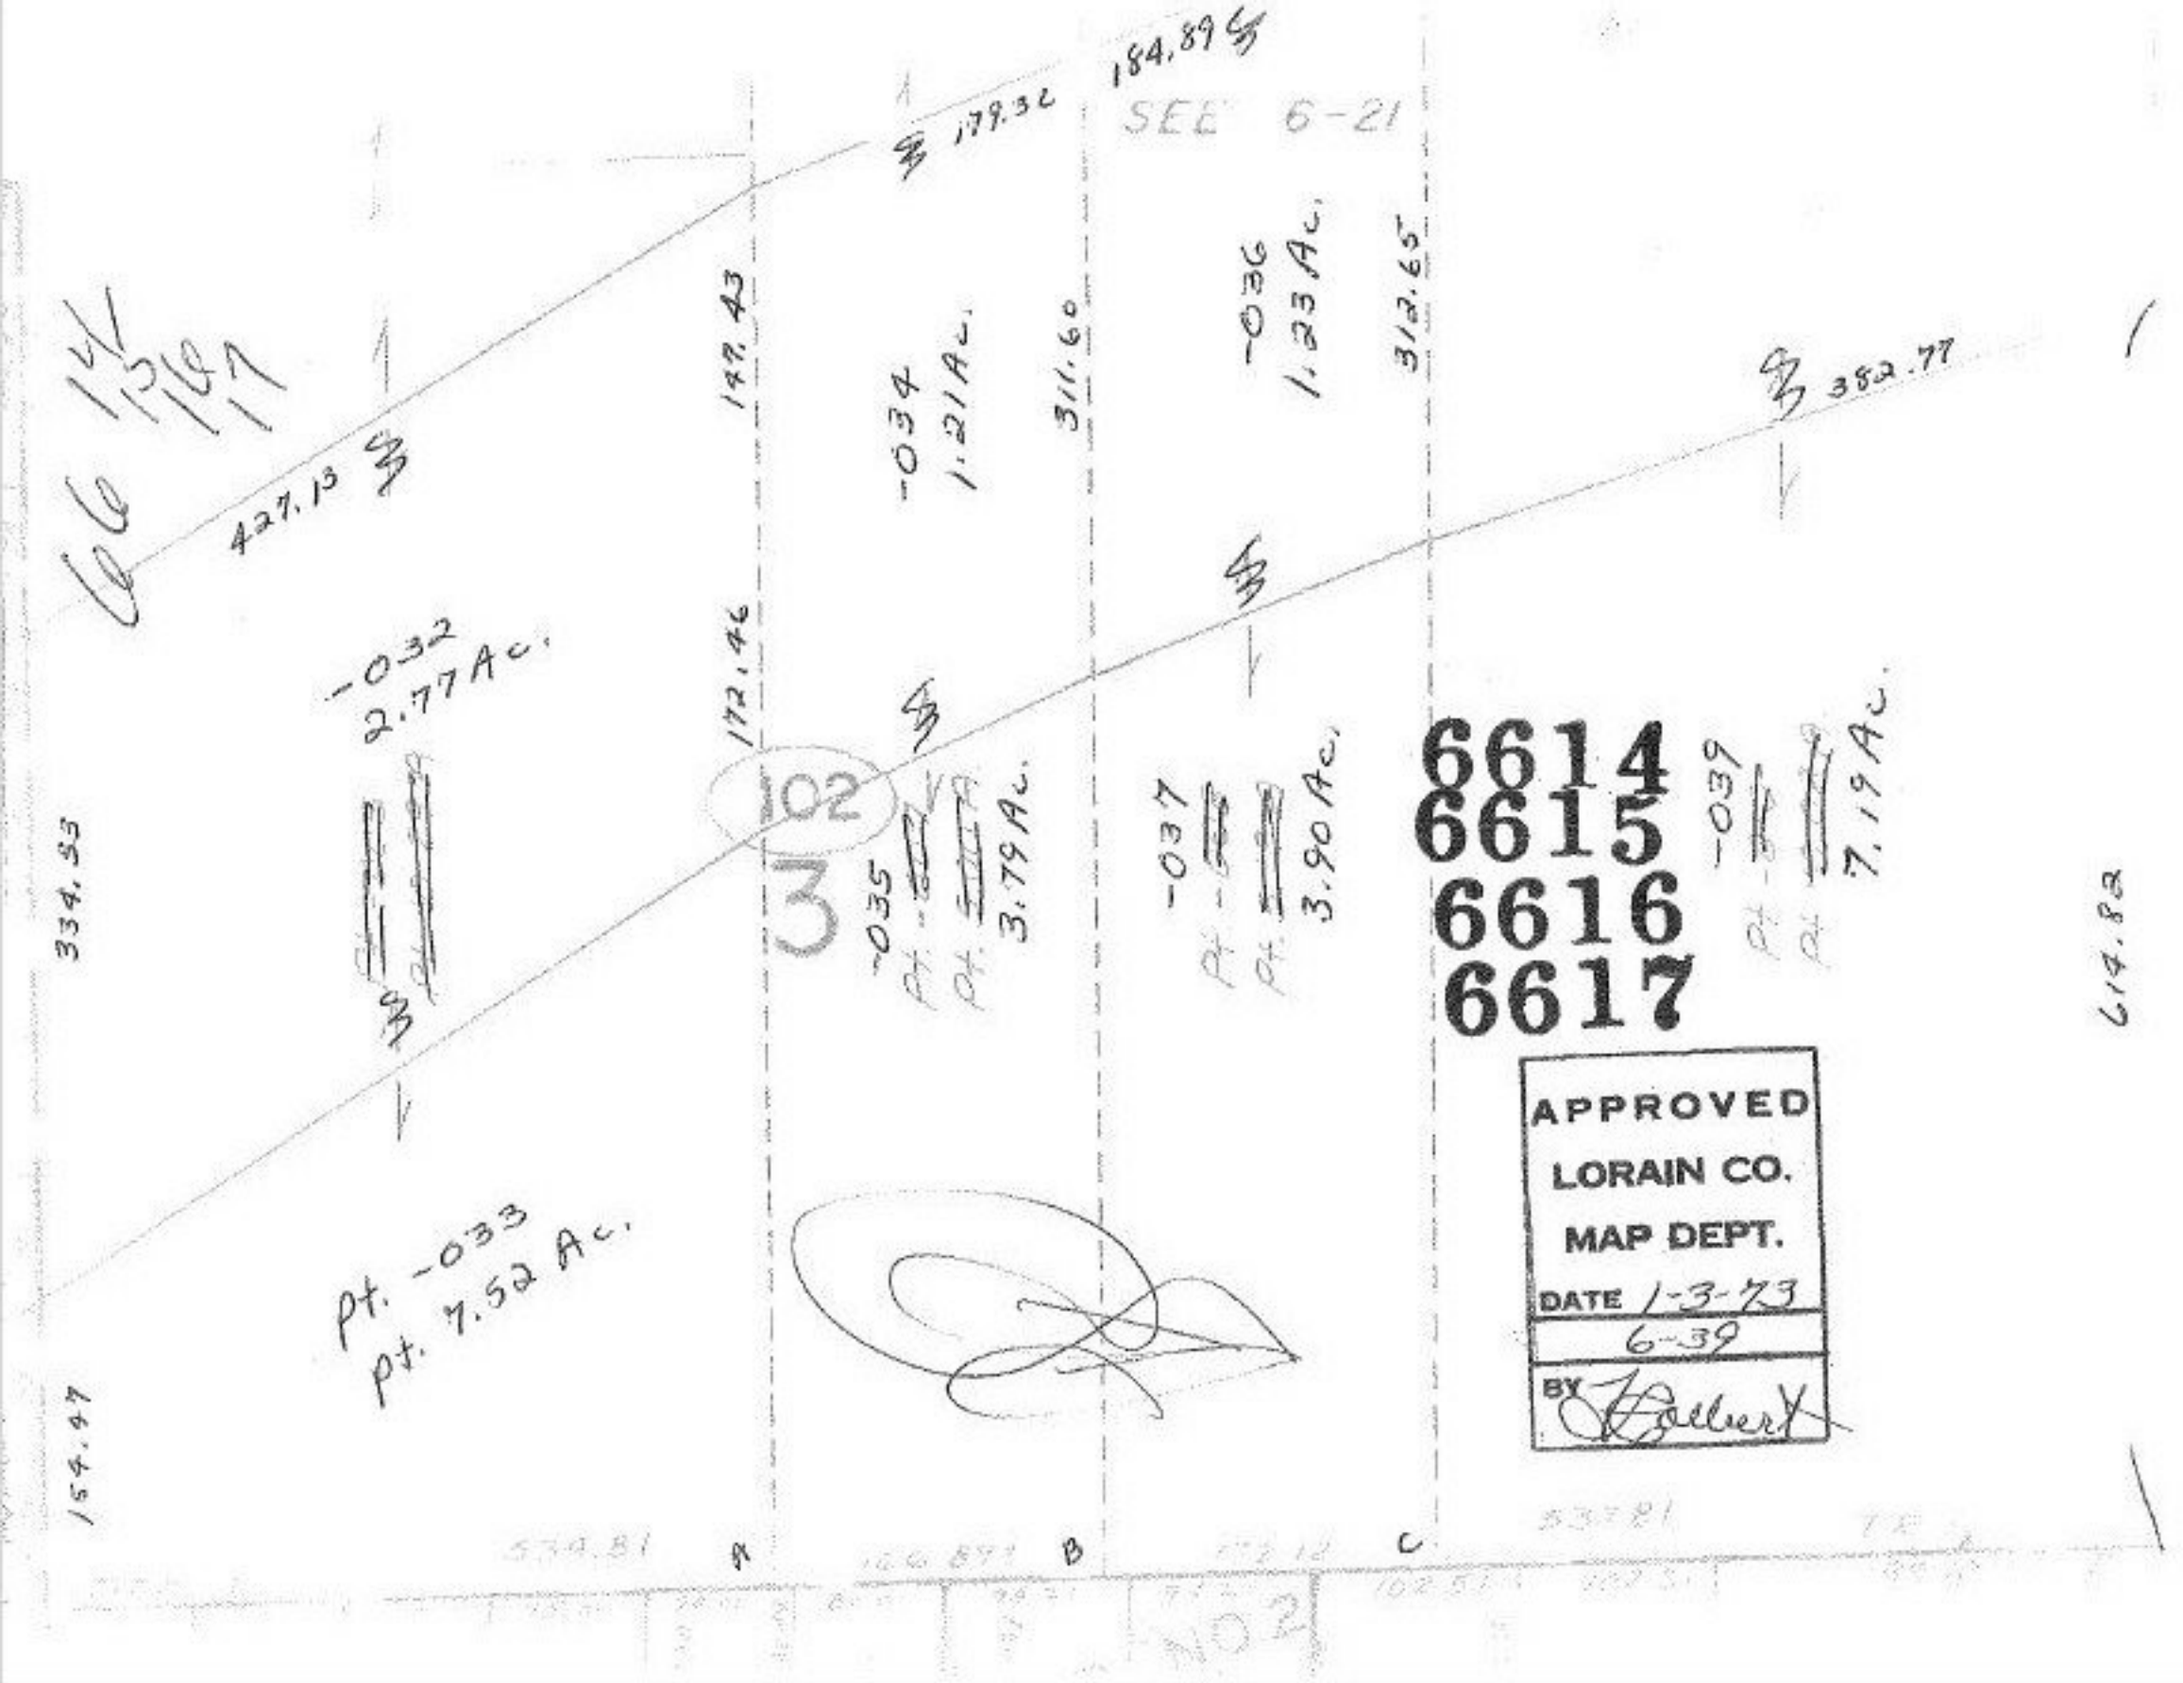

184.89
179.32
SEE 6-21
66 14 15 16 17
427.13
147.43
-034
1.21 Ac.
311.60
-036
1.23 Ac.
312.65
382.77
-032
2.77 Ac.
172.46
102
3
-035
3.79 Ac.
-037
3.90 Ac.
6614
6615
6616
6617
-039
7.19 Ac.
334.33
614.82
pt. -033
pt. 7.52 Ac.
154.47
APPROVED
LORAIN CO.
MAP DEPT.
DATE 1-3-73
6-39
BY
A
B
C
NO 2