


617.90
200.33
1320.67
2398.90
1997.25

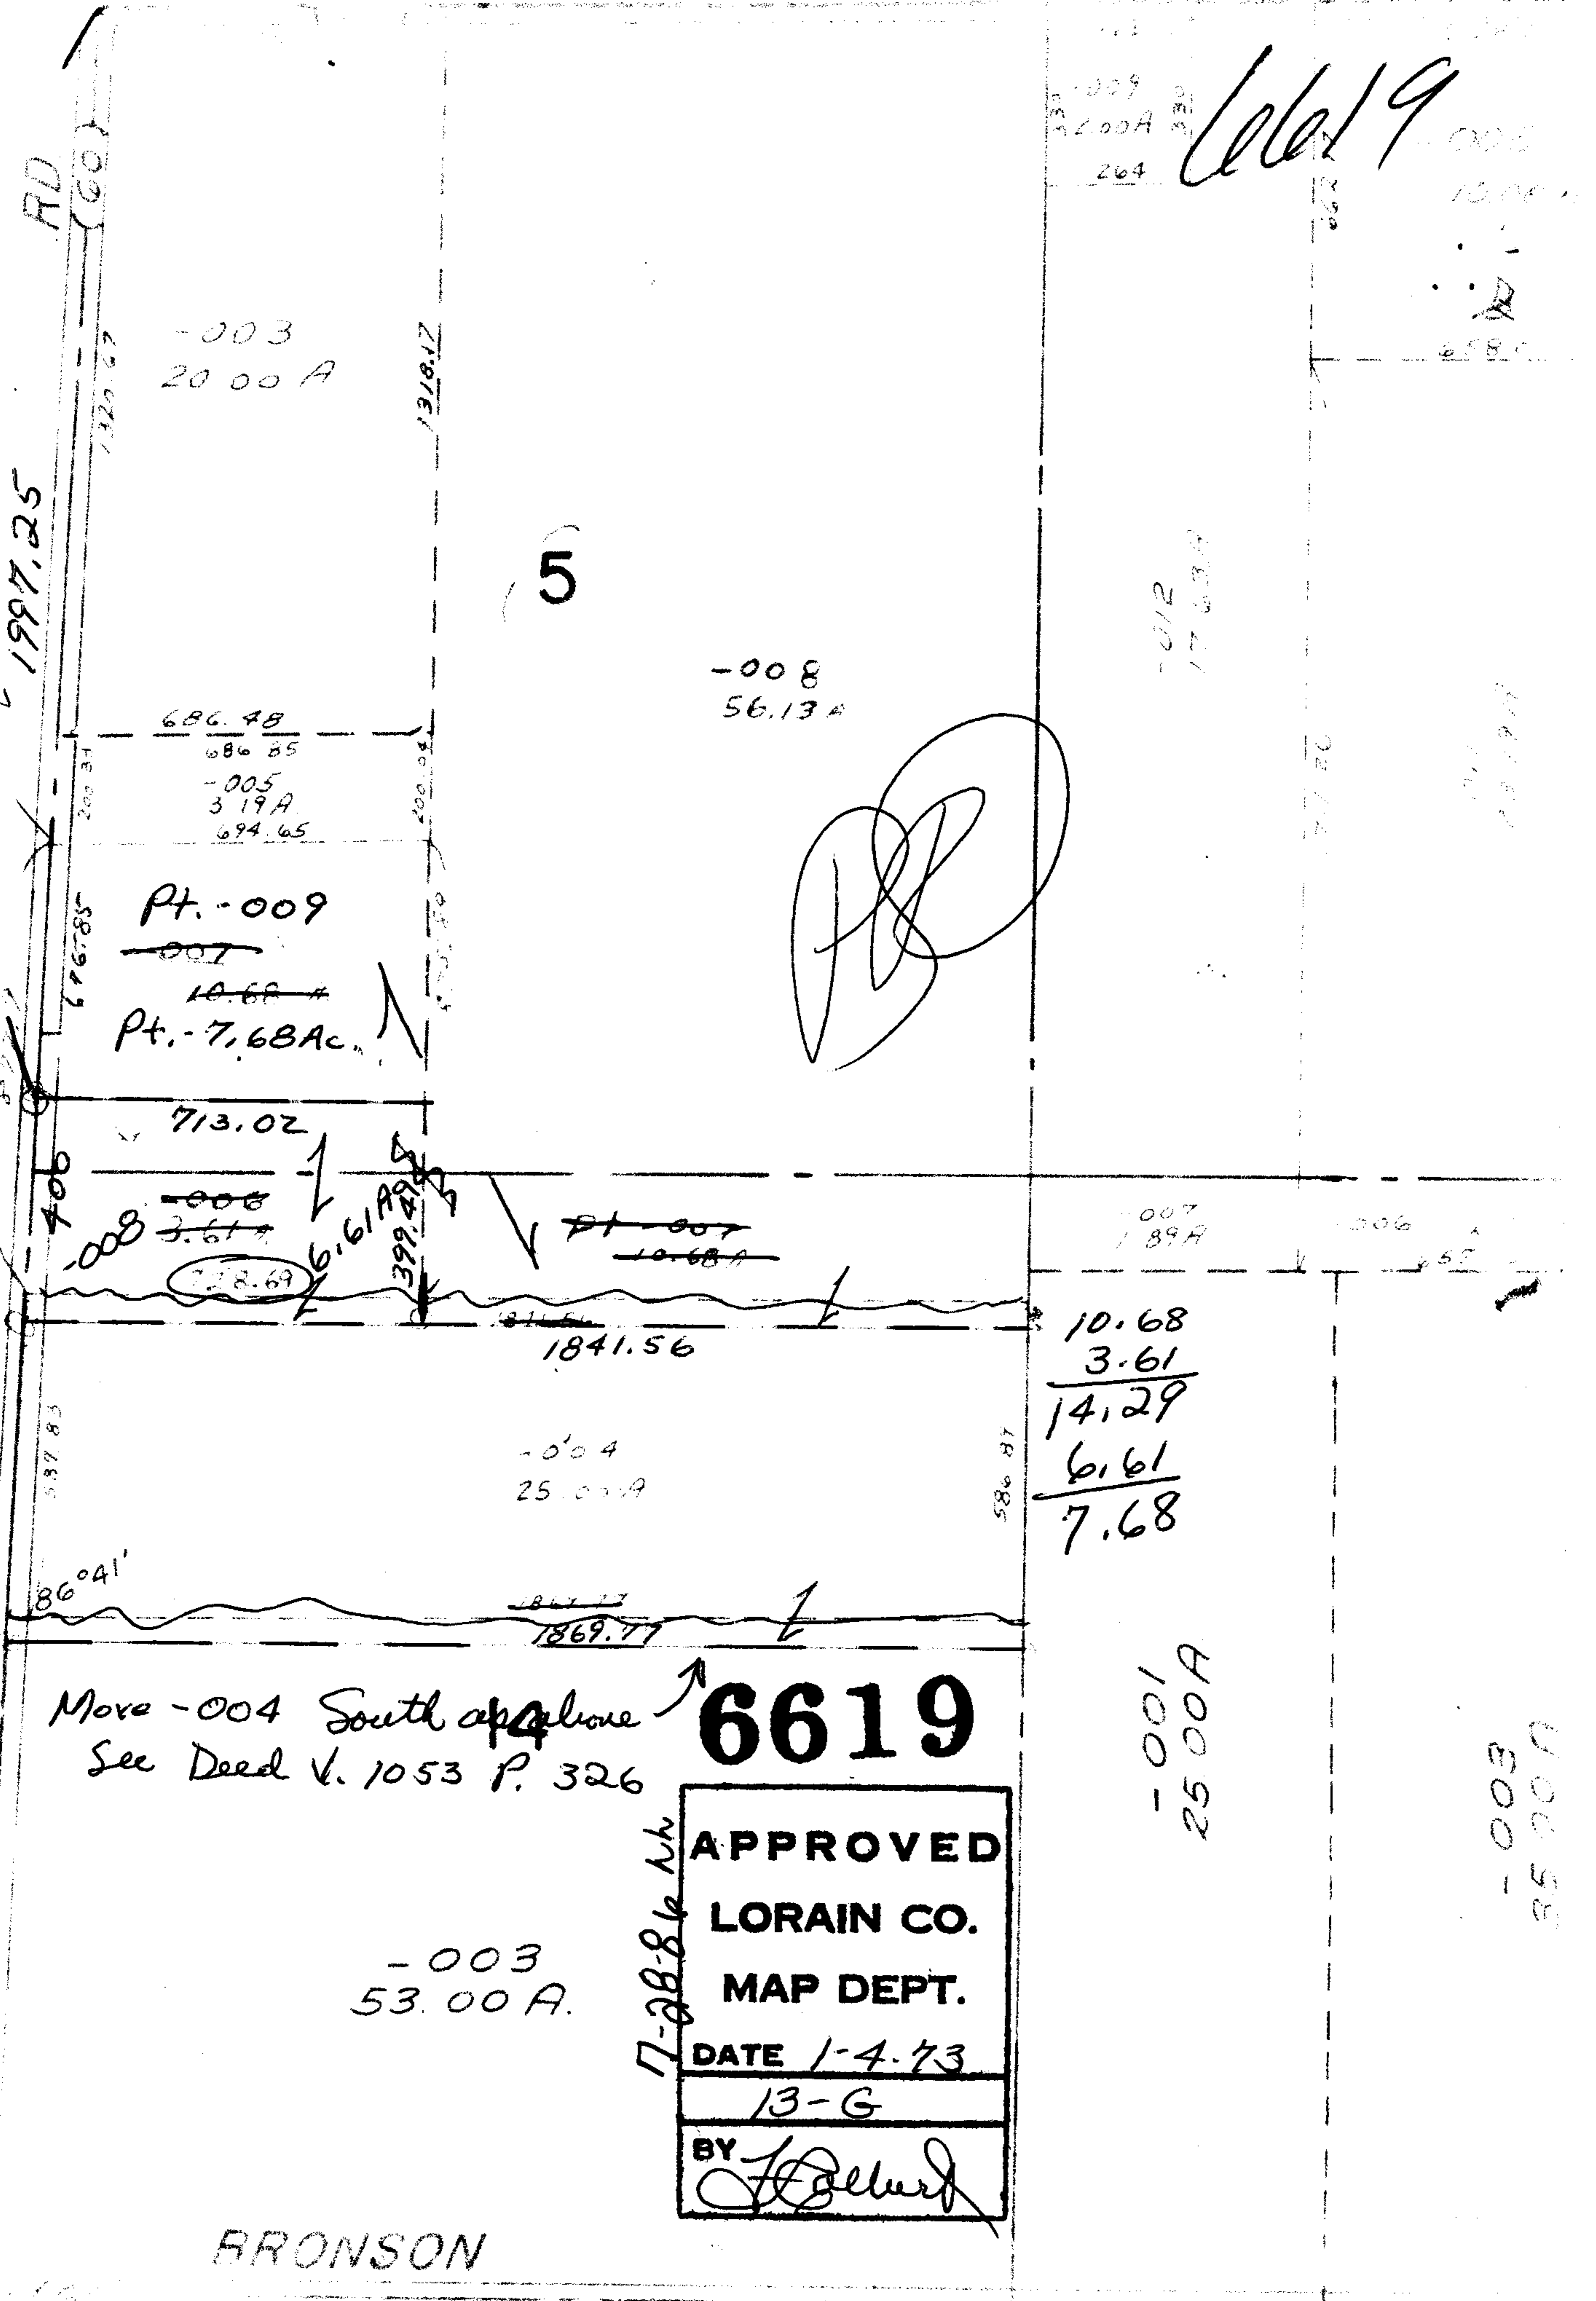

6619

5

Move -004 South as shown
See Deed V. 1053 P. 326

6619

APPROVED
LORAIN CO.
MAP DEPT.
DATE 1-4-73
13-G
BY *Hollard*

BRONSON

-001
25.00 A

-003
35.00 A