


254

SEE

SEE 6621

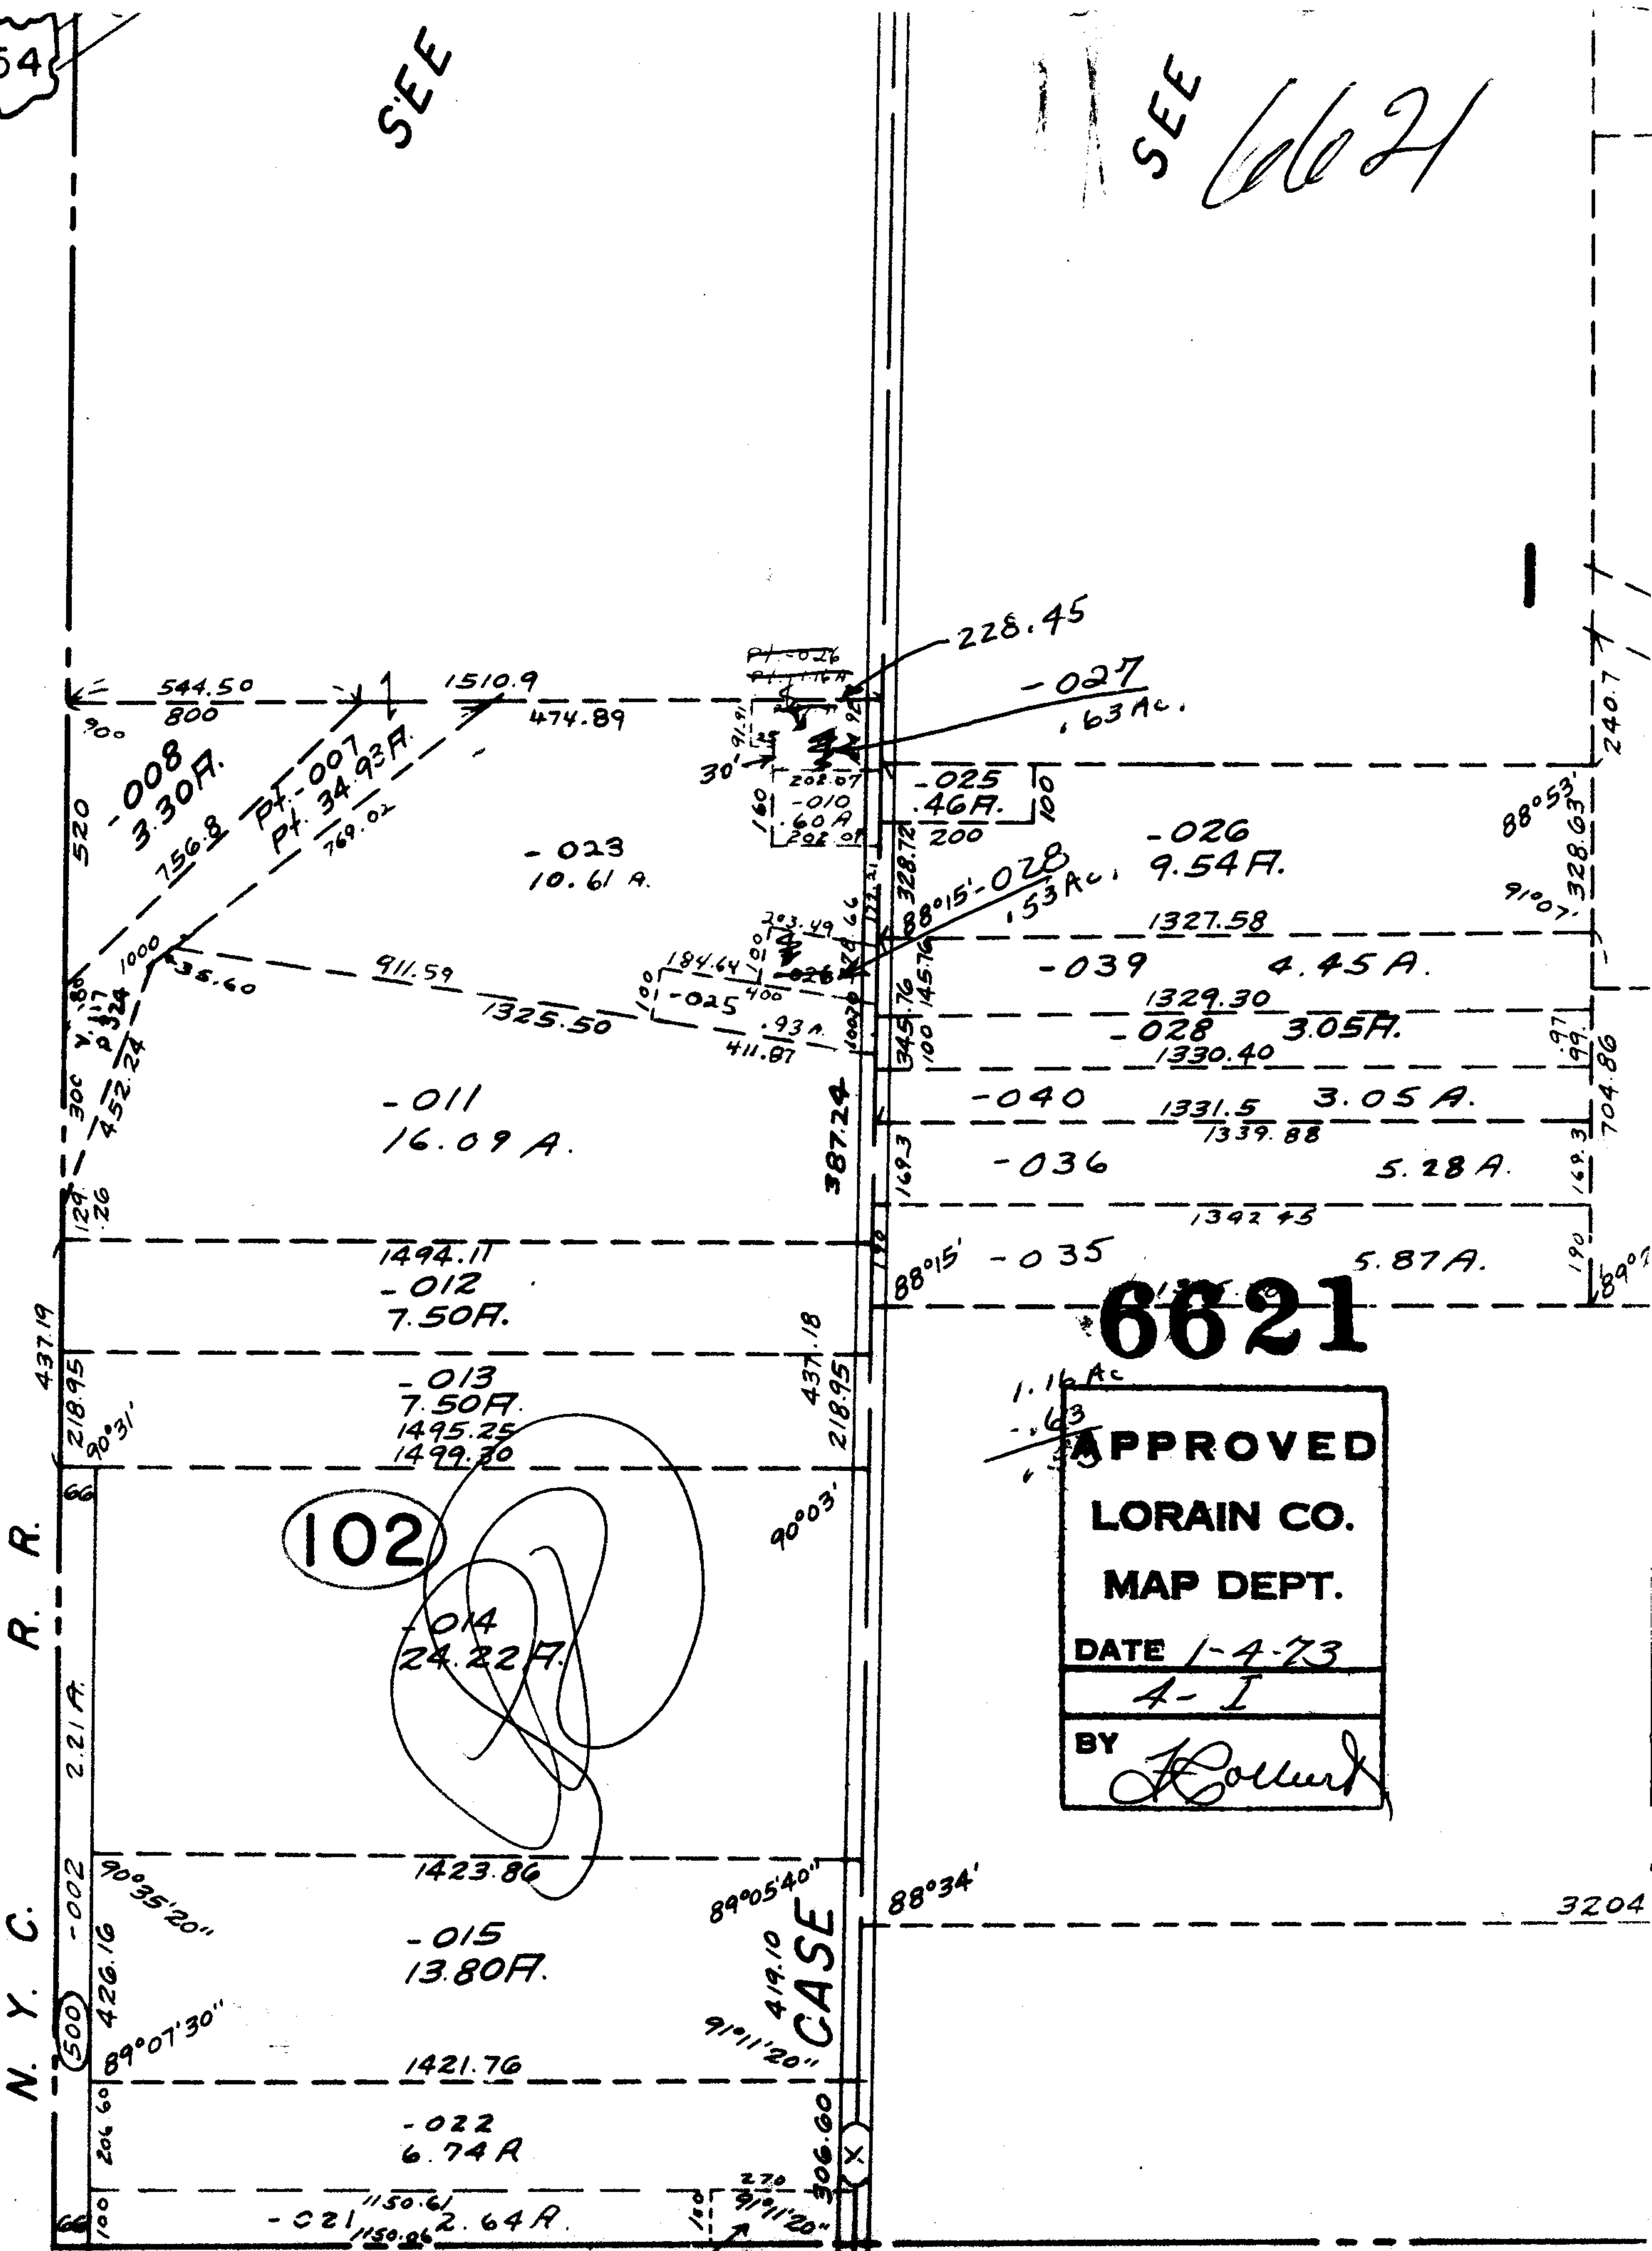

6621

1.16 Ac
63

APPROVED
LORAIN CO.
MAP DEPT.
 DATE 1-4-73
 4-I
 BY *[Signature]*

SEE 7-