


6638 6638

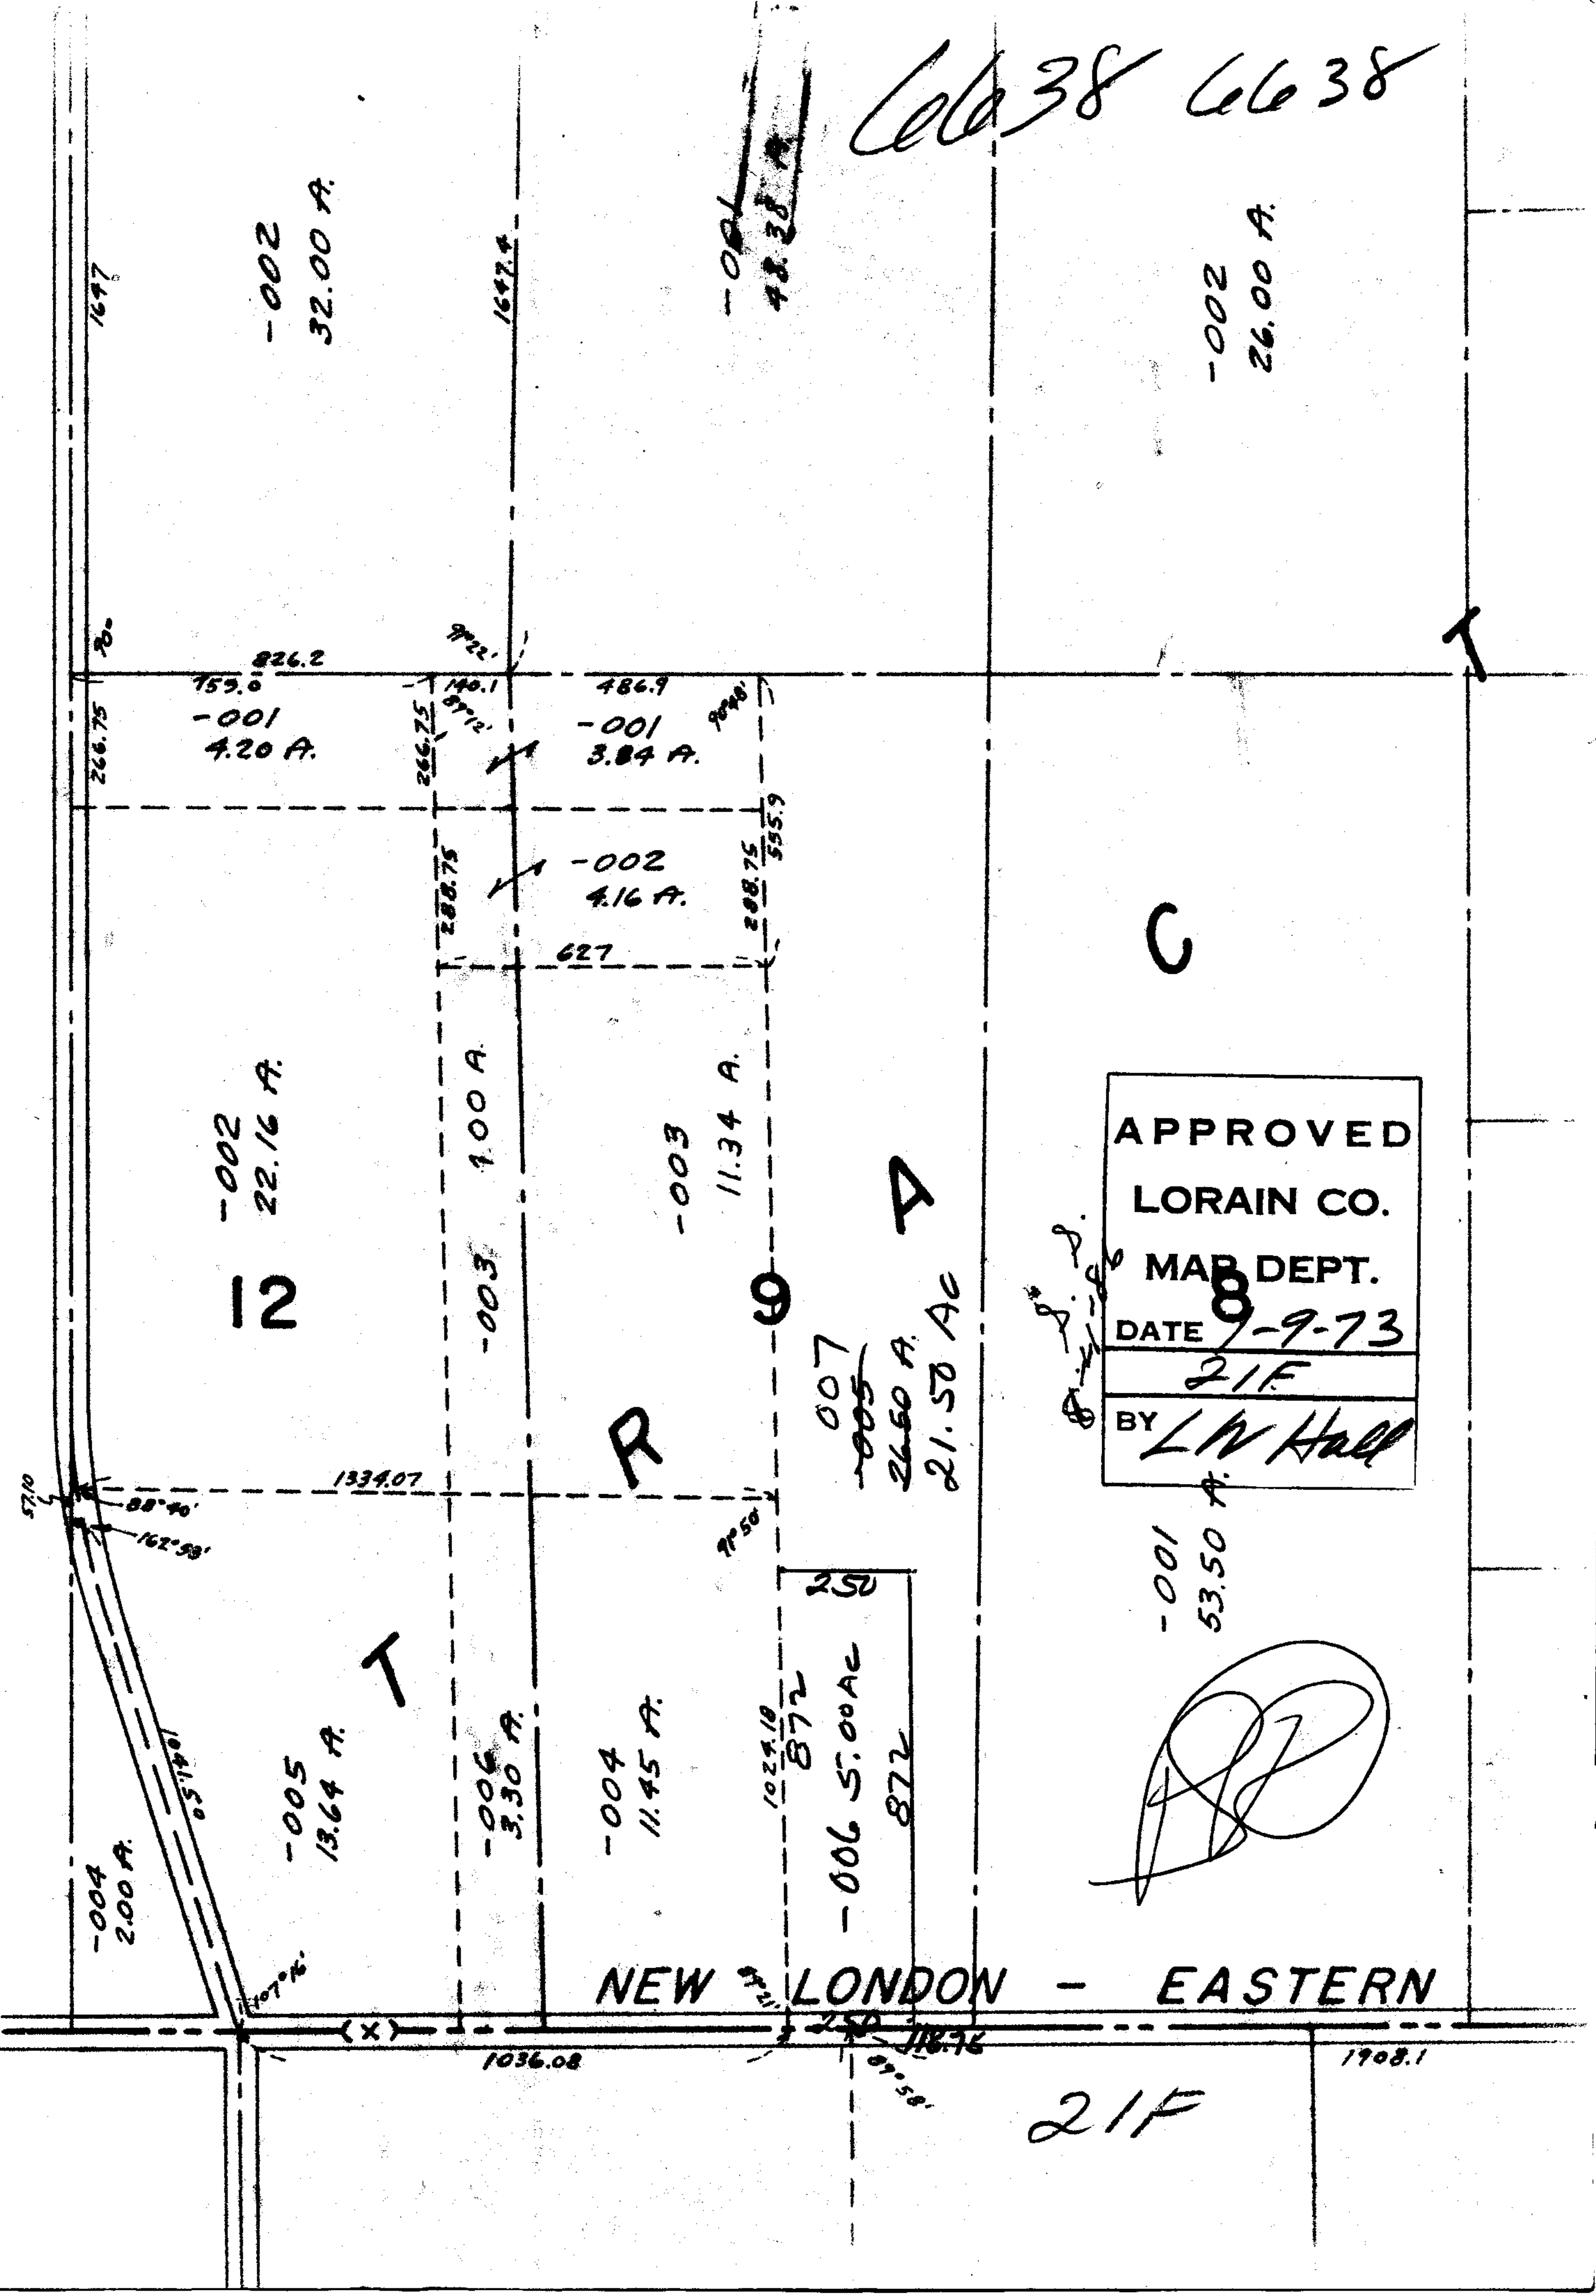

APPROVED
 LORAIN CO.
 MAP DEPT.
 DATE 7-9-73
 BY L.V. Hall

NEW LONDON - EASTERN

21F

[Handwritten Signature]

12

R

9

C

T

-002
32.00 A.

-001
48.38 A.

-002
26.00 A.

-001
4.20 A.

-001
3.84 A.

-002
4.16 A.

-002
22.16 A.

-003
11.34 A.

007
26.50 A.
21.50 AC

-001
53.50 A.

-005
13.64 A.

-006
3.30 A.

-004
11.45 A.

-006
5.00 AC

-004
2.00 A.

872

872

1908.1

1036.08

118.76

(X)

5710

1697

1697.4

826.2

759.6

992.1

140.1

486.9

80

266.75

266.75

2890

288.75

288.75

555.9

627

1334.07

7956

164.50

107.16

1024.18

250

250