



6642
 APPROVED
 LORAIN CO.
 MAP DEPT.
 DATE 1-10-73
 2-01-008A
 BY LWHall

7-21-86
 S.S.

CMOK

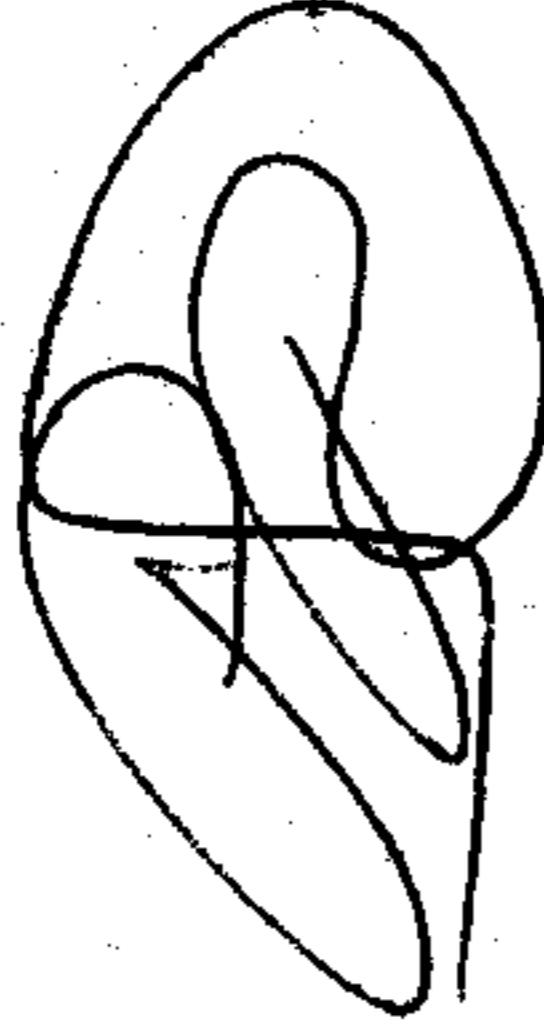

06-B

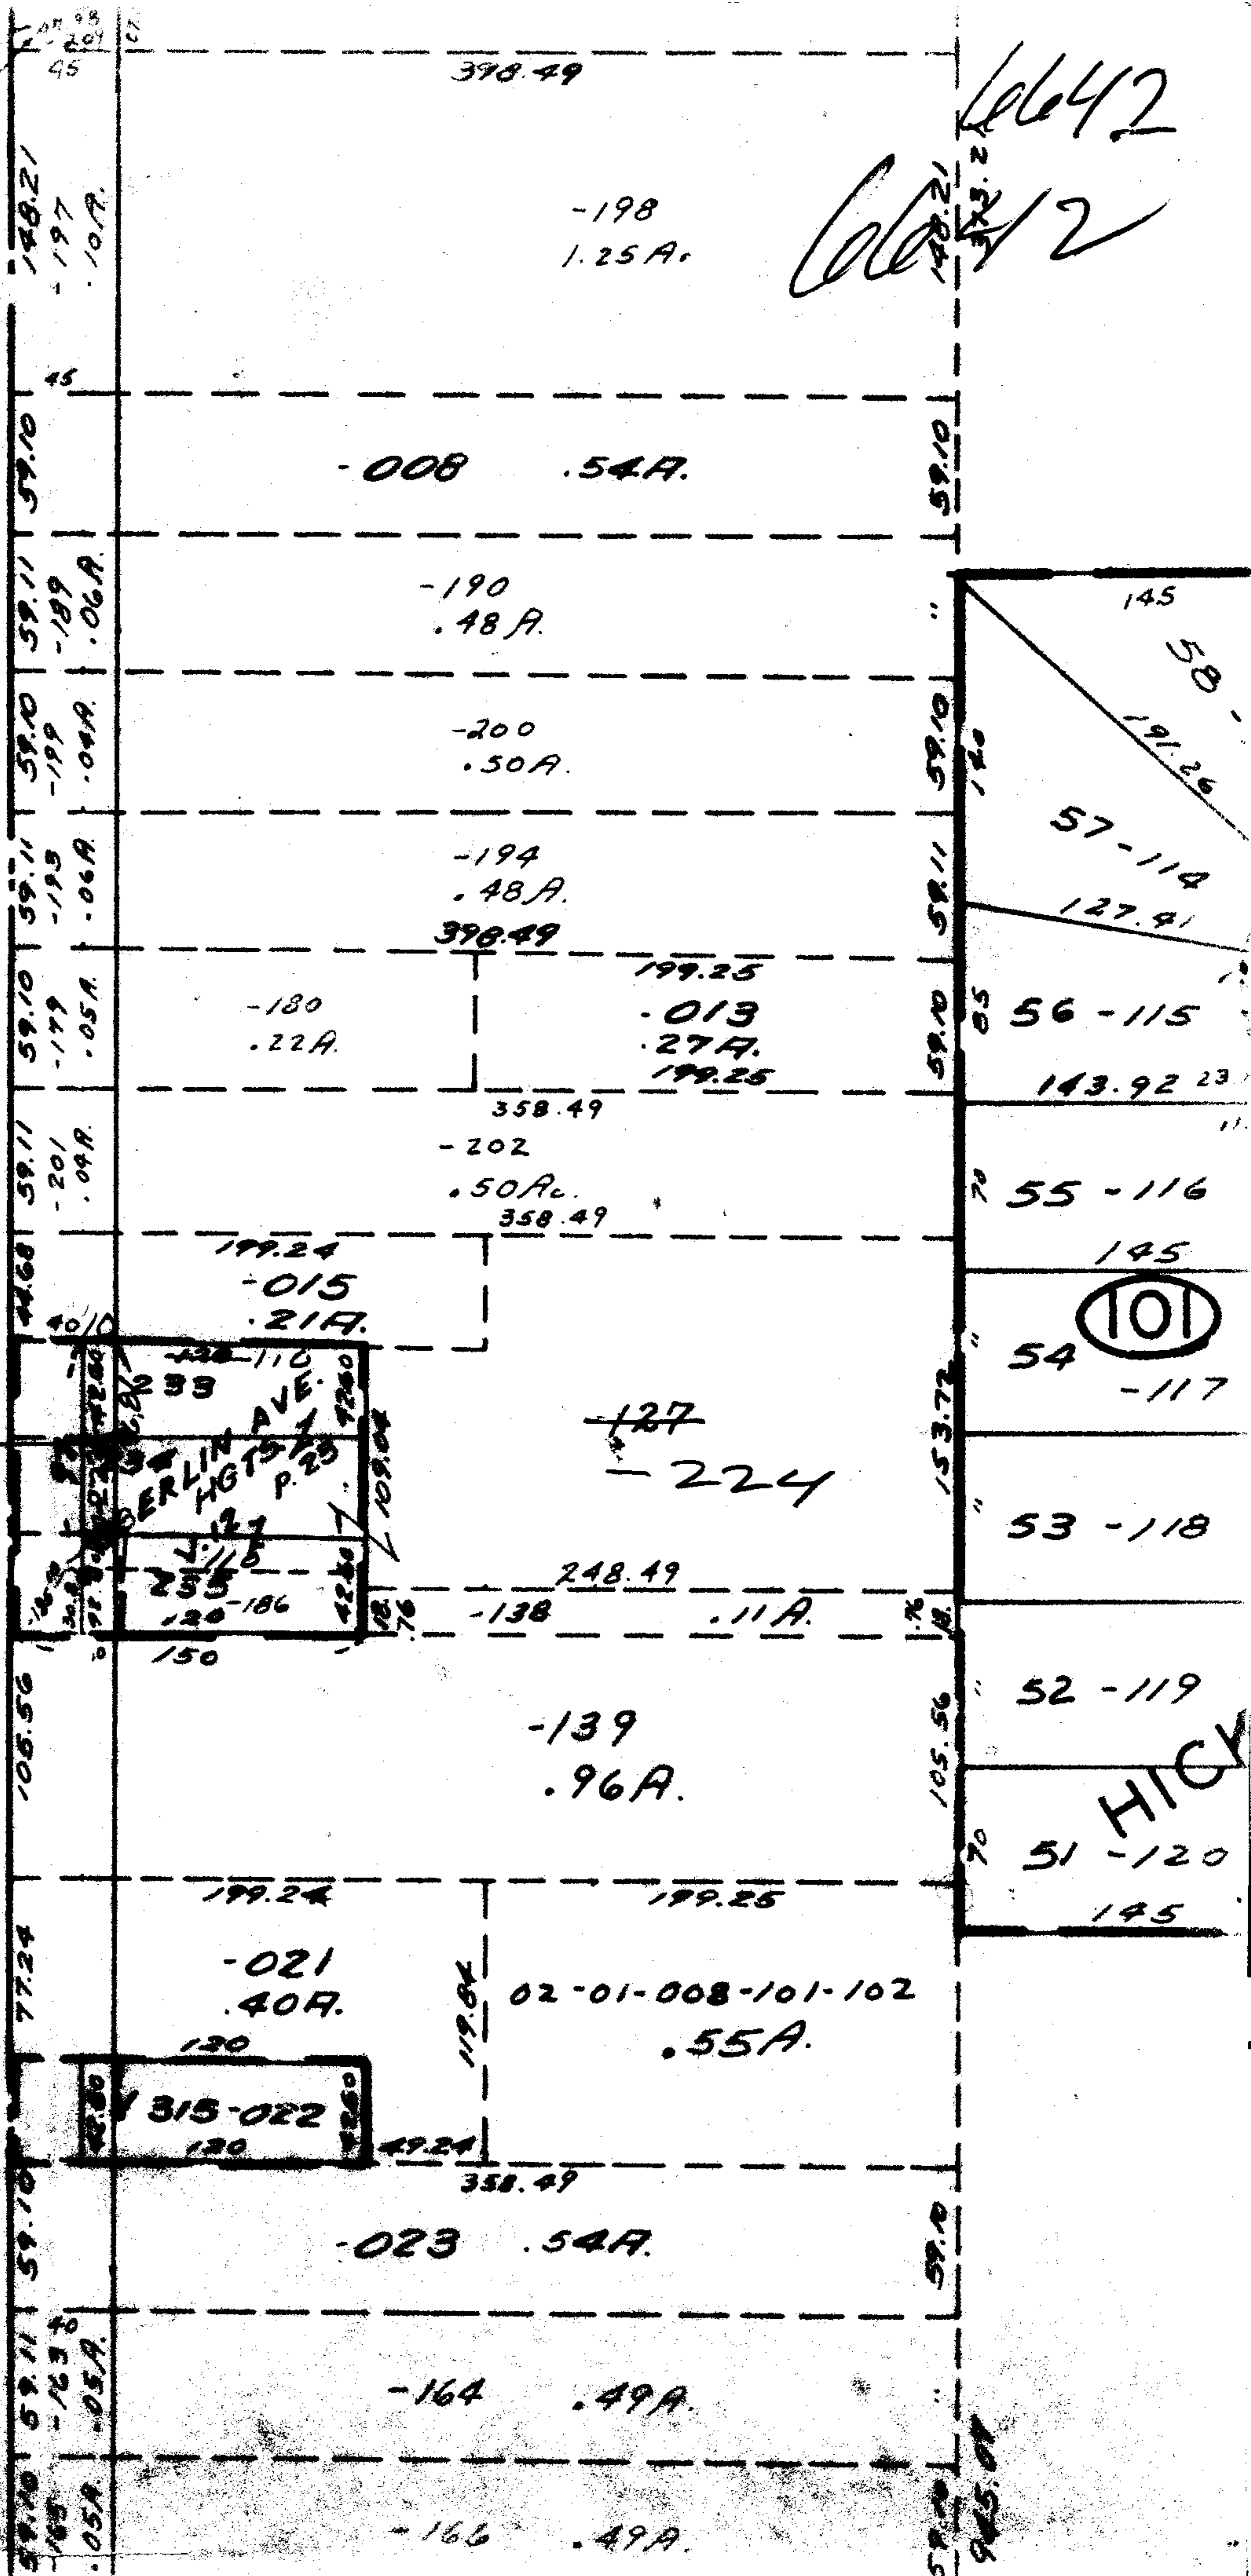

6642
 6642

6642

HICK