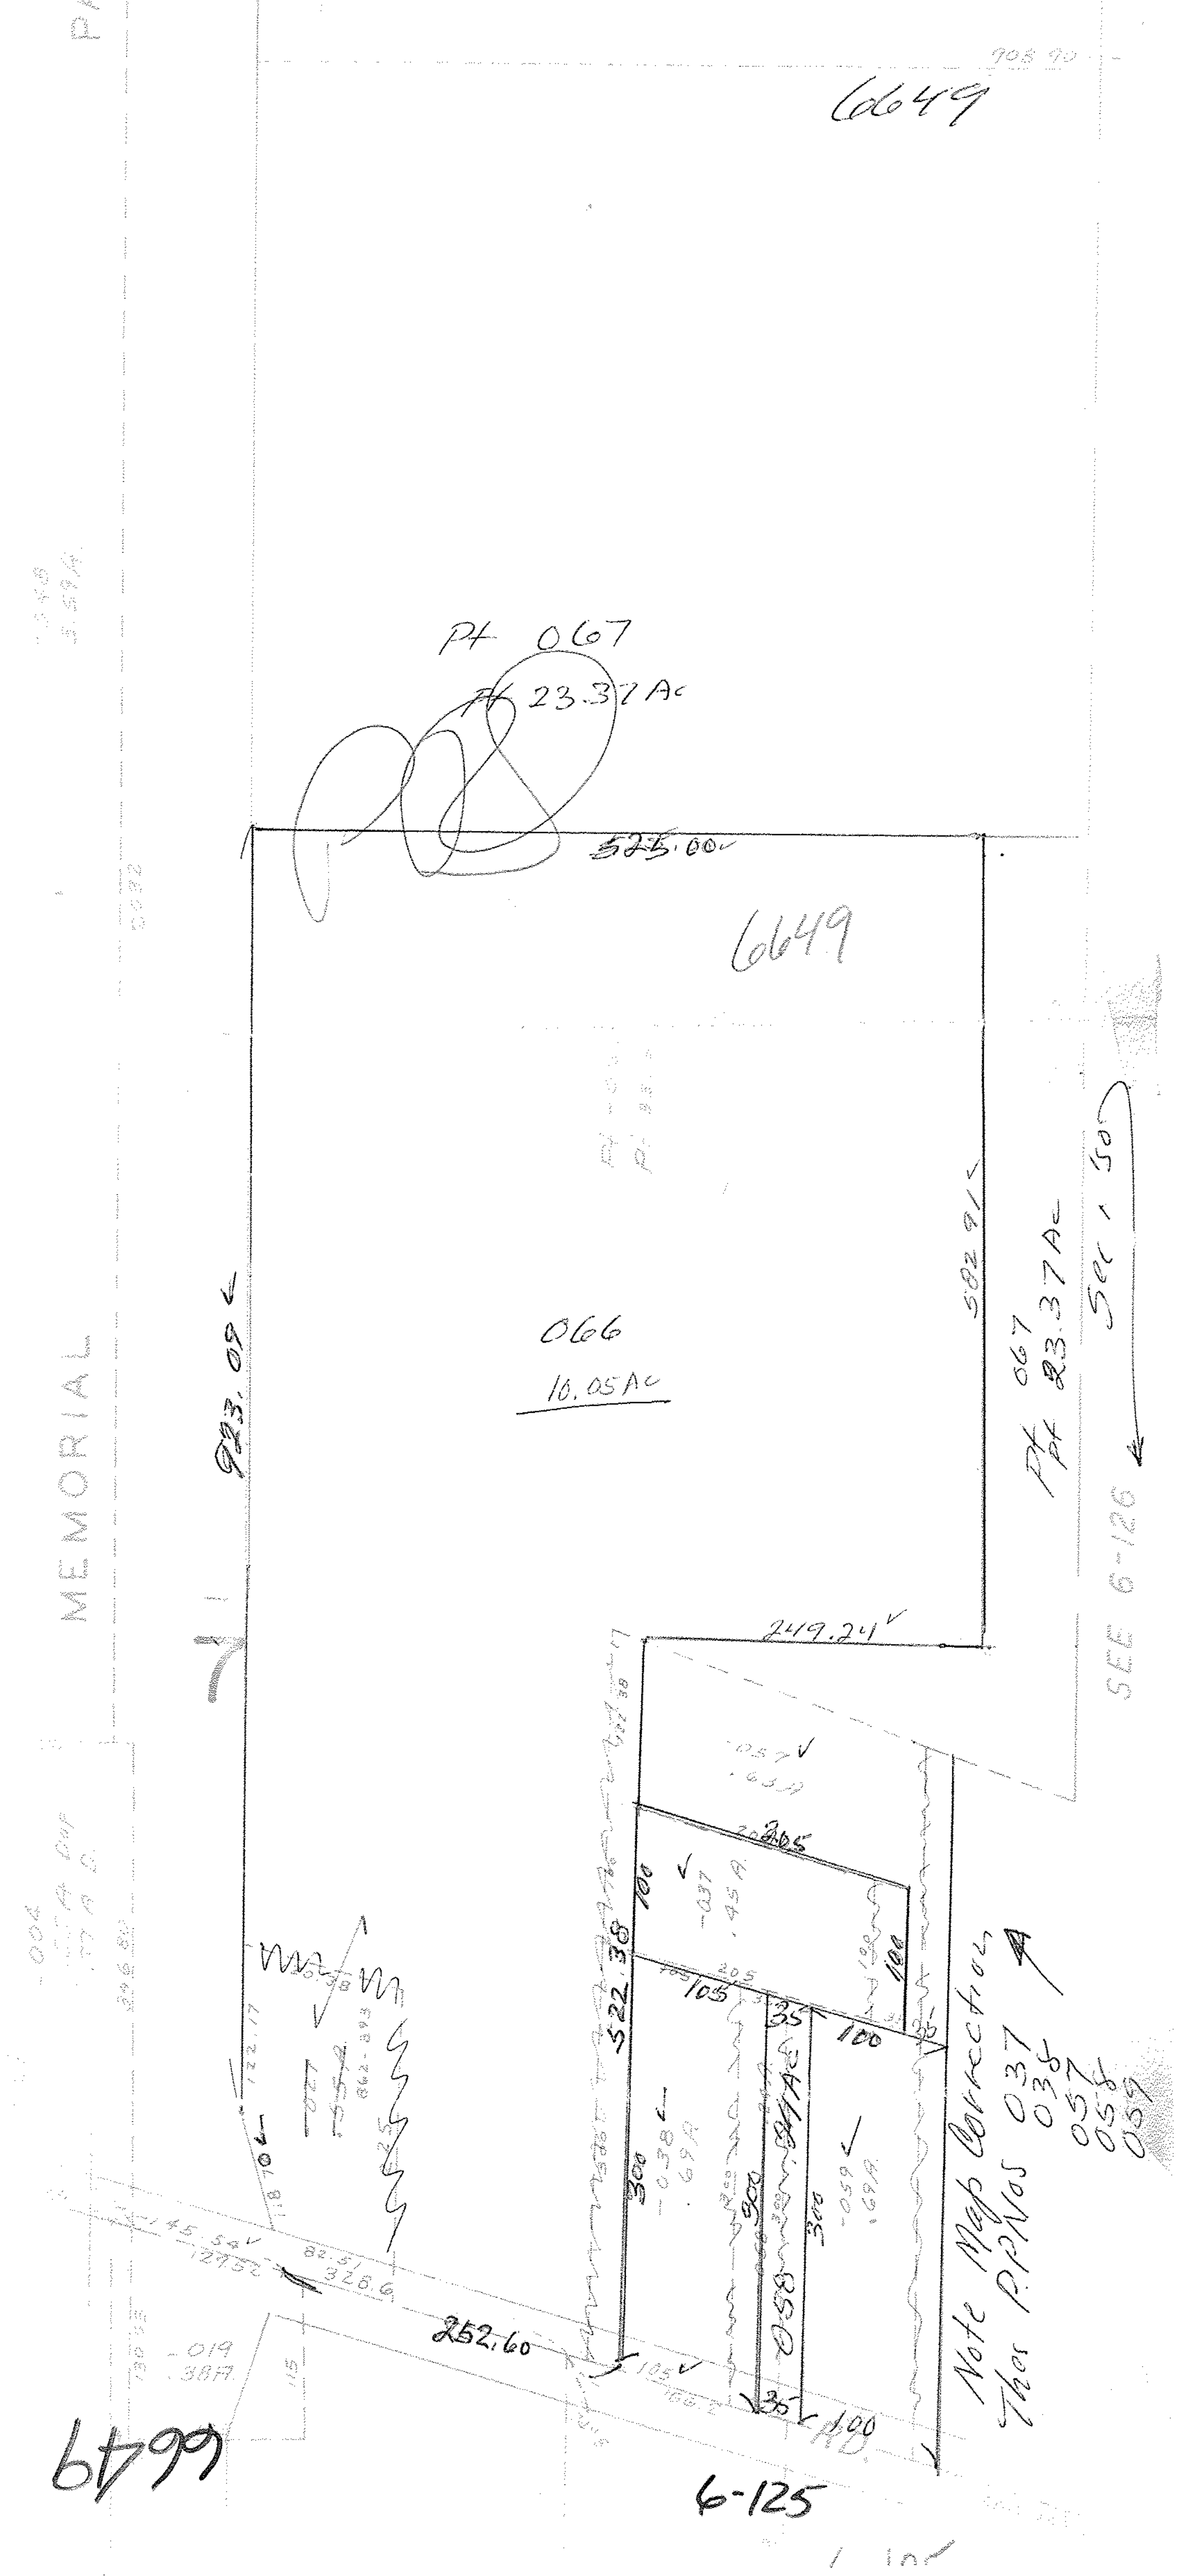
6649
Pt 067
Pt 23.37 Ac
525.00
6649
066
10.05 Ac
923.09
582.91
Pt 067
Pt 23.37 Ac
Sec 1 50
SEE 6-126
249.24
522.38
100
205
105
35
100
300
058
252.60
Note Map Correction
Thos P.P.Nos 037
038
057
058
059
MEMORIAL
6649
6-125