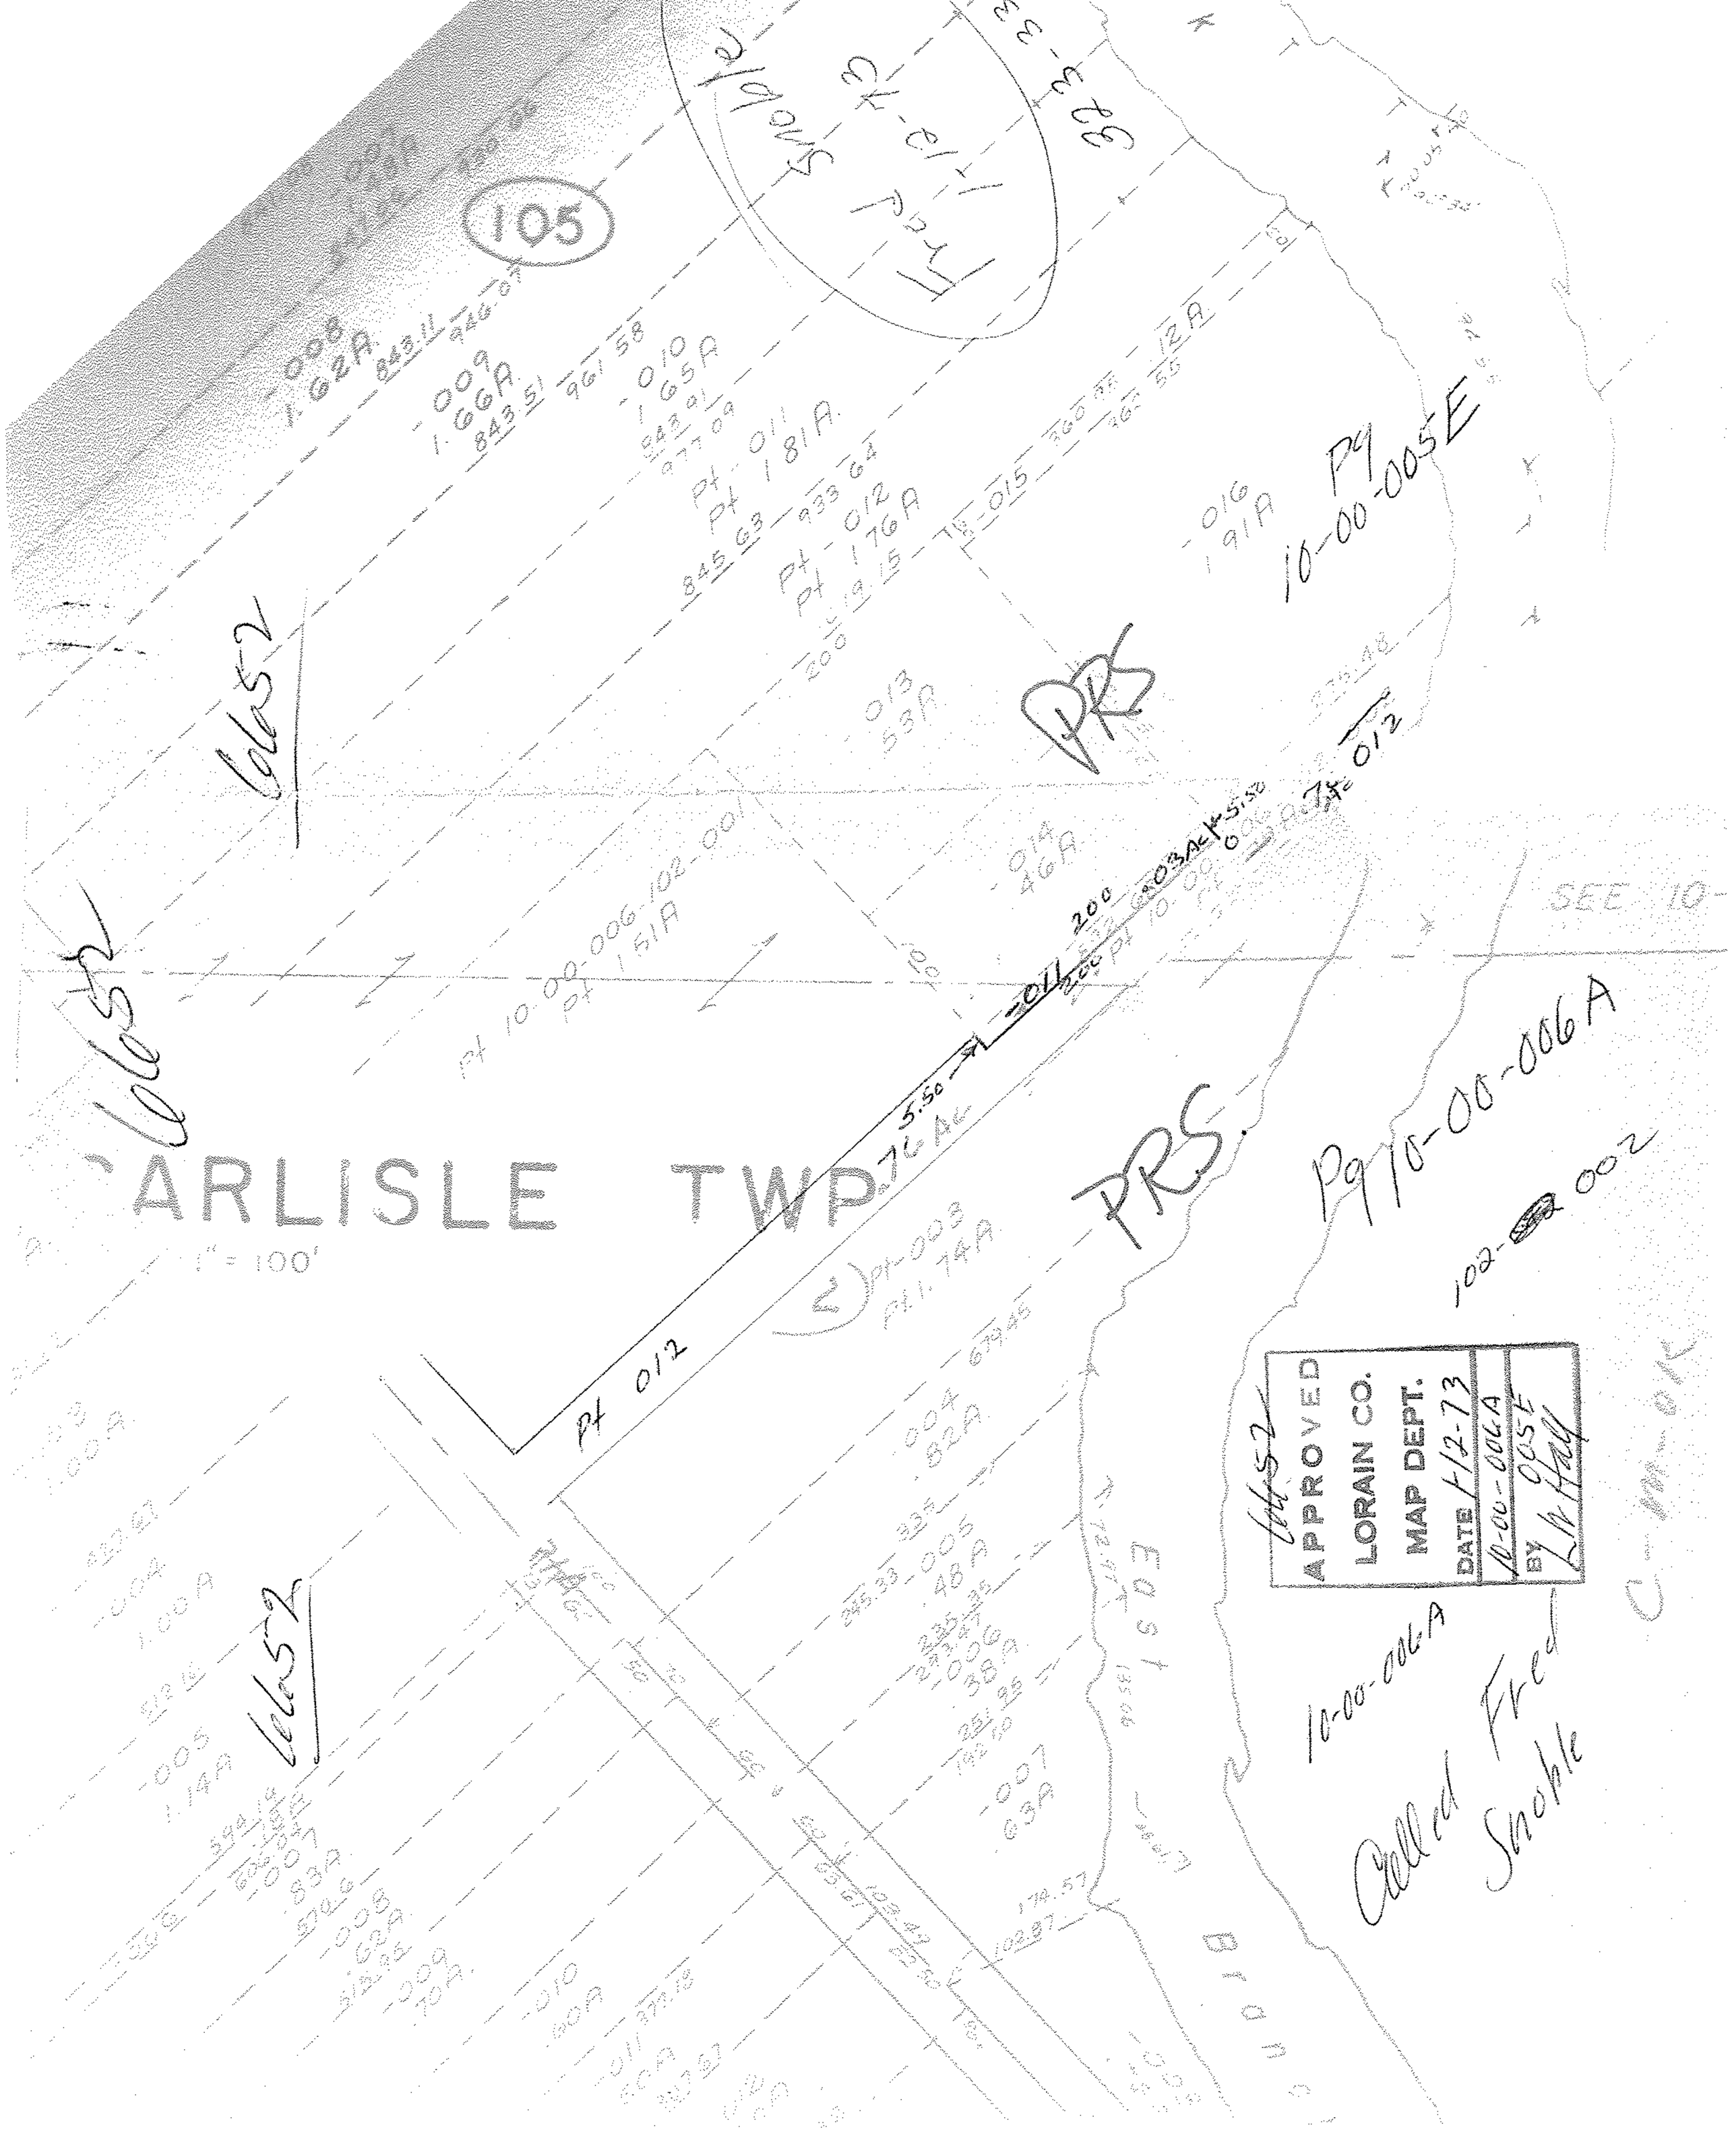
105
Fred Snoble
1-12-73
323-33
Pg 10-00-005E
PRS
SEE 10-
Pg 10-00-006A
102-002
CARLISLE TWP
1" = 100'
Pt 012
East
Branch
APPROVED
LORAIN CO.
MAP DEPT.
DATE 1-12-73
10-00-006A
BY 005E
10-00-006A
Called Fred Snoble