


*Collected*

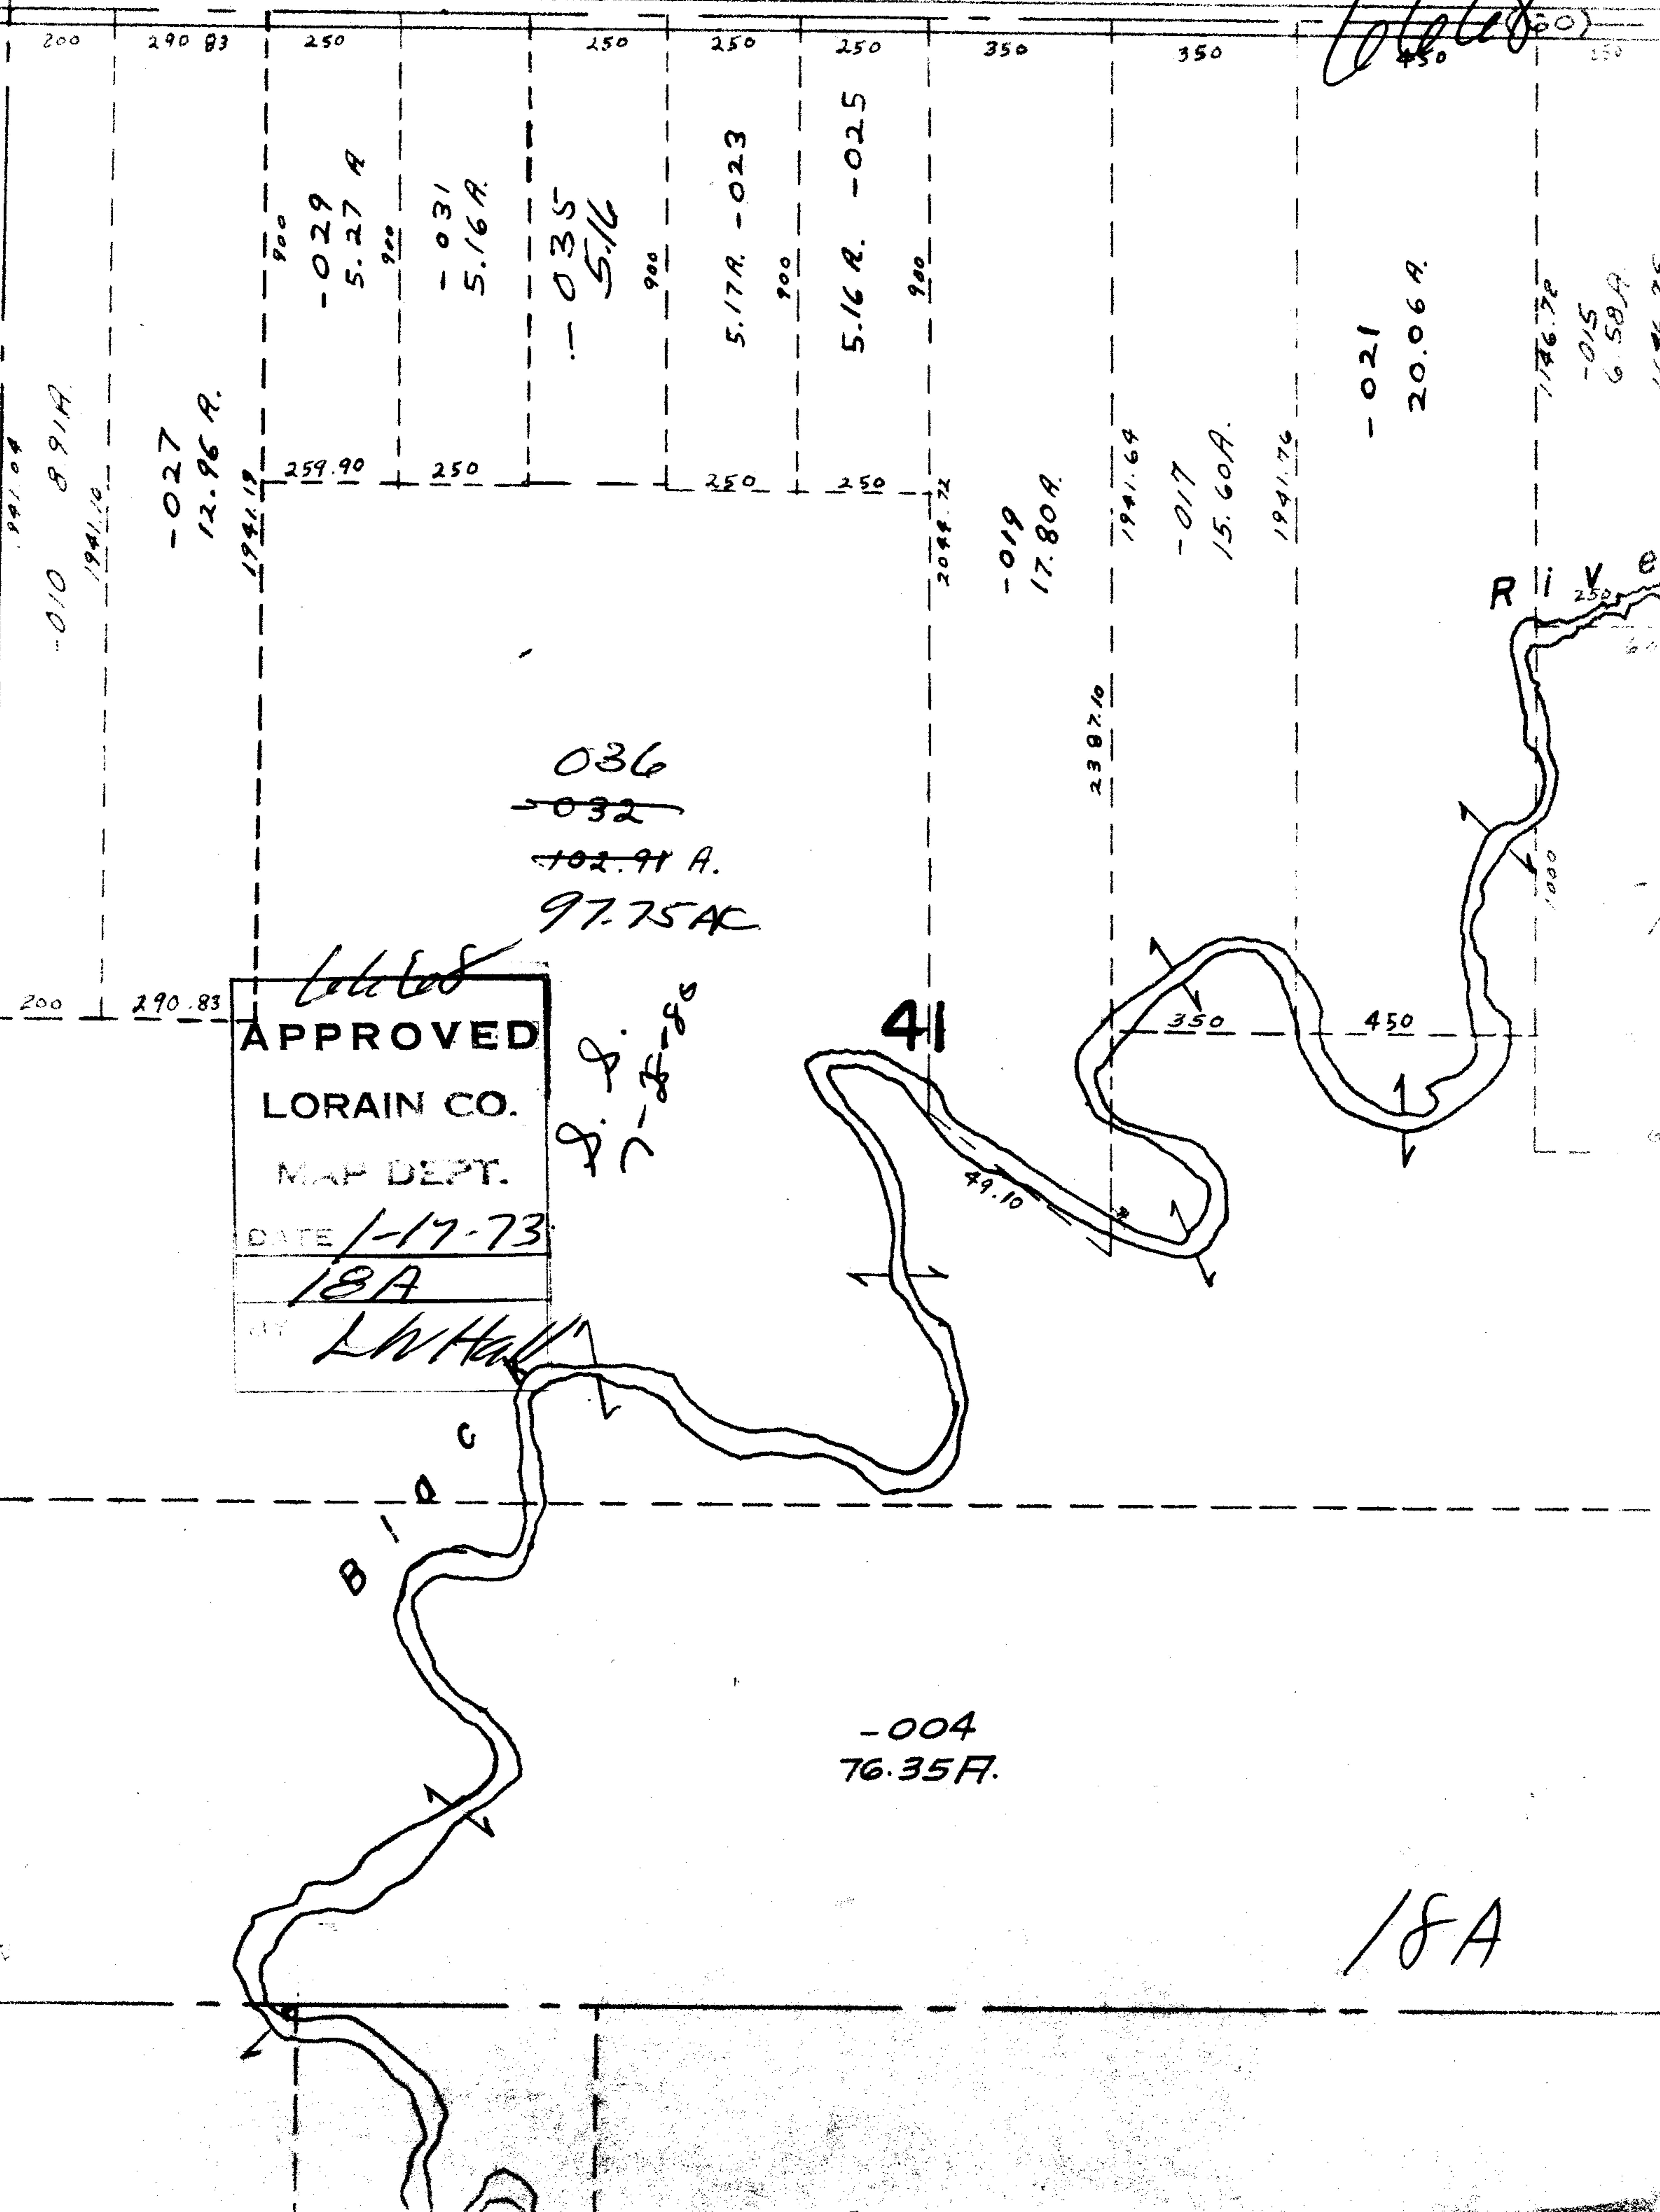

1941.04  
-010 8.91A  
1941.10

-027  
12.96 A.  
1941.19

900  
-029  
5.27 A  
900

-031  
5.16 A.

-035  
5.16

900  
5.17 A. -023  
900

900  
5.16 R. -025  
900

-019  
17.80 A.  
1941.64

-017  
15.60 A.  
1941.76

-021  
20.06 A.

1746.72  
-015  
6.58 A.  
1941.25

036  
~~032~~  
102.91 A.  
97.75 AC

*Collected*  
**APPROVED**  
 LORAIN CO.  
 MAP DEPT.  
 DATE 1-17-73  
 18A  
 BY LWHall

*g. s.  
7-28-86*

41

-004  
76.35 F.

18A

R i v e