


SE 2-01-003-D

6677  
6677

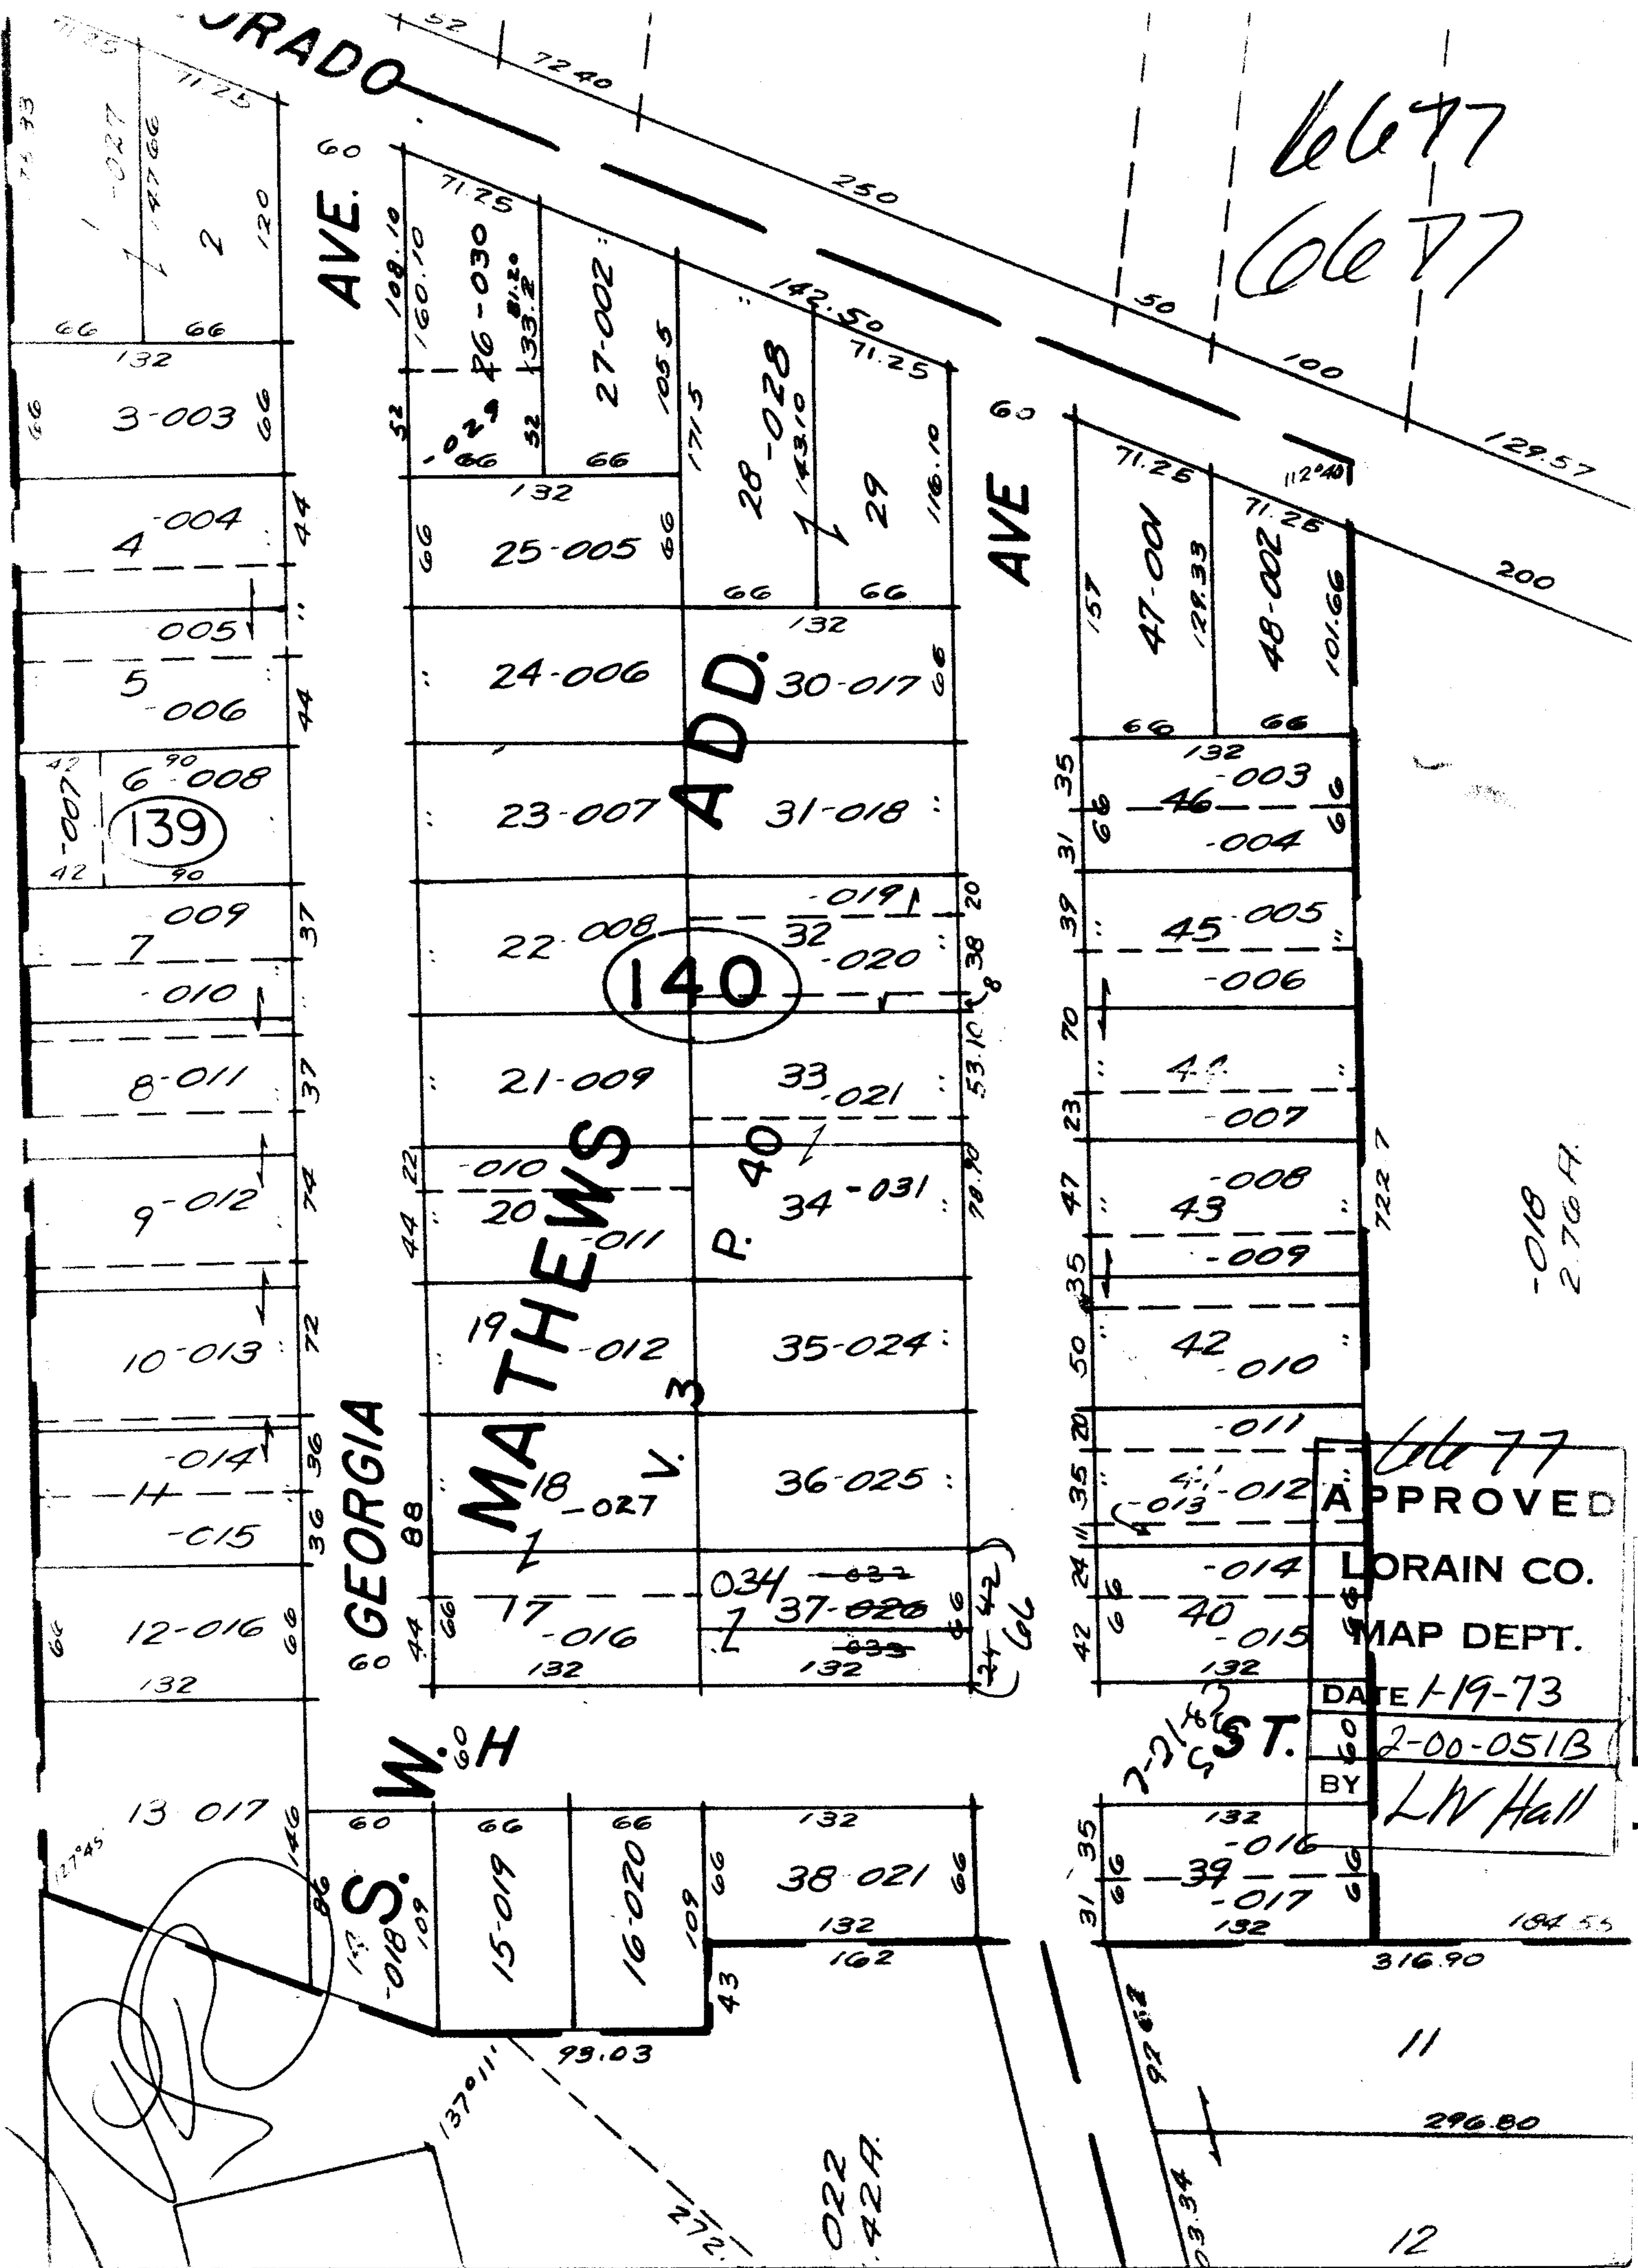

140

MATHENS

ADD.

APPROVED

LORAIN CO.

MAP DEPT.

DATE 1-19-73

BY 2-00-051B

L.V. Hall

-018  
2.76 FT.

11

296.80

12

022  
42A.

