


20-05-009-000-008 6681

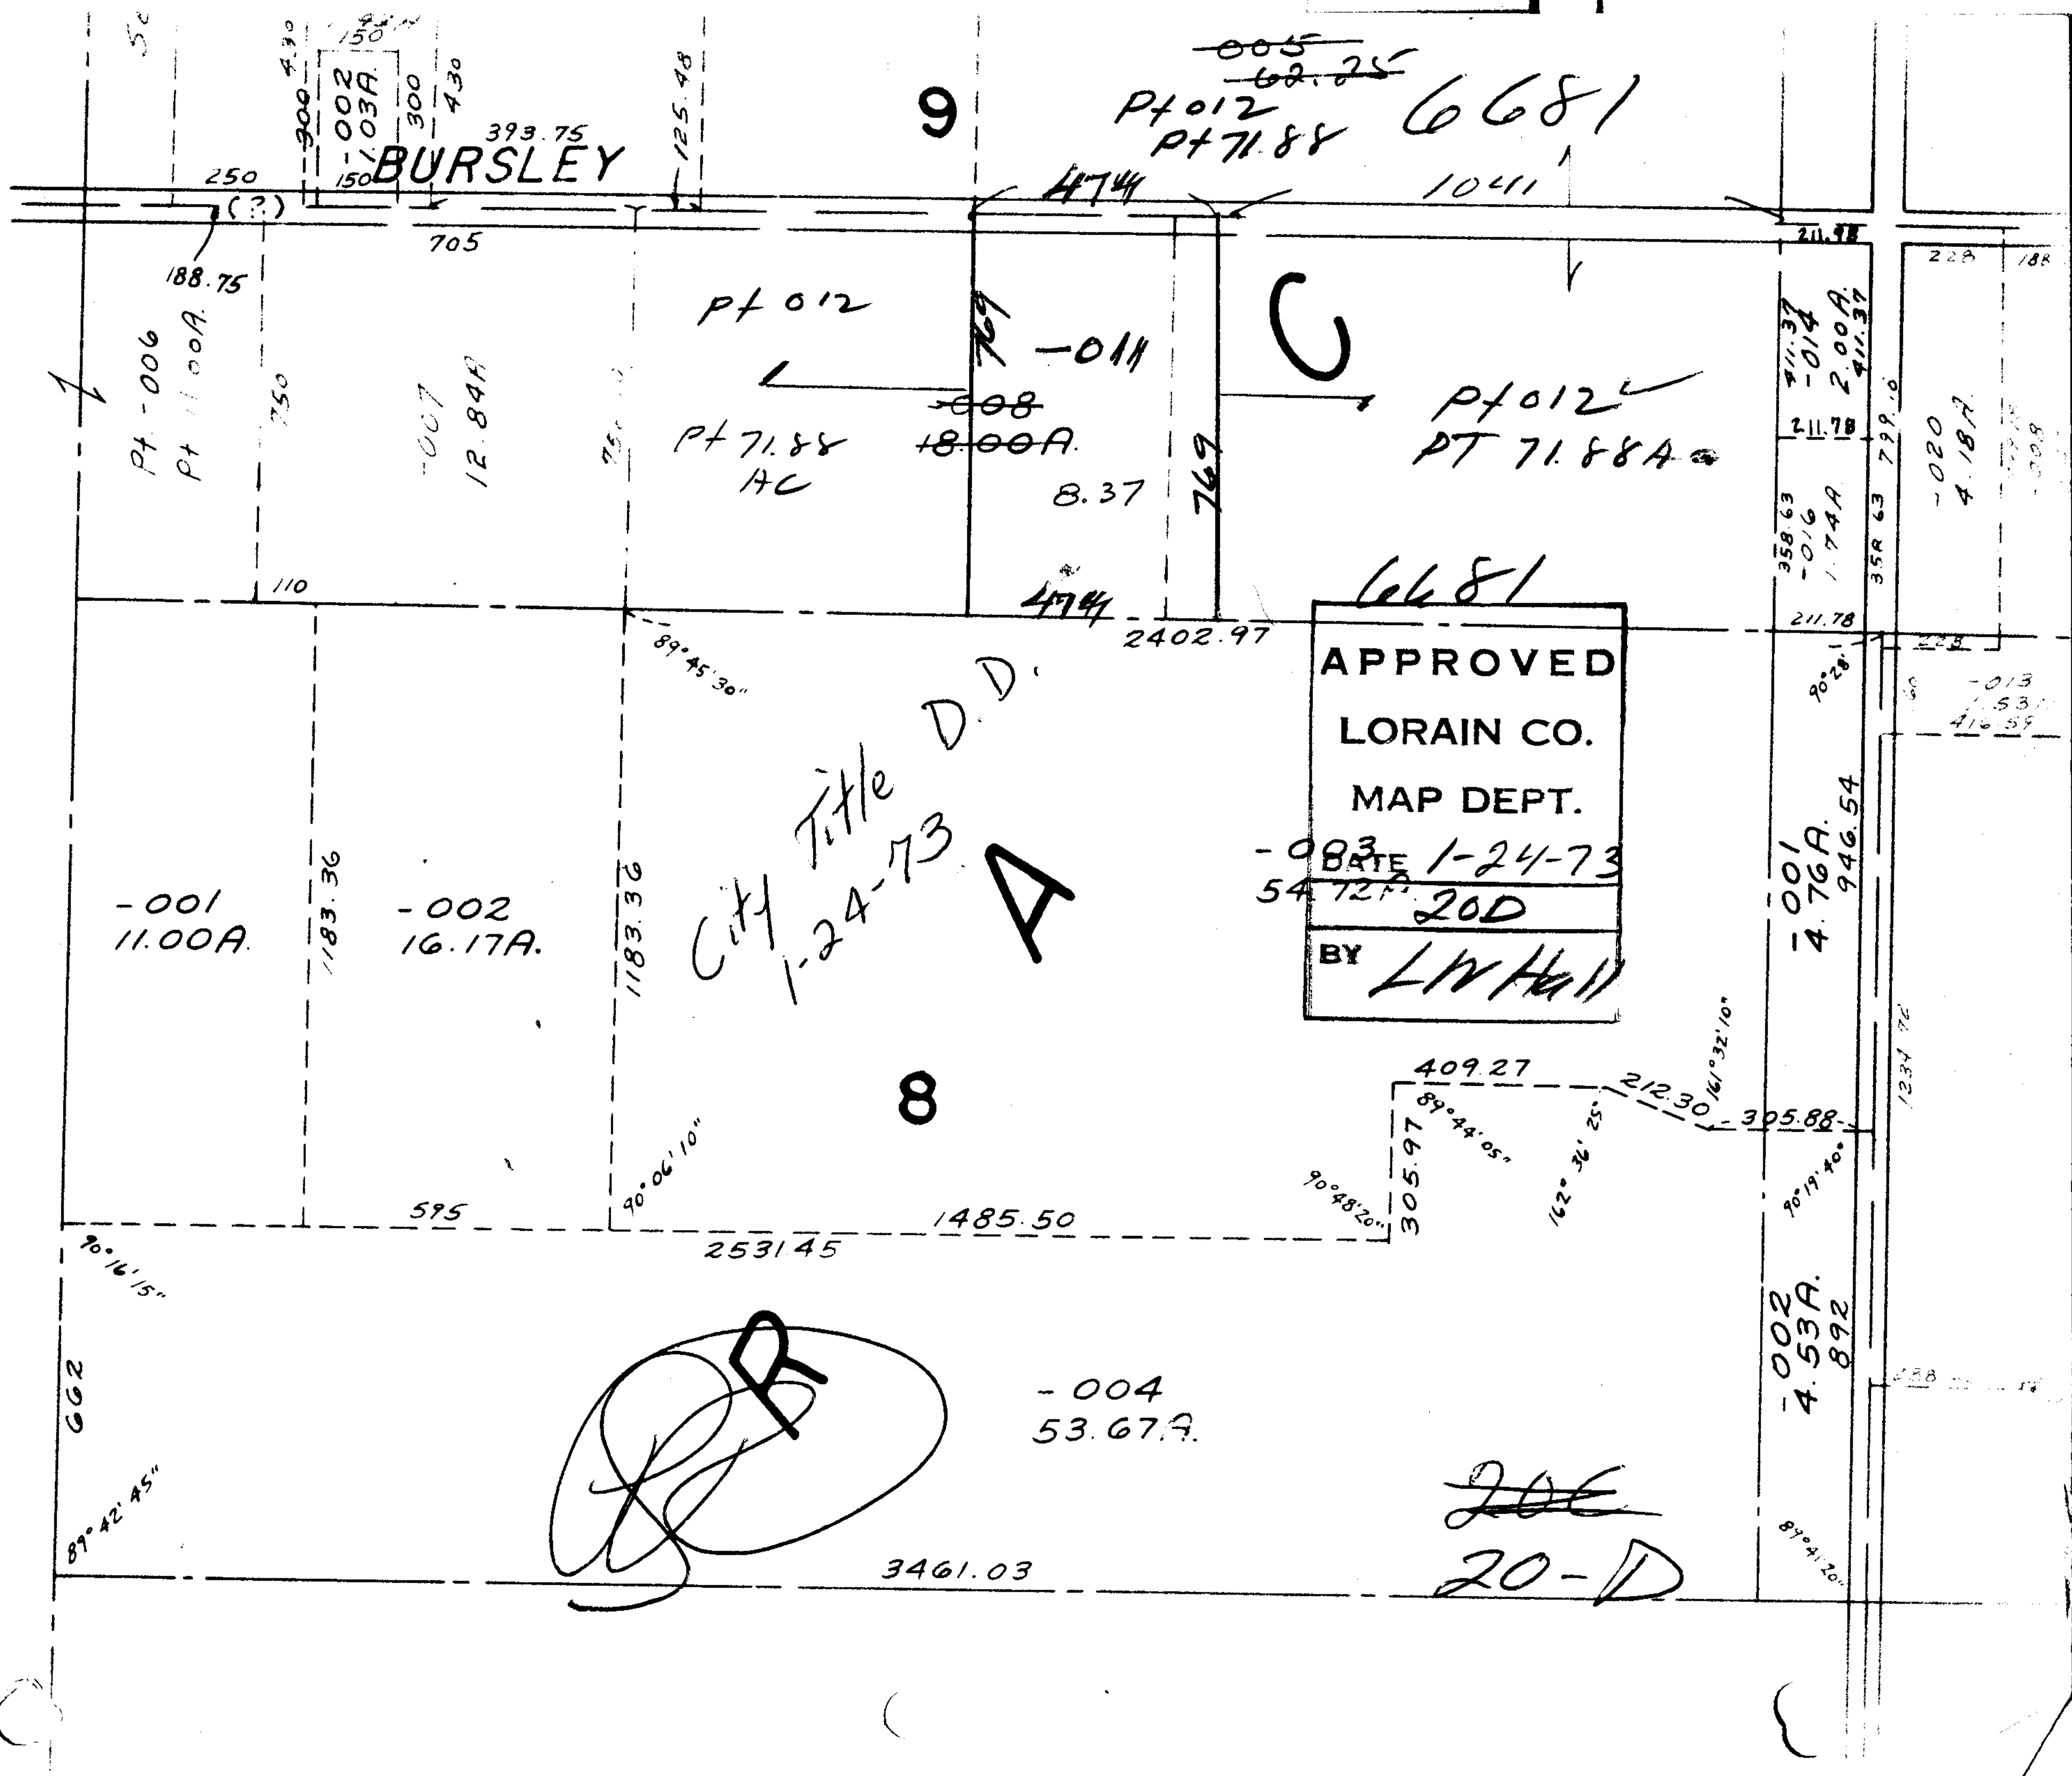

BURSLEY

9

~~005~~
~~62.25~~
P+012
P+71.88
6681
10411

Pt -006
Pt 11.00A
188.75

Pt 012
Pt 71.88
AC

-011
-008
18.00A
8.37

Pt 012
PT 71.88A

-001
11.00A

-002
16.17A

City Title D.D.
1-24-73
A

6681
APPROVED
LORAIN CO.
MAP DEPT.
DATE 1-24-73
54.72A
20D
BY L.V. Hall

8

-004
53.67A


~~20E~~
20-D

-002
4.53A
892

-001
4.76A
946.54

-020
4.18A

-013
1.53A
416.58

90°16'15"

89°42'45"

2531.45

1485.50

3461.03

2402.97

409.27

305.97

212.30

305.88

89°41'20"

1234.76

258

228 188

358.63
-016
1.74A
211.78
911.37
-014
2.00A
911.37

80°28'

























