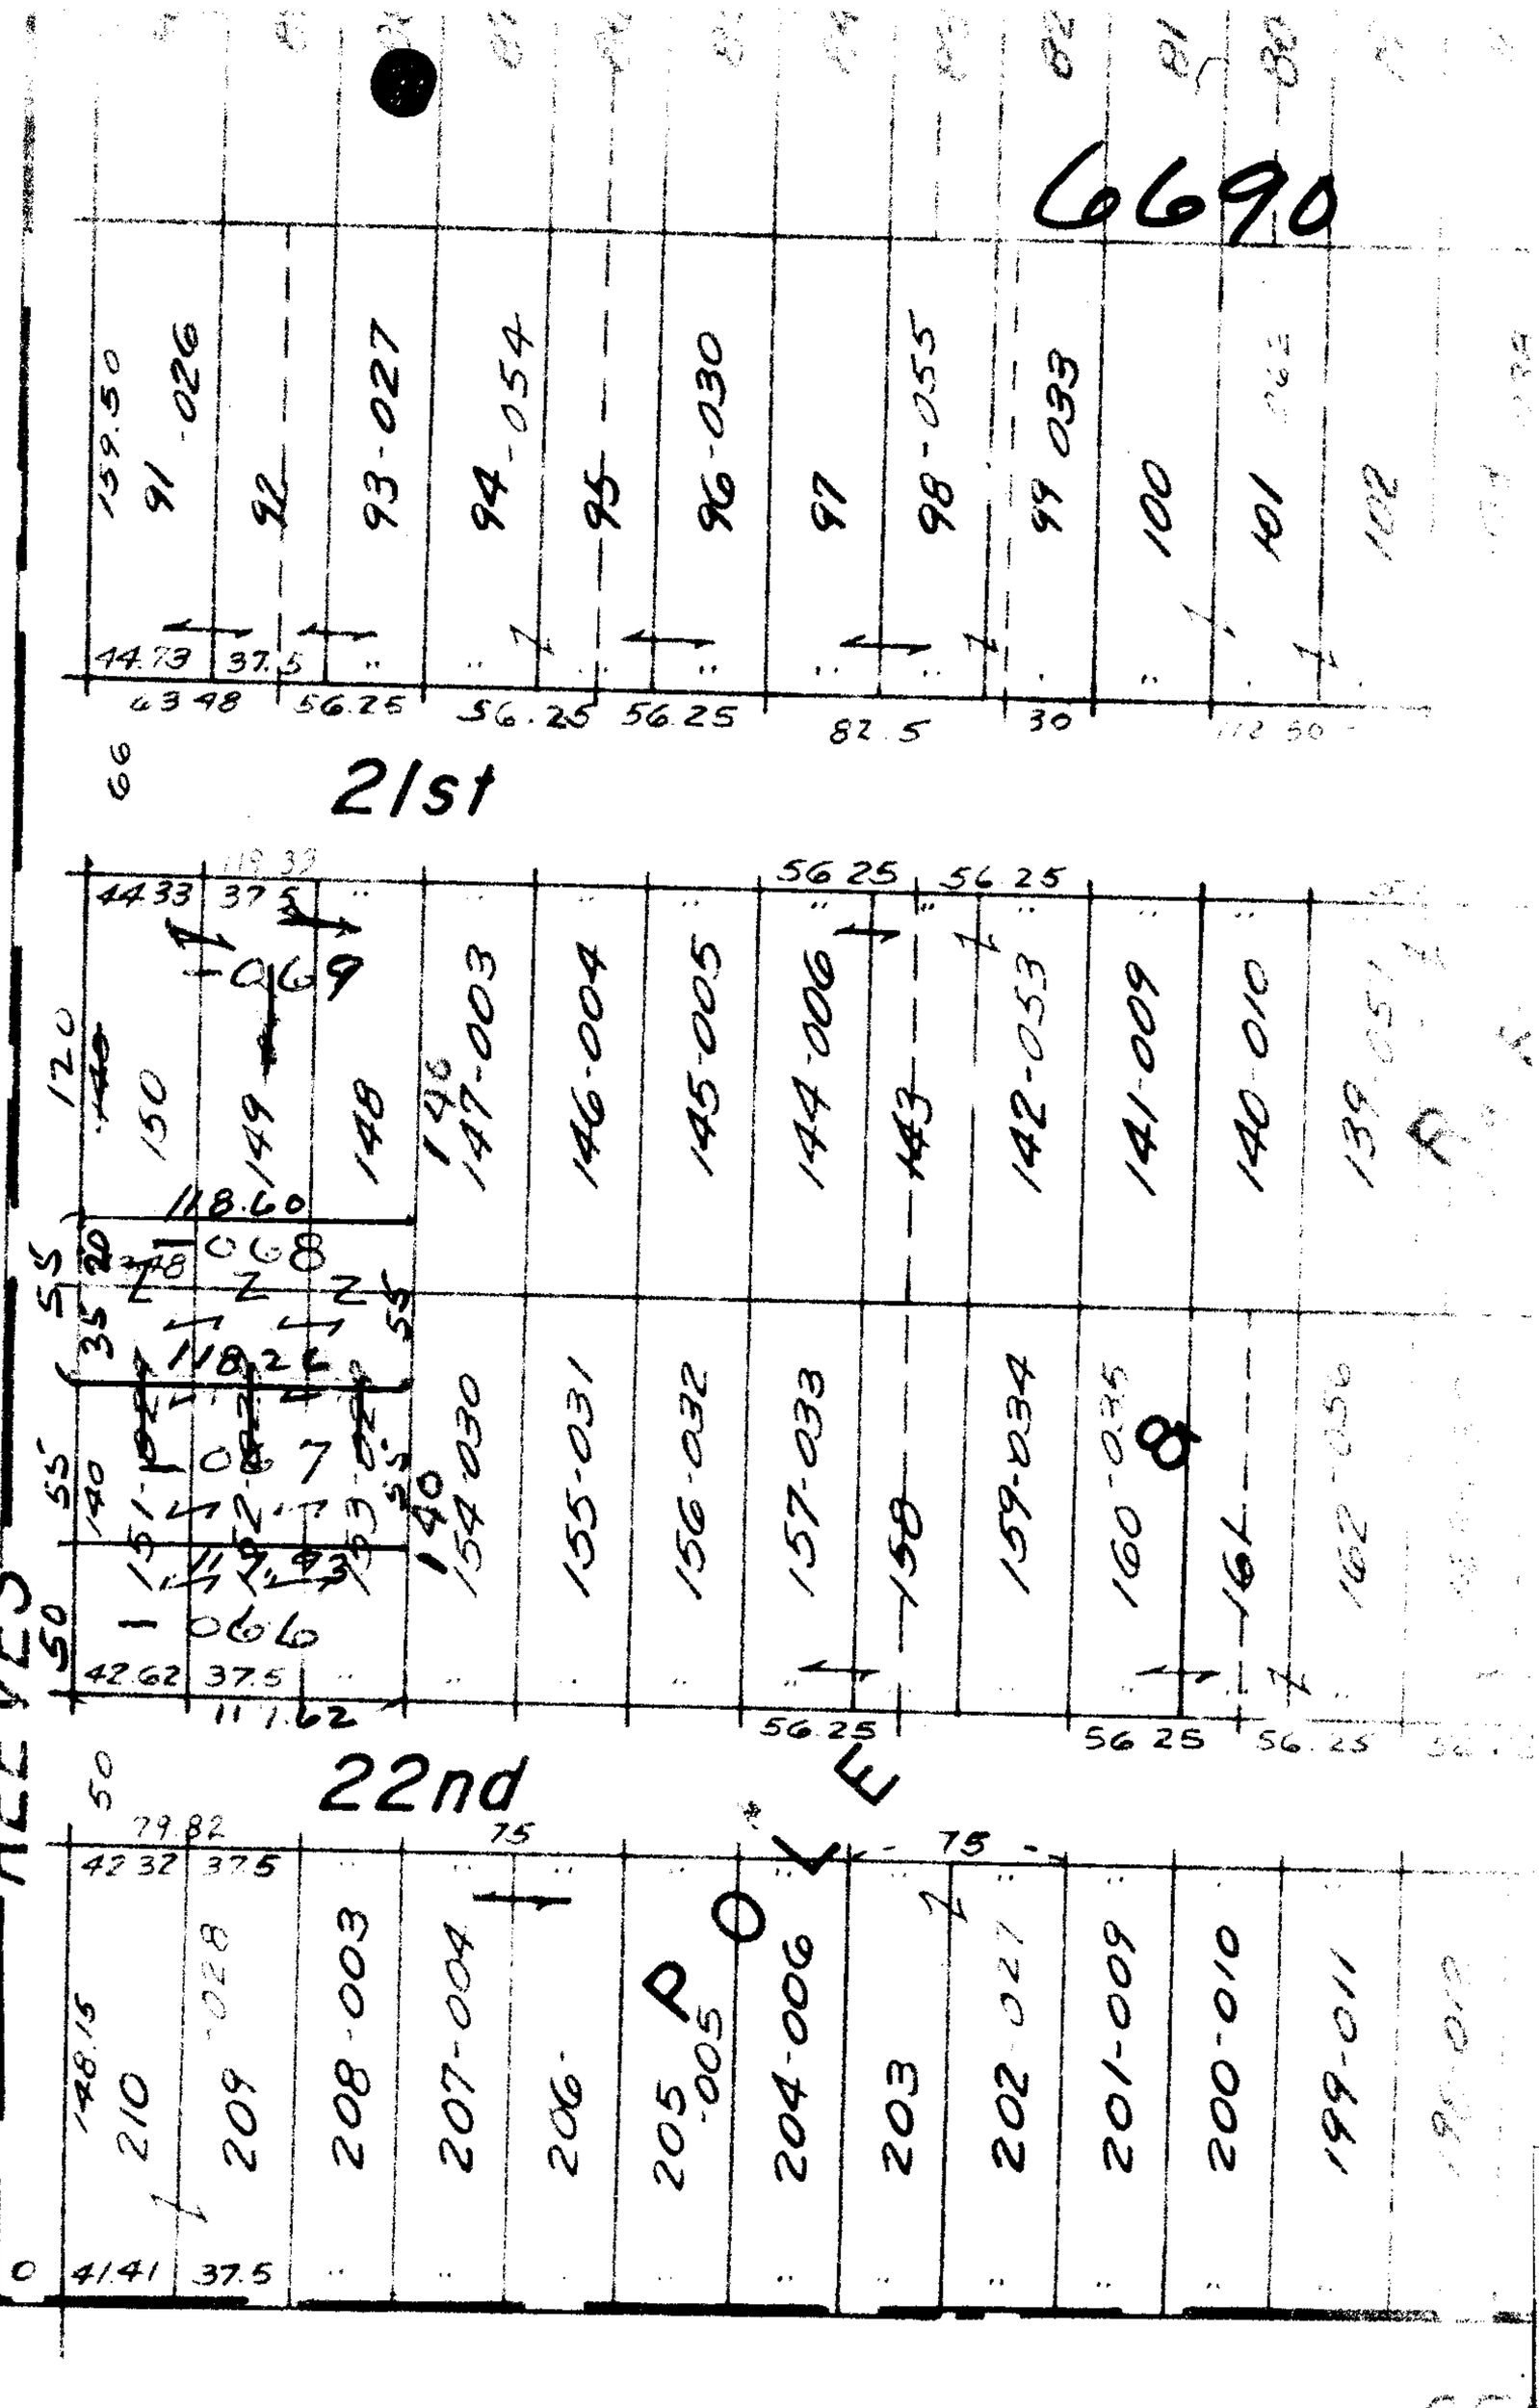

140
105
35

57
55
105

6690

APPROVED
LORAIN CO.
MAP DEPT.
DATE 1-31-73
2-02-024B
BY L W Hall

7-21-82
SS

2-02-024B

SE

BLACK RIVER T

SCALE: 1" = 100'