


6710

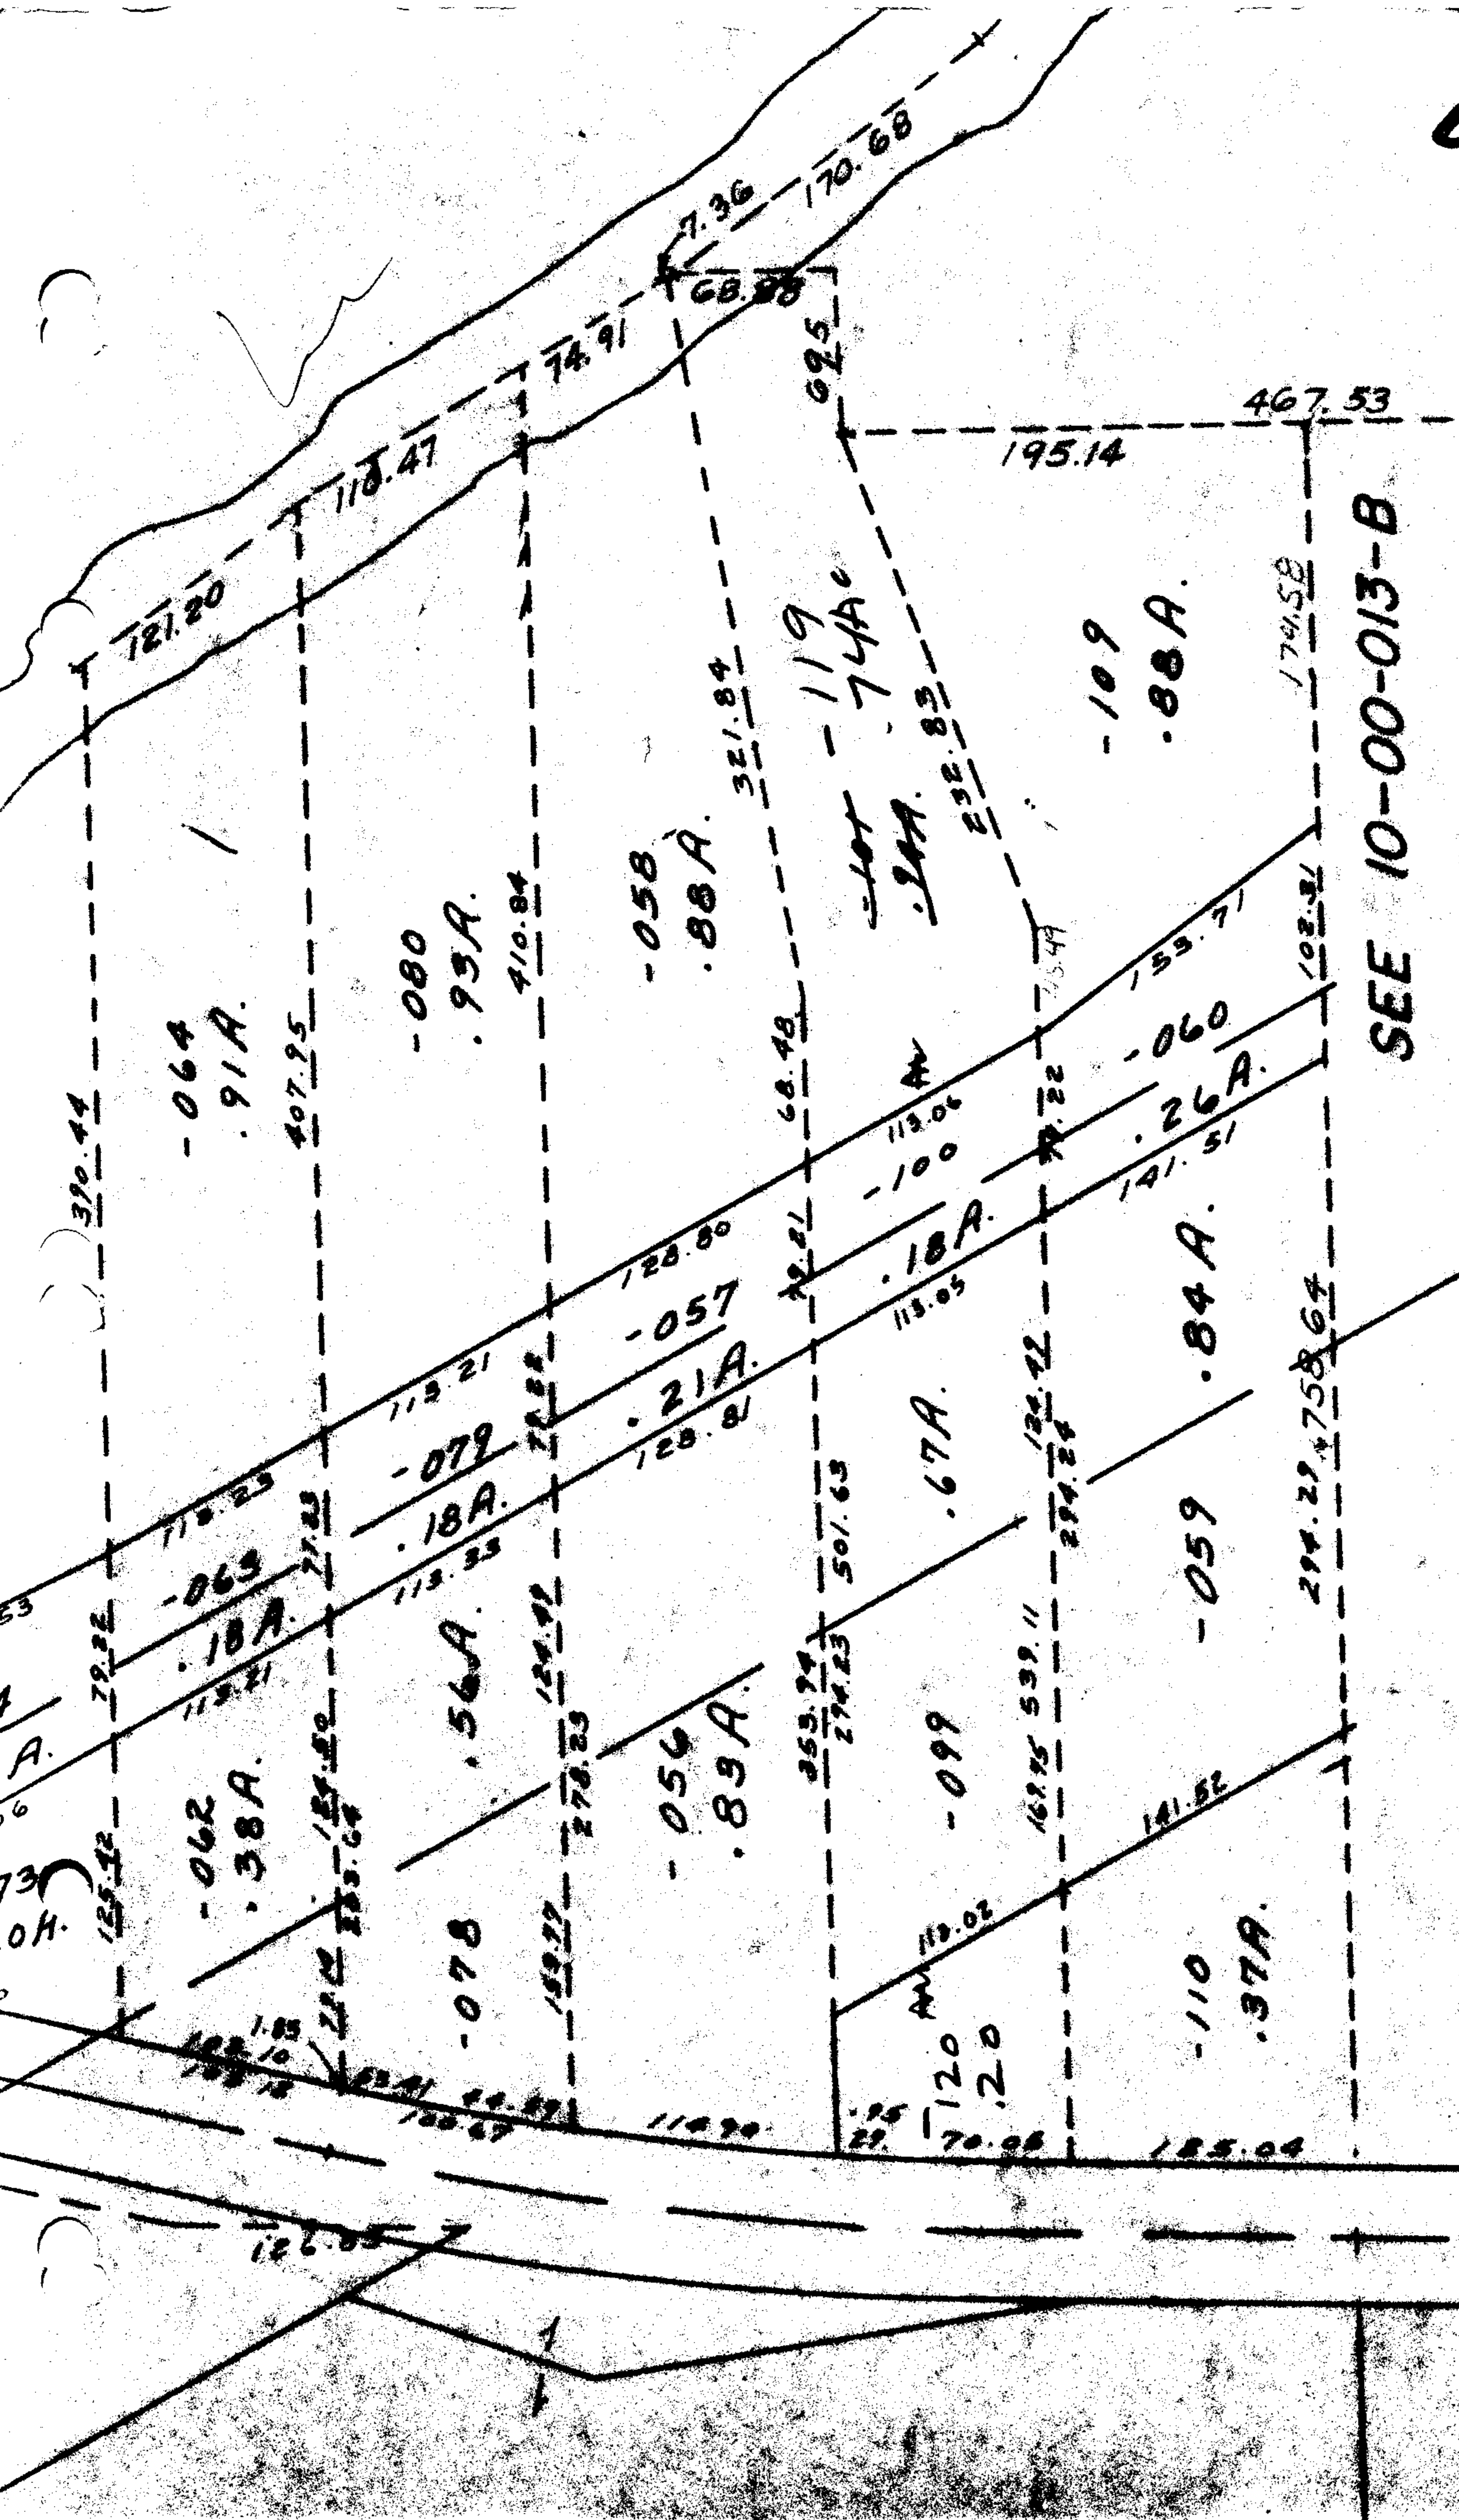

SEE 10-00-013-B

PR

6710
 APPROVED
 LORAIN CO.
 MAP DEPT.
 DATE 2-9-73
 10-00-013A
 BY L.V. Hall

J.S.
7-27-86