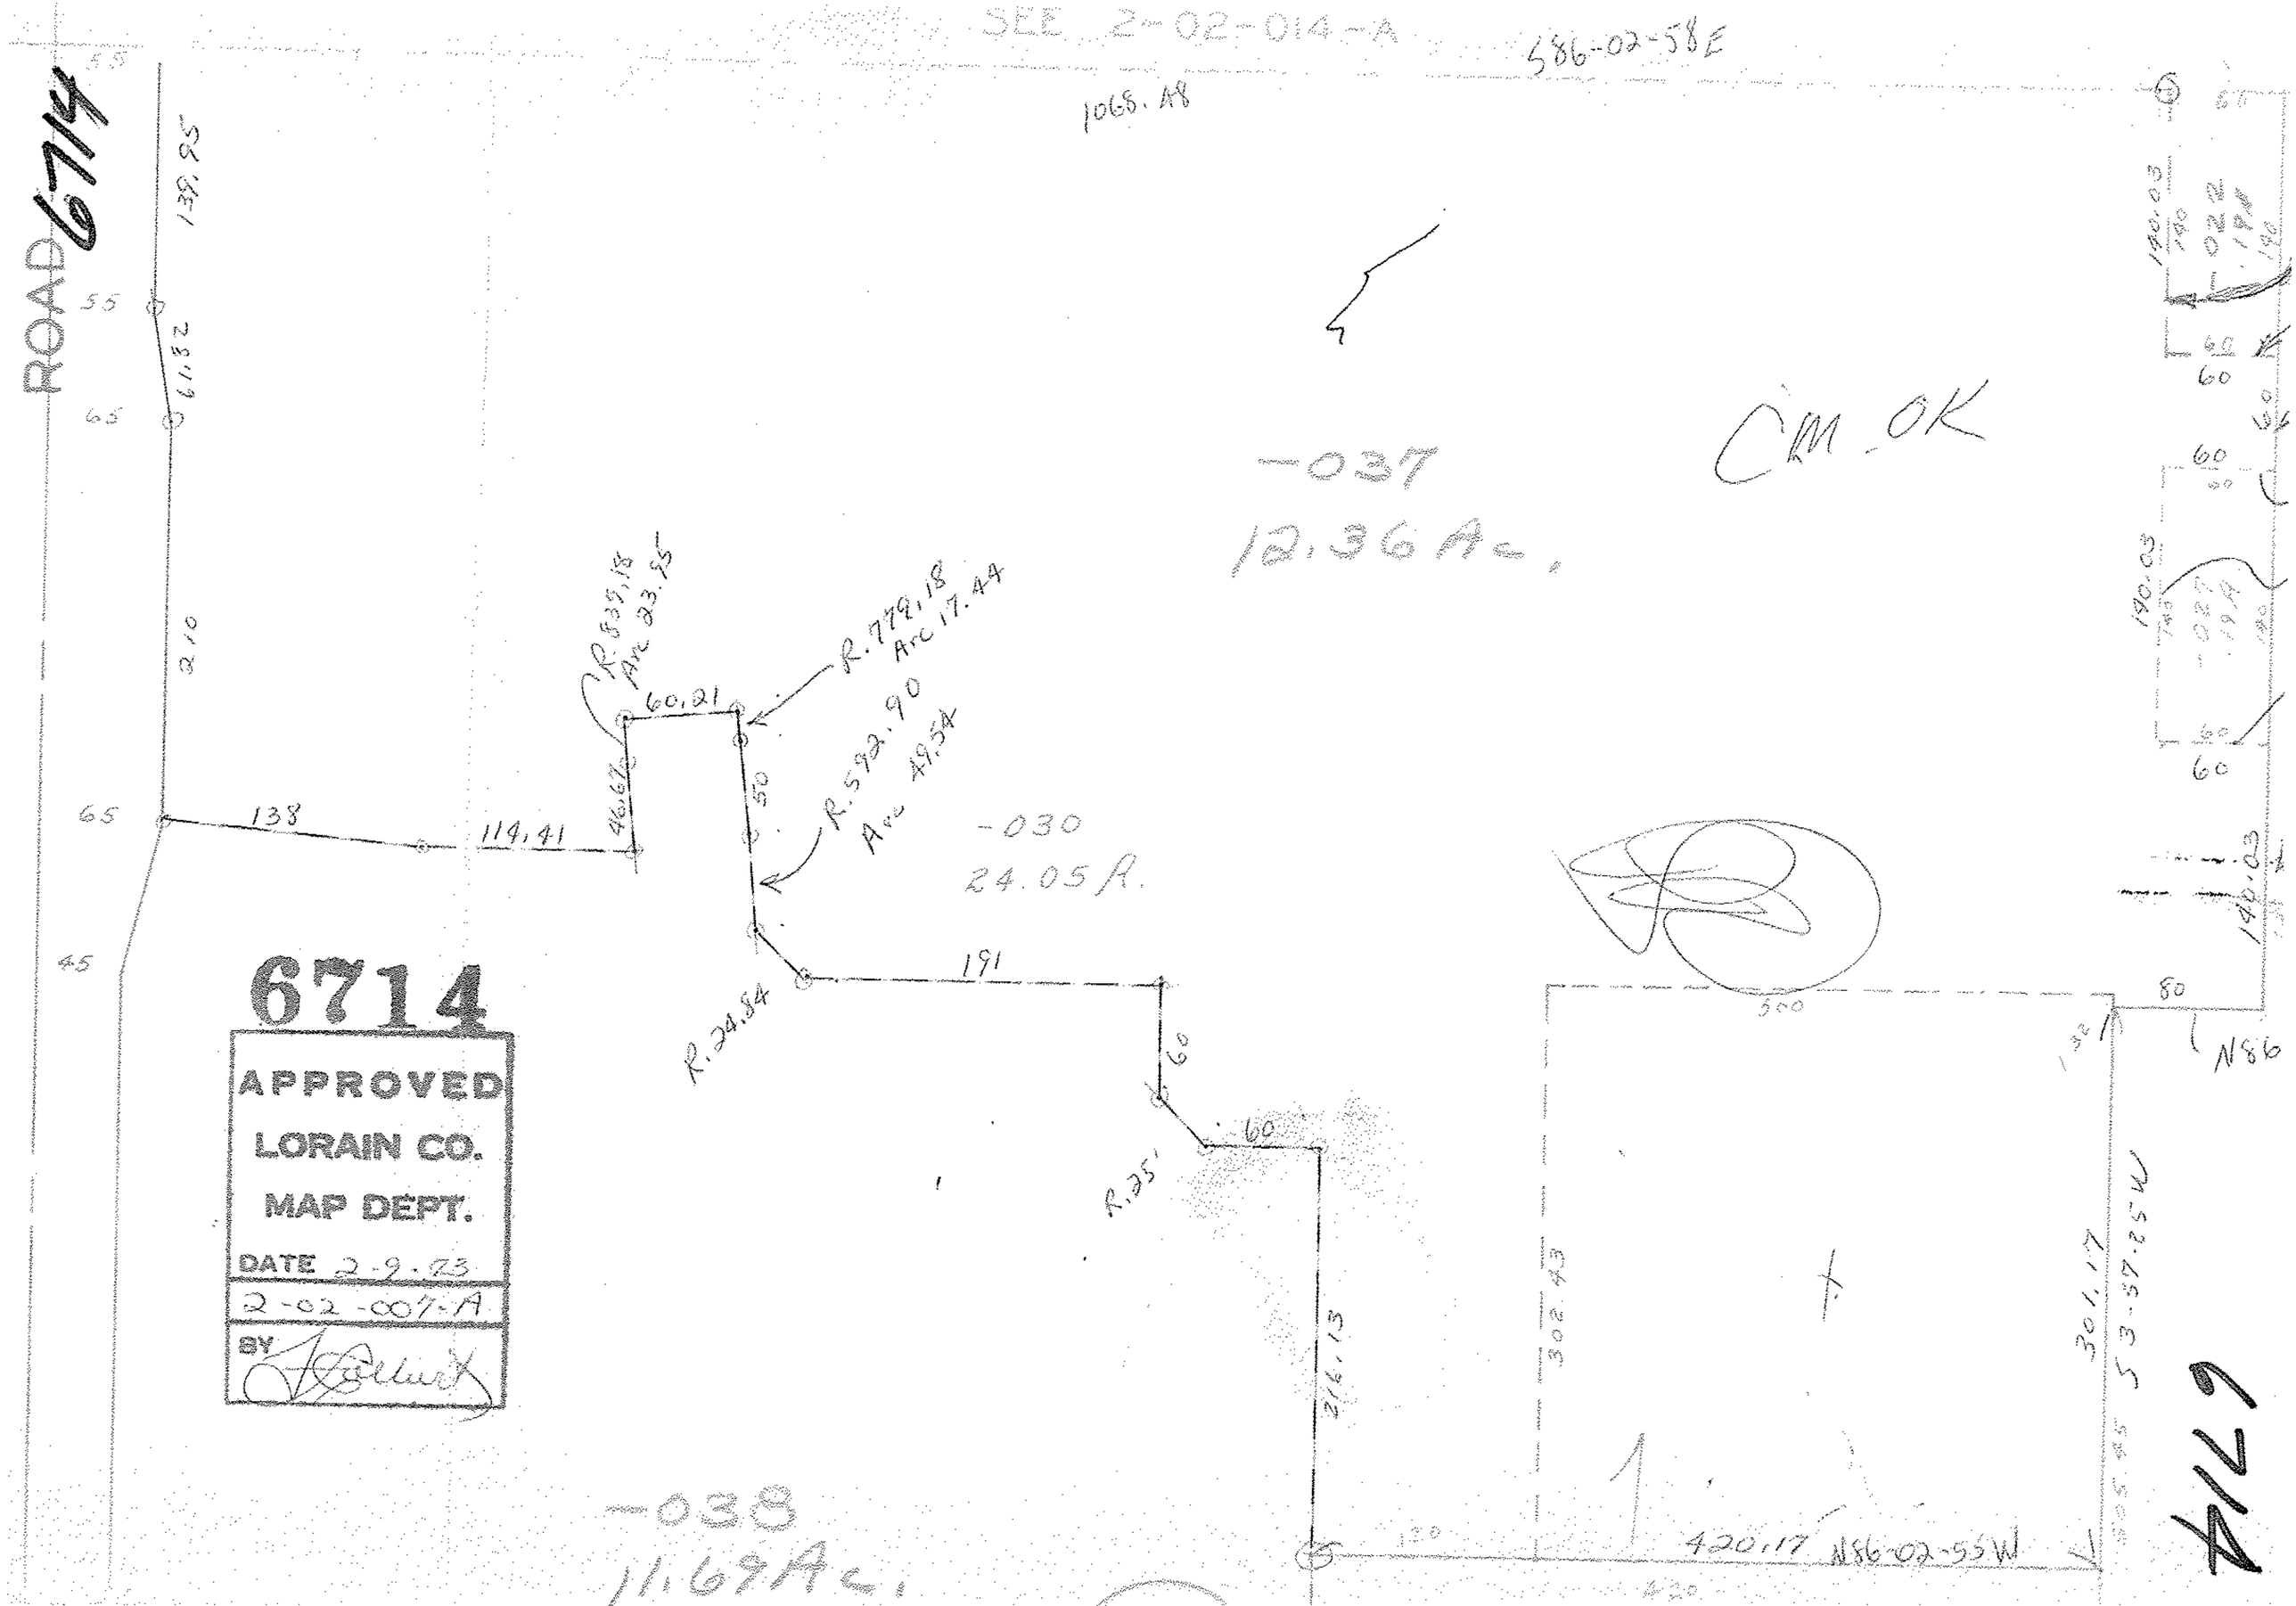

SEE 2-02-014-A
S86-02-58E
1068.48
ROAD 6714
139.95
61.32
210
138
114.41
46.67
60.21
R.839.18 Arc 23.95
R.779.18 Arc 17.44
R.592.90 Arc 49.54
50
-030
24.05 A.
R.24.84
191
60
R.25'
216.13
-037
12.36 Ac.
CM OK
140.03
-027
-038
11.69 Ac.
302.43
301.17
S3-57-25W
420.17 N86-02-55W
N86
6714
APPROVED
LORAIN CO.
MAP DEPT.
DATE 2-9-73
2-02-007-A
BY
6714