


I 7 - 008
270
300

6719

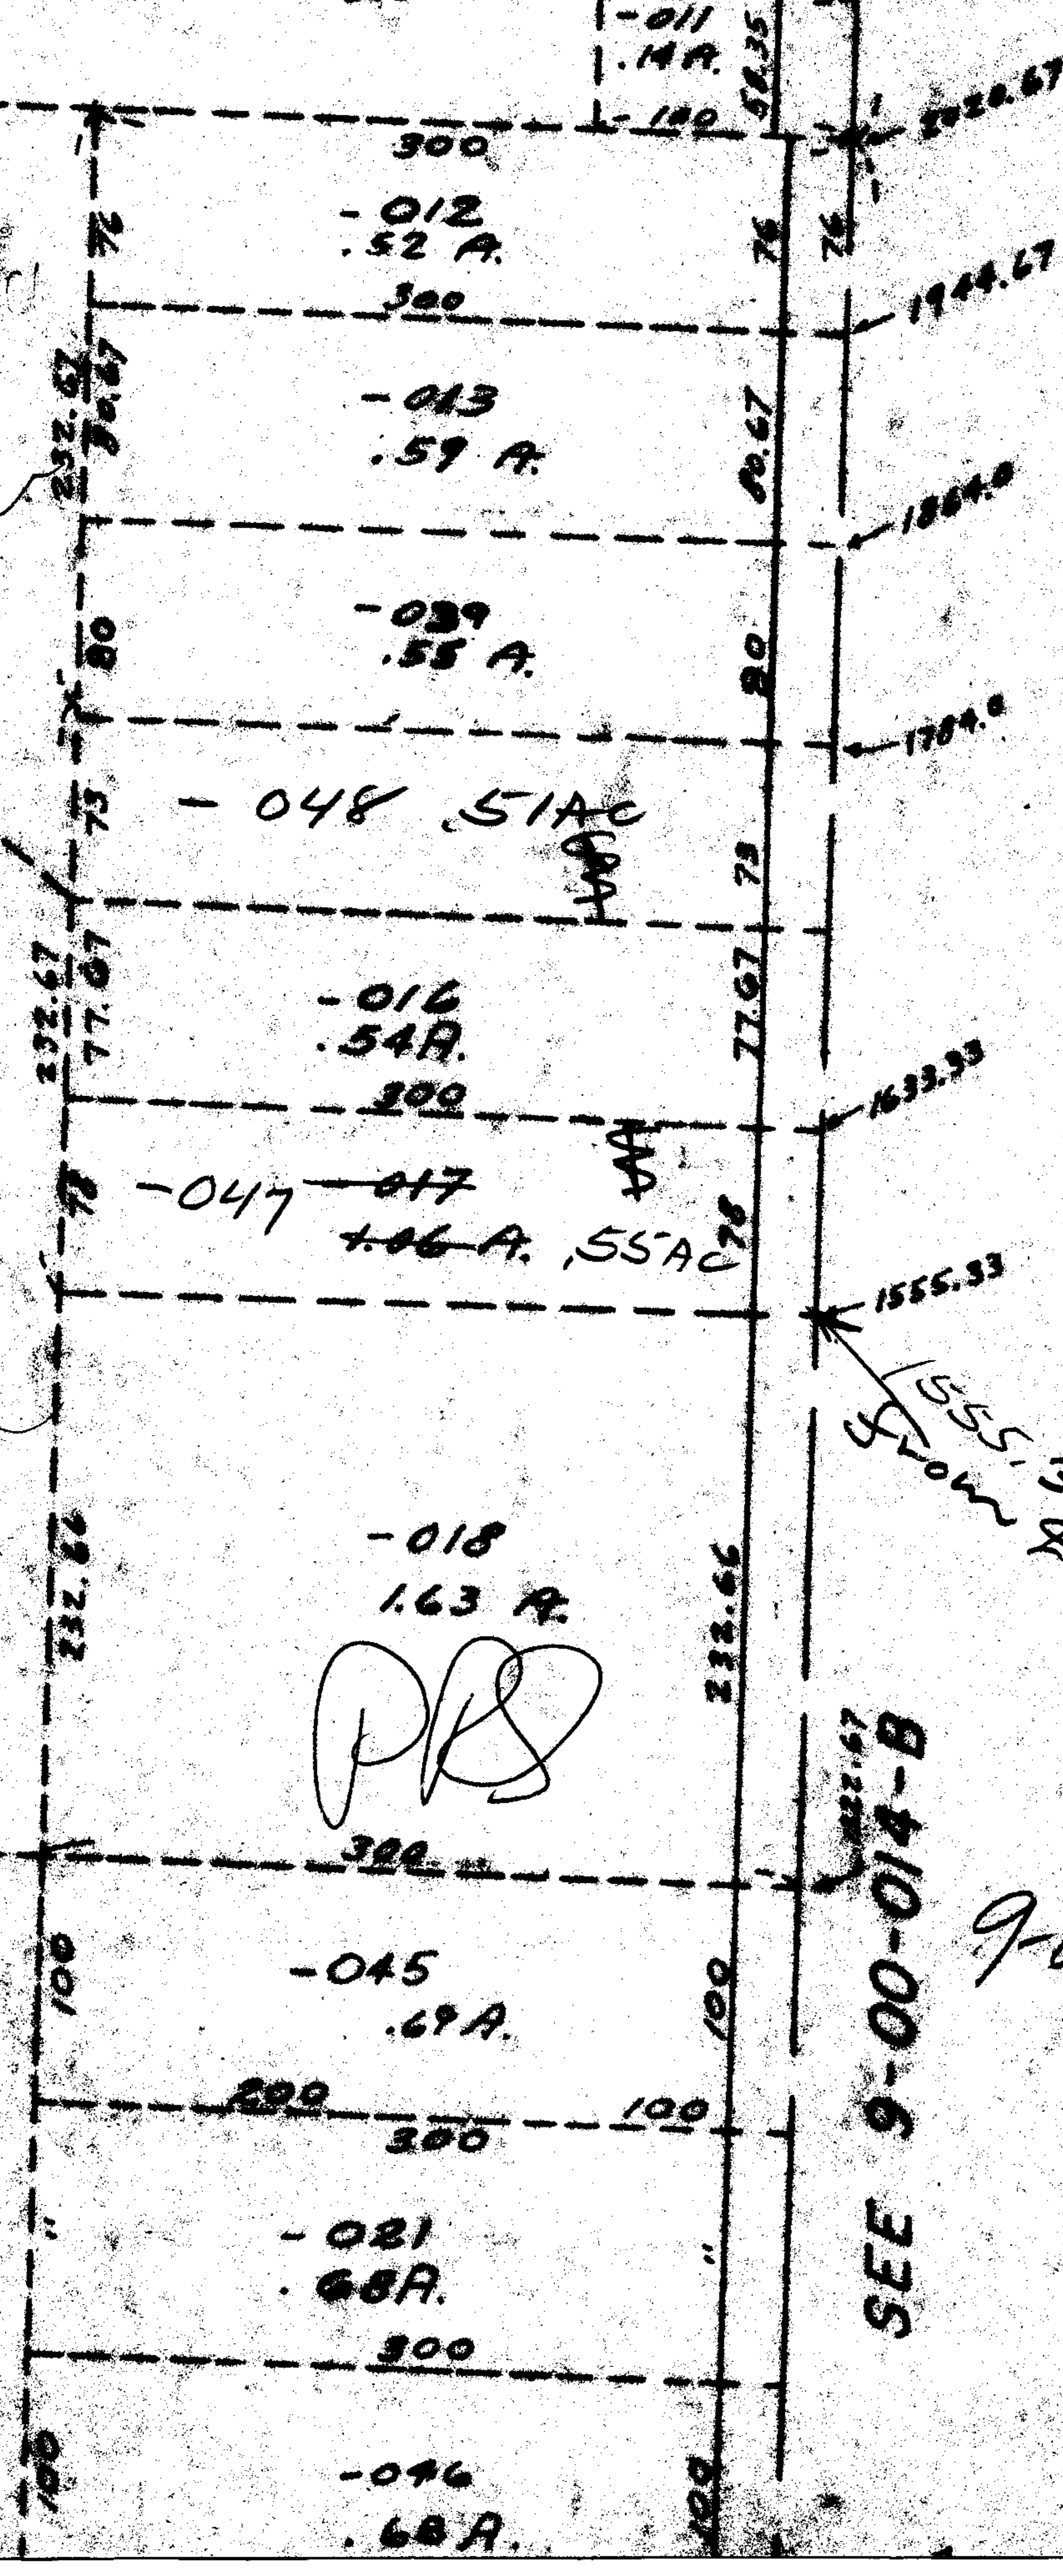

6719
 APPROVED
 LORAIN CO.
 MAP DEPT.
 DATE 2-9-73
 9-00-014A
 BY LWHall

9-00-014A