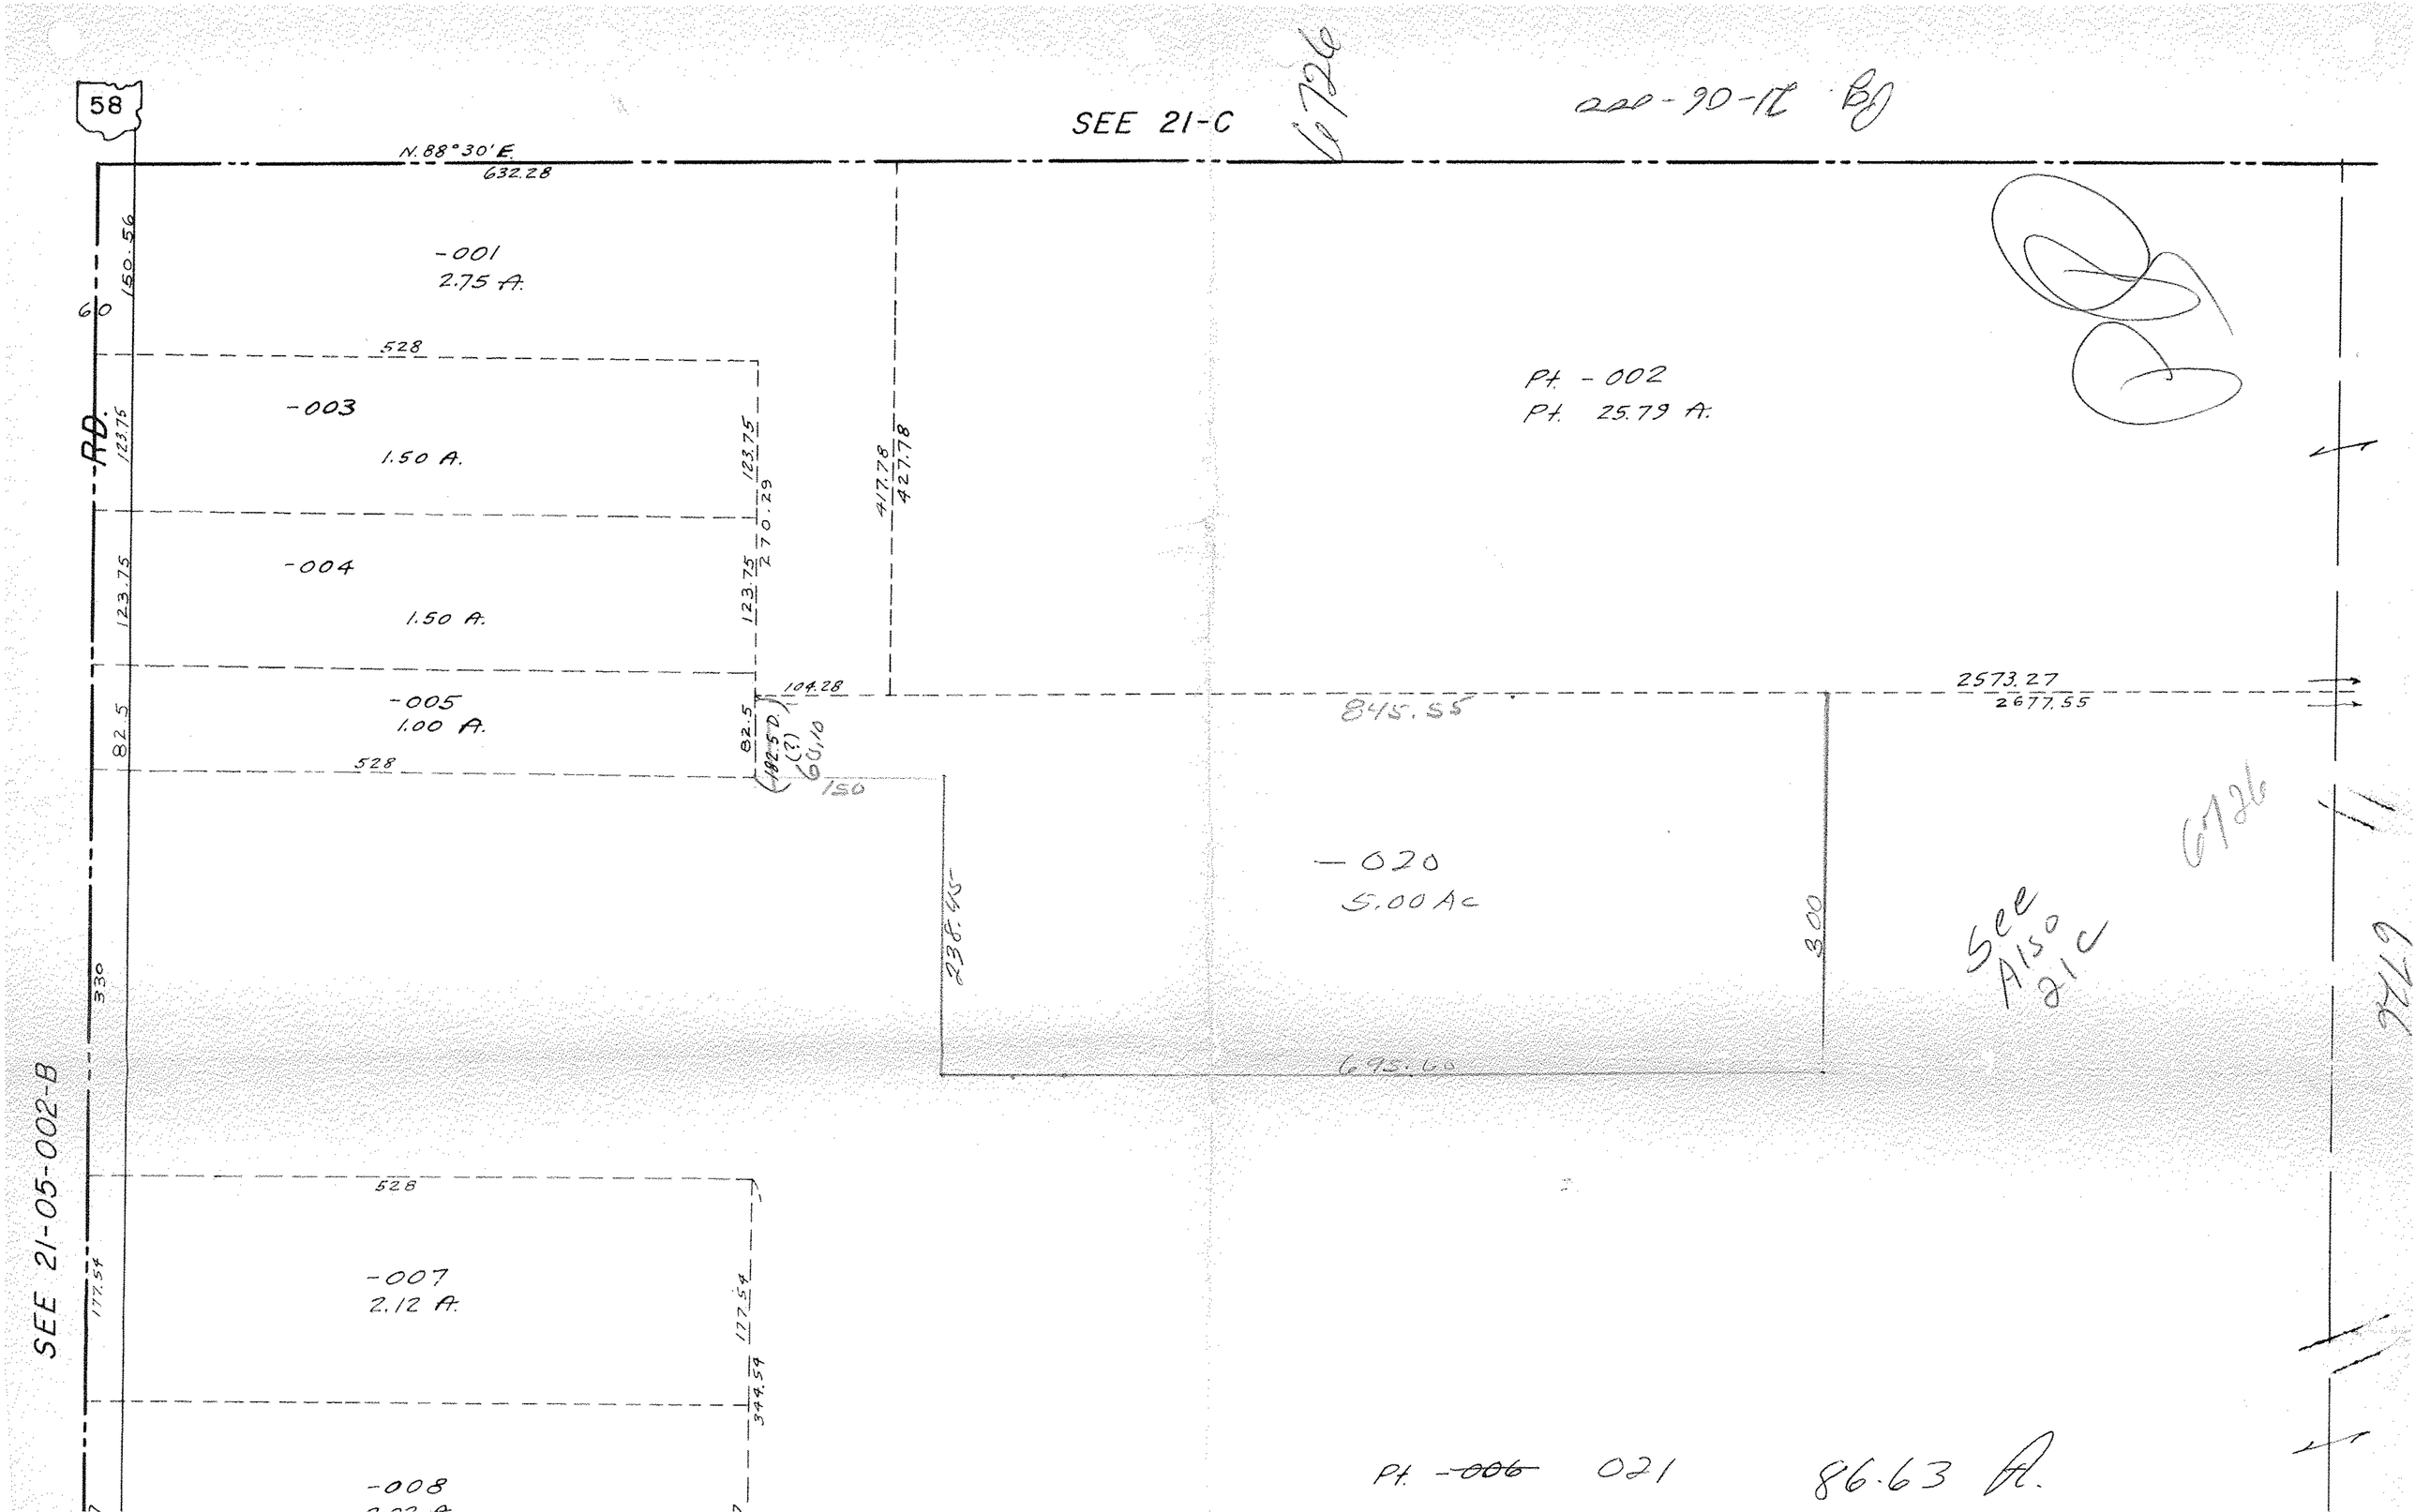
58
SEE 21-C
6726
N.88°30'E.
632.28
-001
2.75 A.
150.56
60
528
-003
1.50 A.
123.75
RD.
-004
1.50 A.
123.75
270.29
417.78
427.78
Pt. -002
Pt. 25.79 A.
-005
1.00 A.
82.5
104.28
845.55
2573.27
2677.55
150
-020
5.00 Ac
238.45
300
695.60
See Also 21C
6726
330
SEE 21-05-002-B
-007
2.12 A.
177.54
344.54
-008
Pt. ~~-006~~ 021
86.63 A.