


- 020  
3.00A.

6730

SEE

100 C.

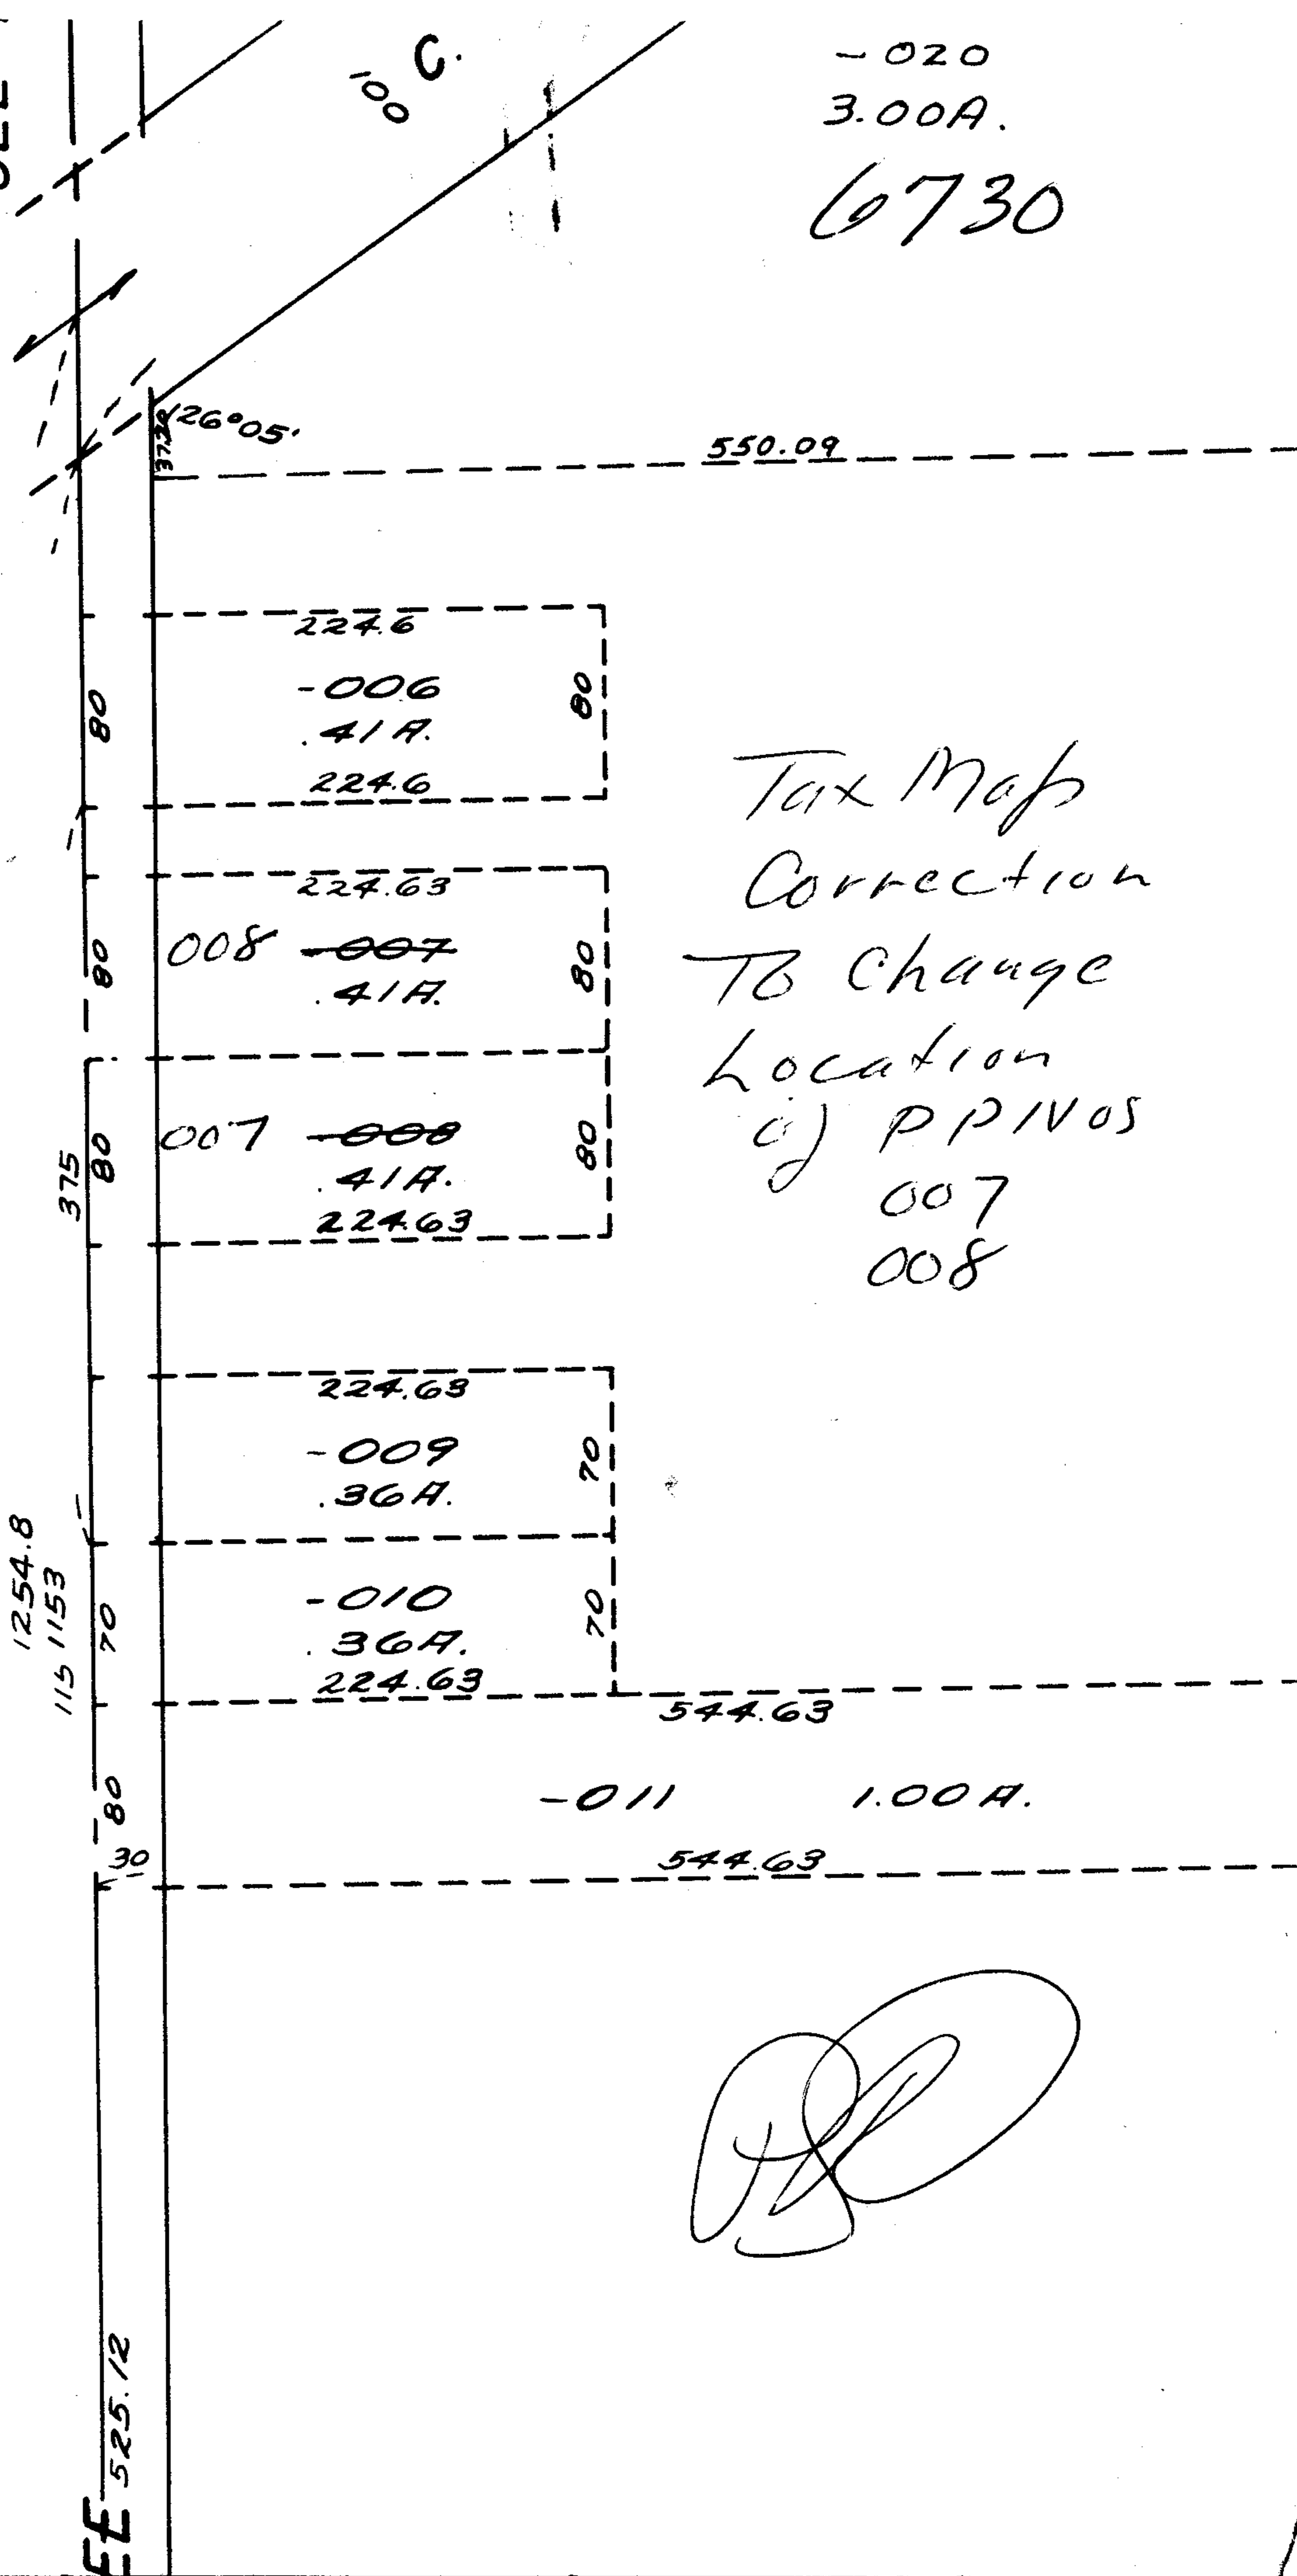

Tax Map  
Correction  
To Change  
Location  
of P P I V O S  
007  
008

6730  
**APPROVED**  
**LORAIN CO.**  
**MAP DEPT.**  
 DATE 2-15-73  
 11-00-080A  
 BY L W Hill