


6731

6/2

6731
 APPROVED
 LORAIN CO.
 MAP DEPT.
 DATE 2-15-73
 3-00-0414
 BY L W Hill

C-M-OK

3-00-0414

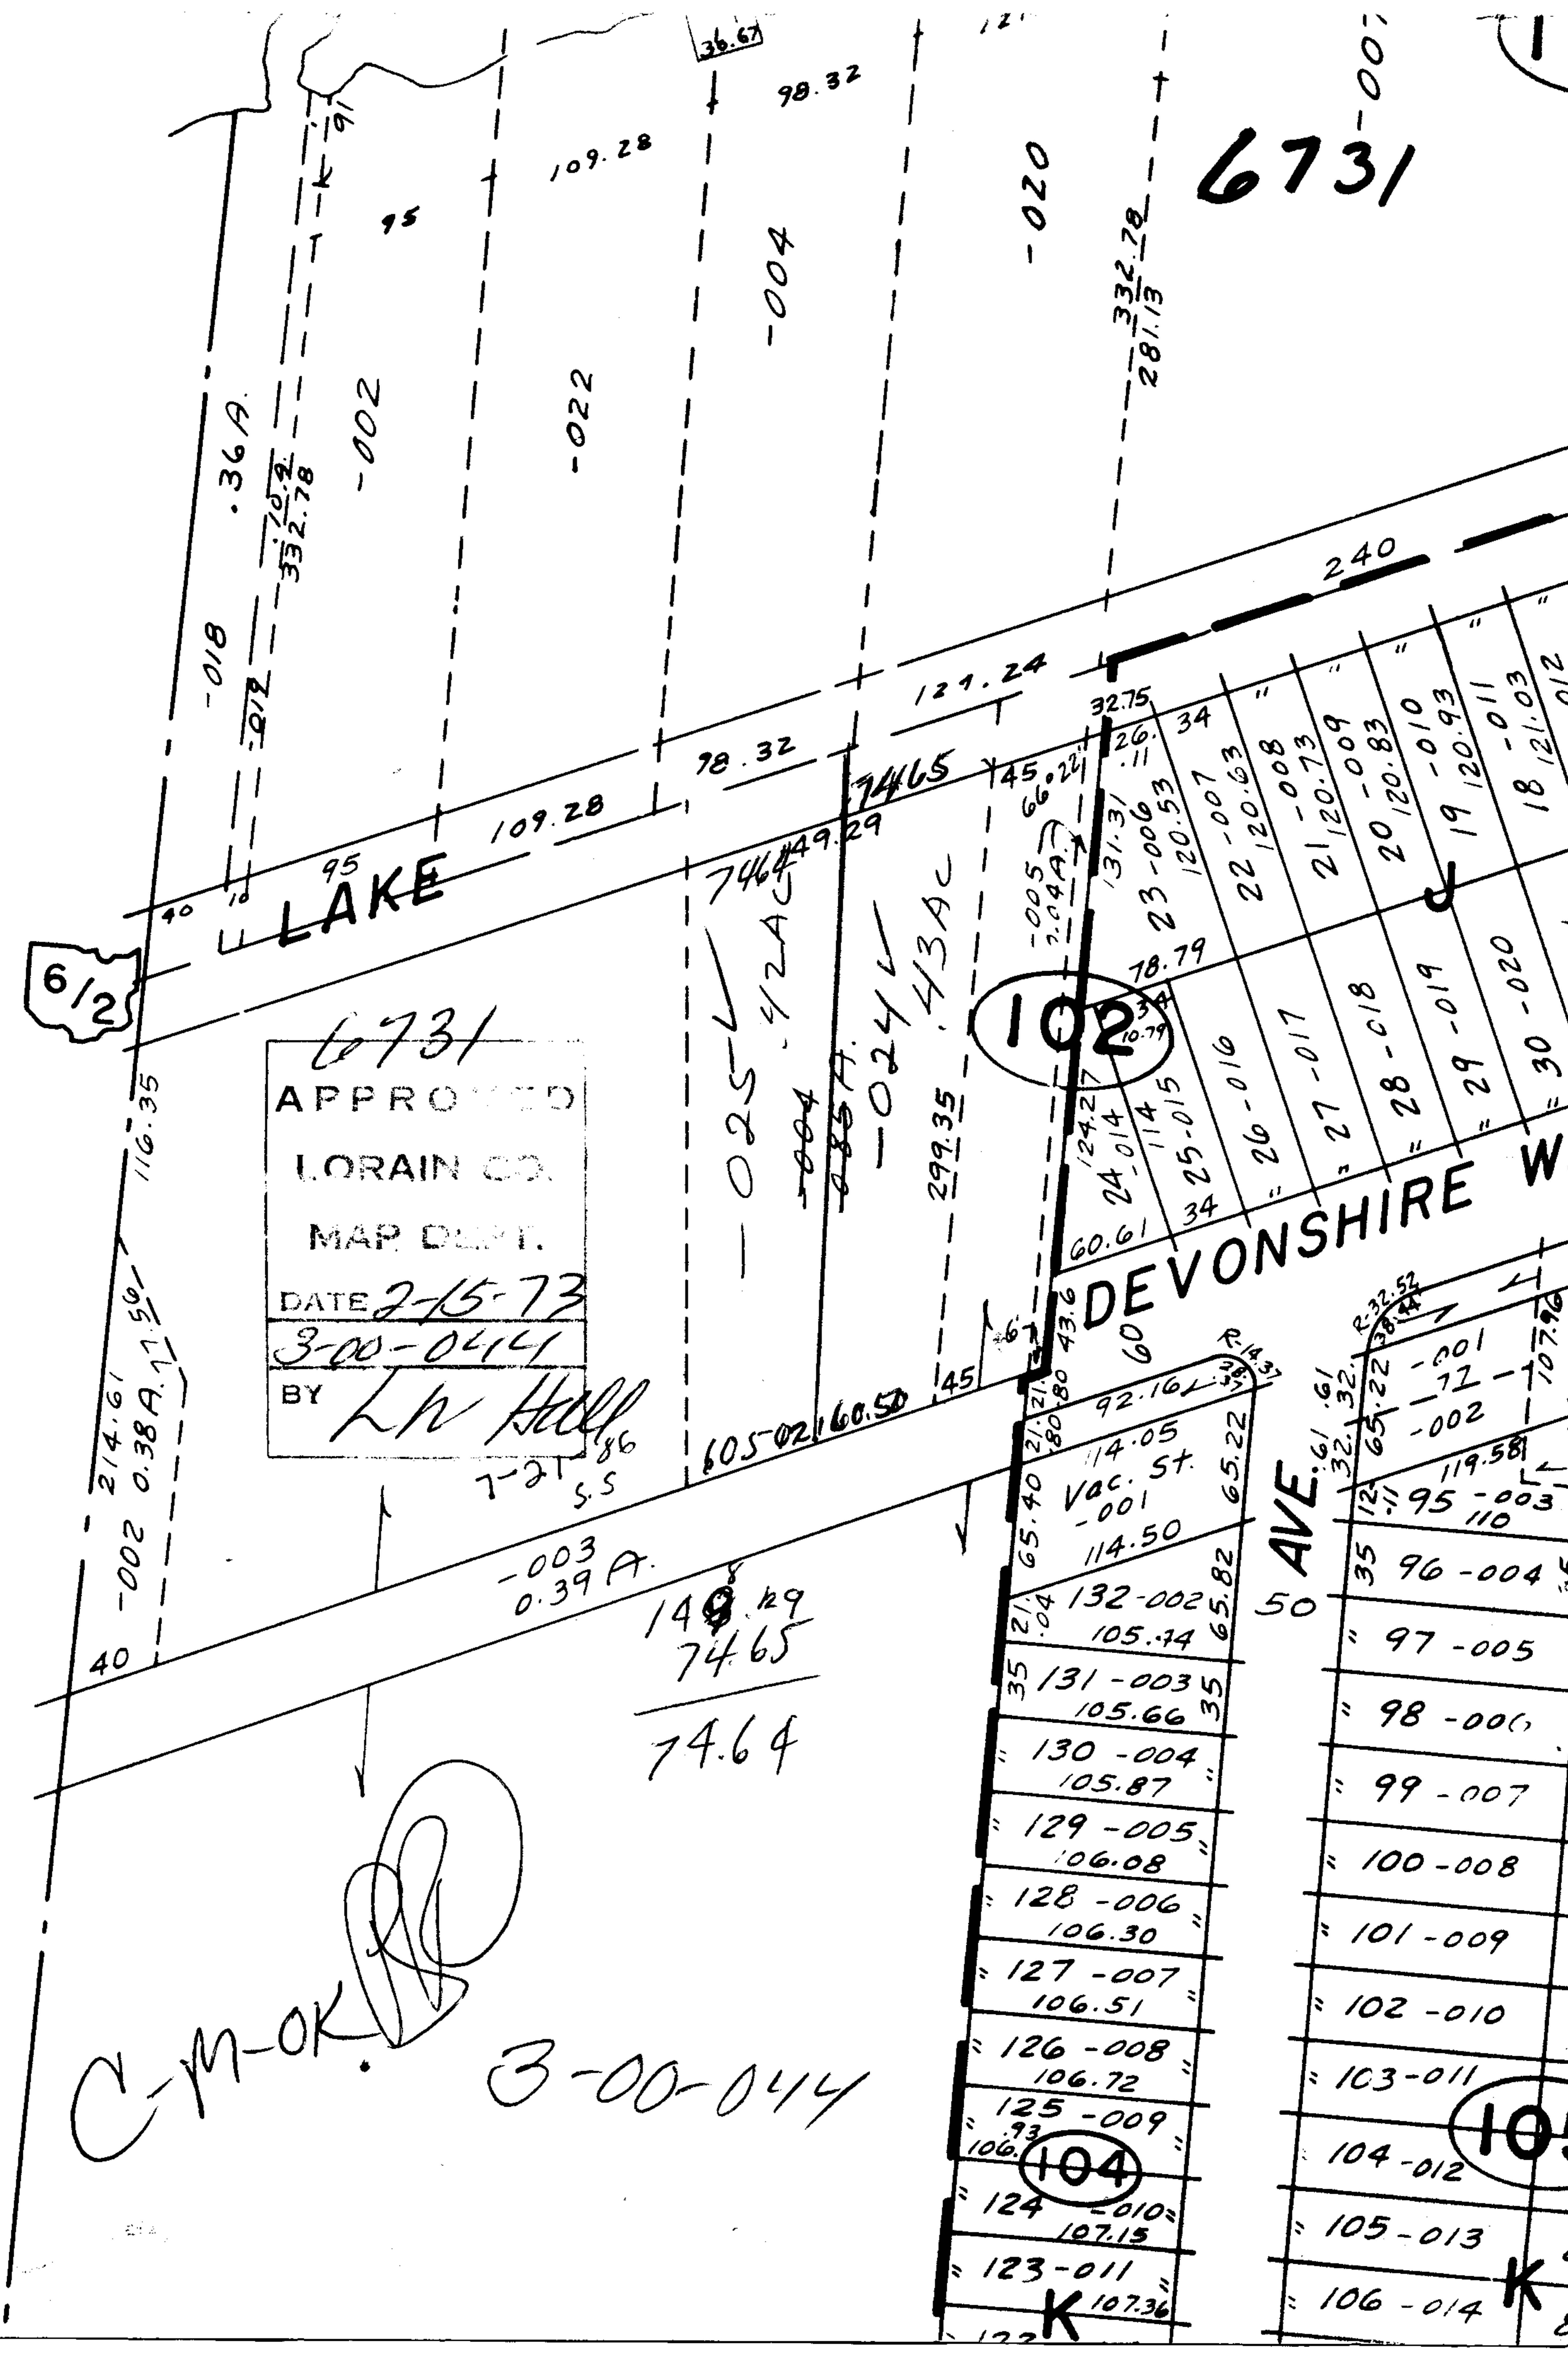

102

104

105

K