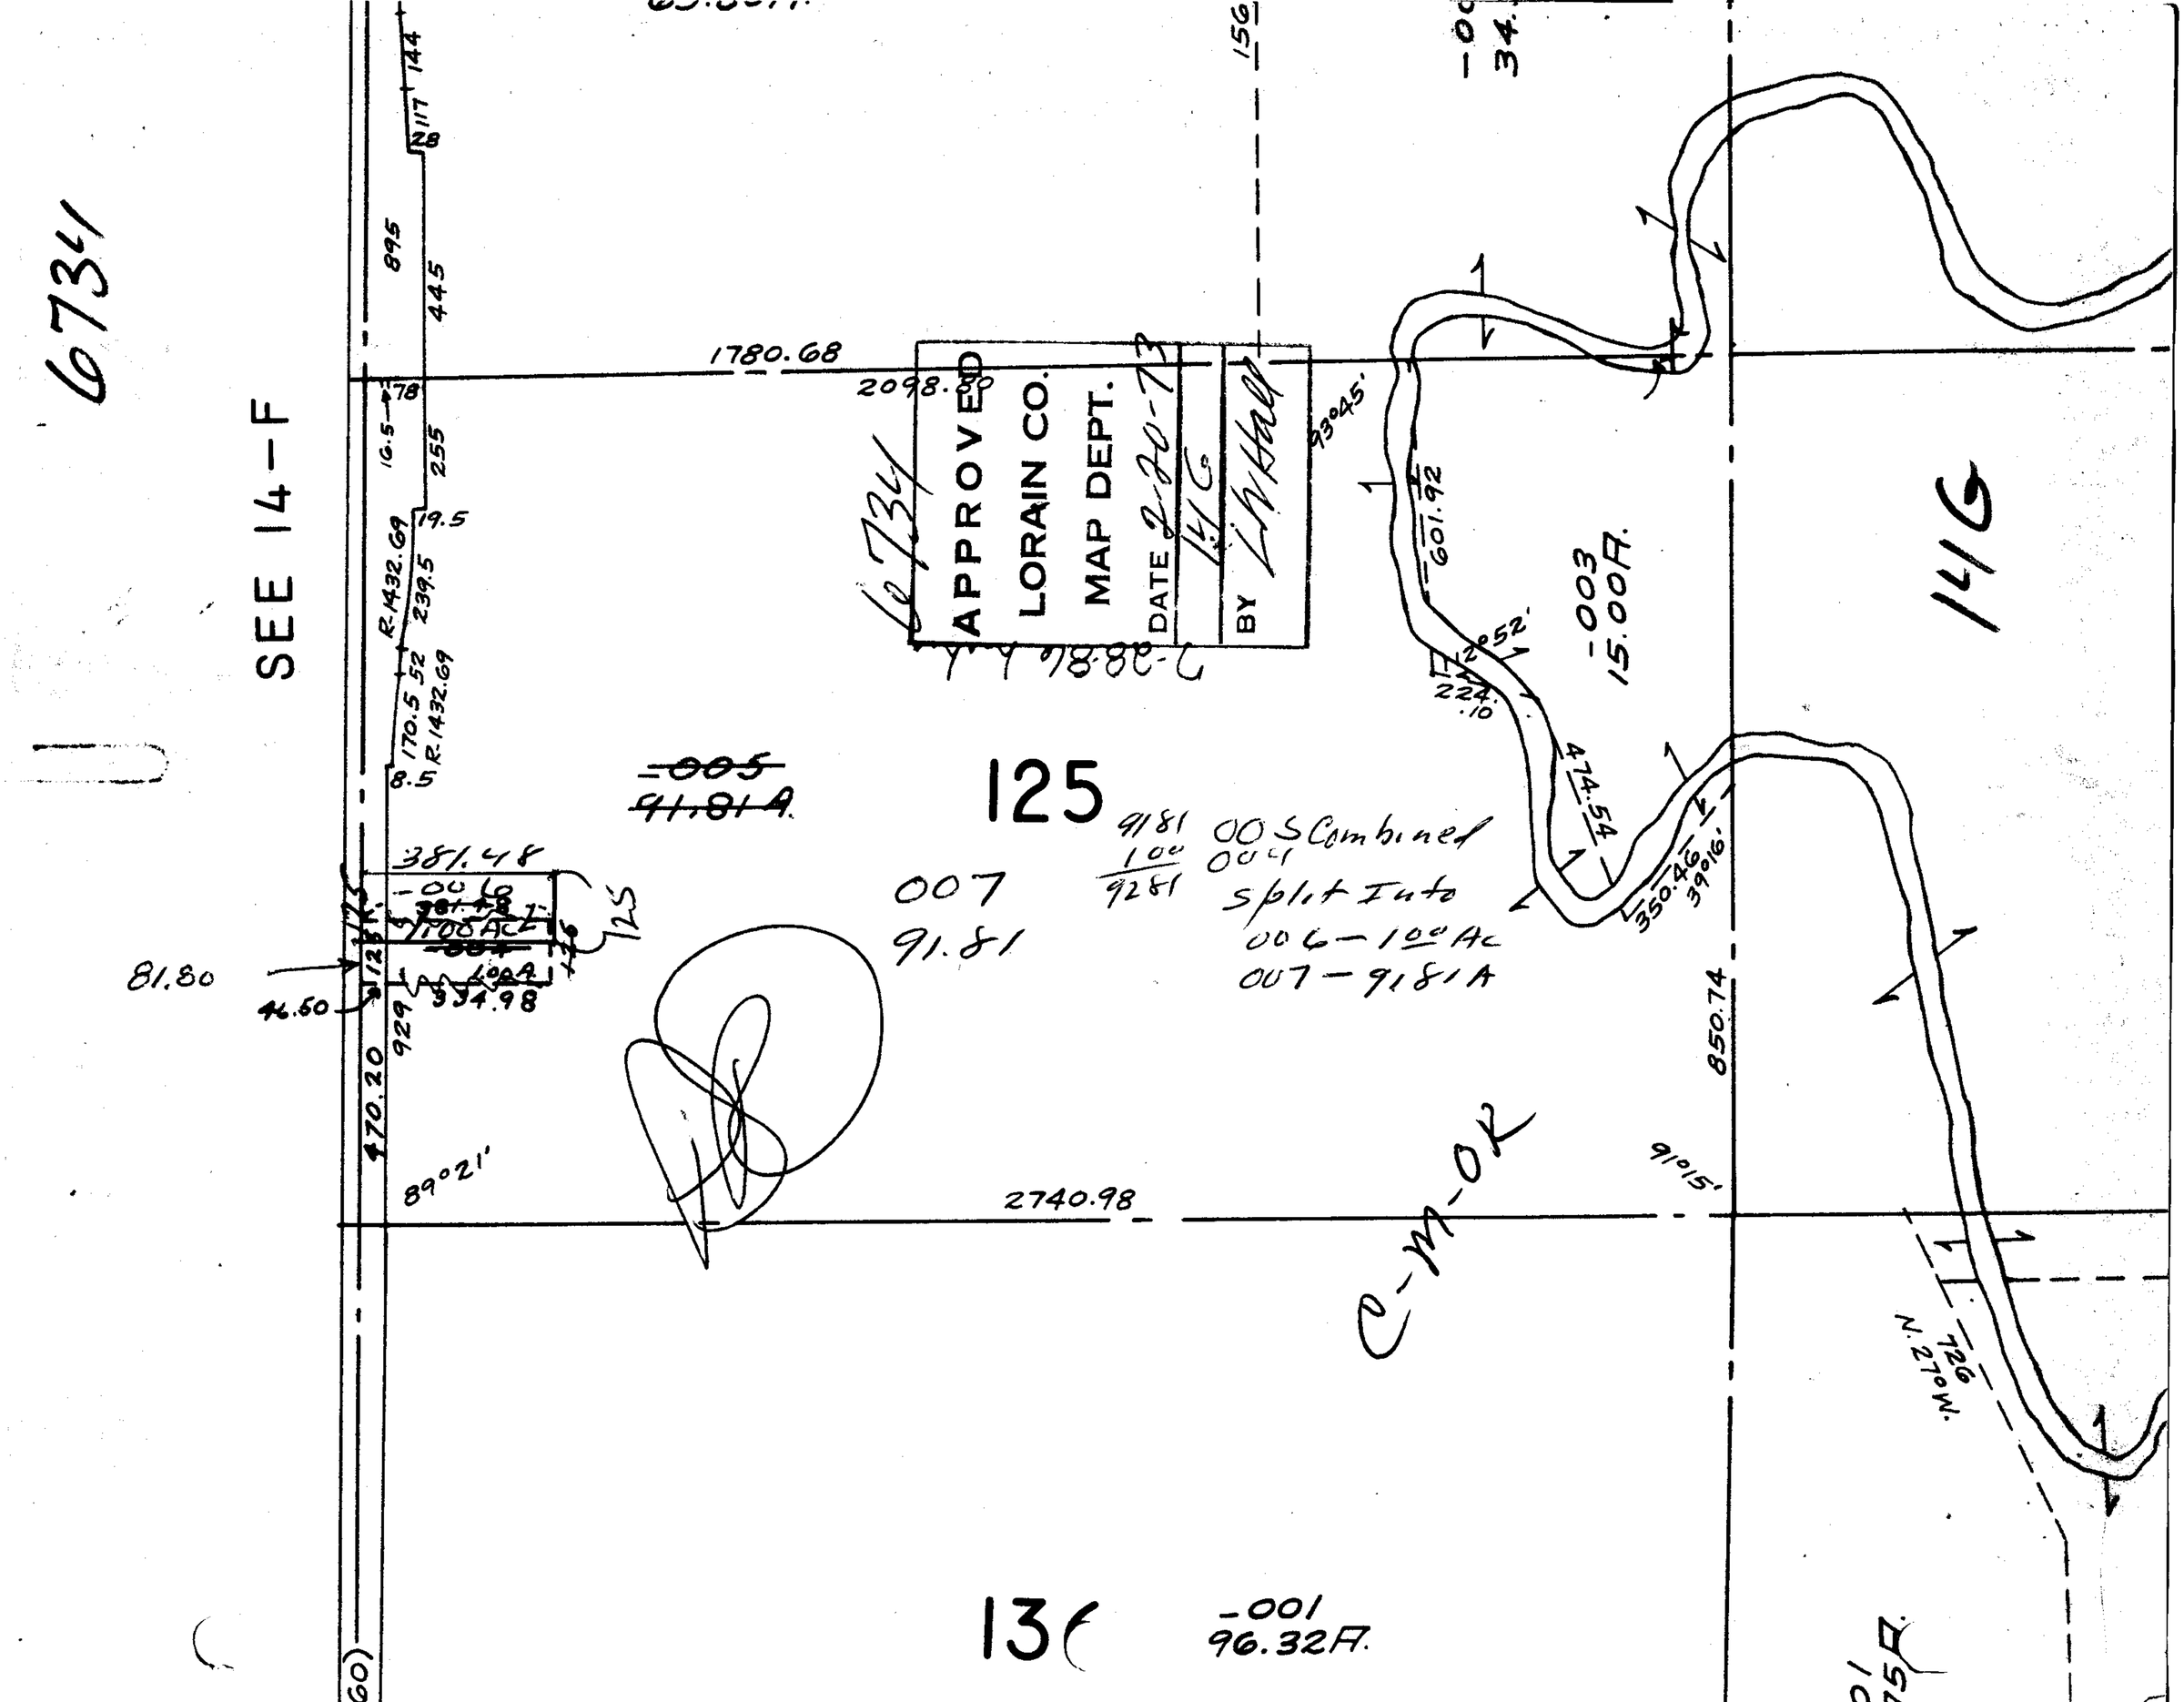
6734
SEE 14-F
APPROVED
LORAIN CO.
MAP DEPT.
DATE 2-20-73
BY
1780.68
2098.80
93°45'
601.92
-003
15.00A.
14G
125
-005
91.81A
007
91.81
9181 00S Combined
100 004
9281 split Into
006-100 Ac
007-9181A
381.48
-006
81.80
46.50
334.98
470.20
89°21'
2740.98
850.74
91°15'
C-M-OR
726
N.270W.
13(
-001
96.32A.