


GARFIELD

ST. L.

6738


HIGHWAY

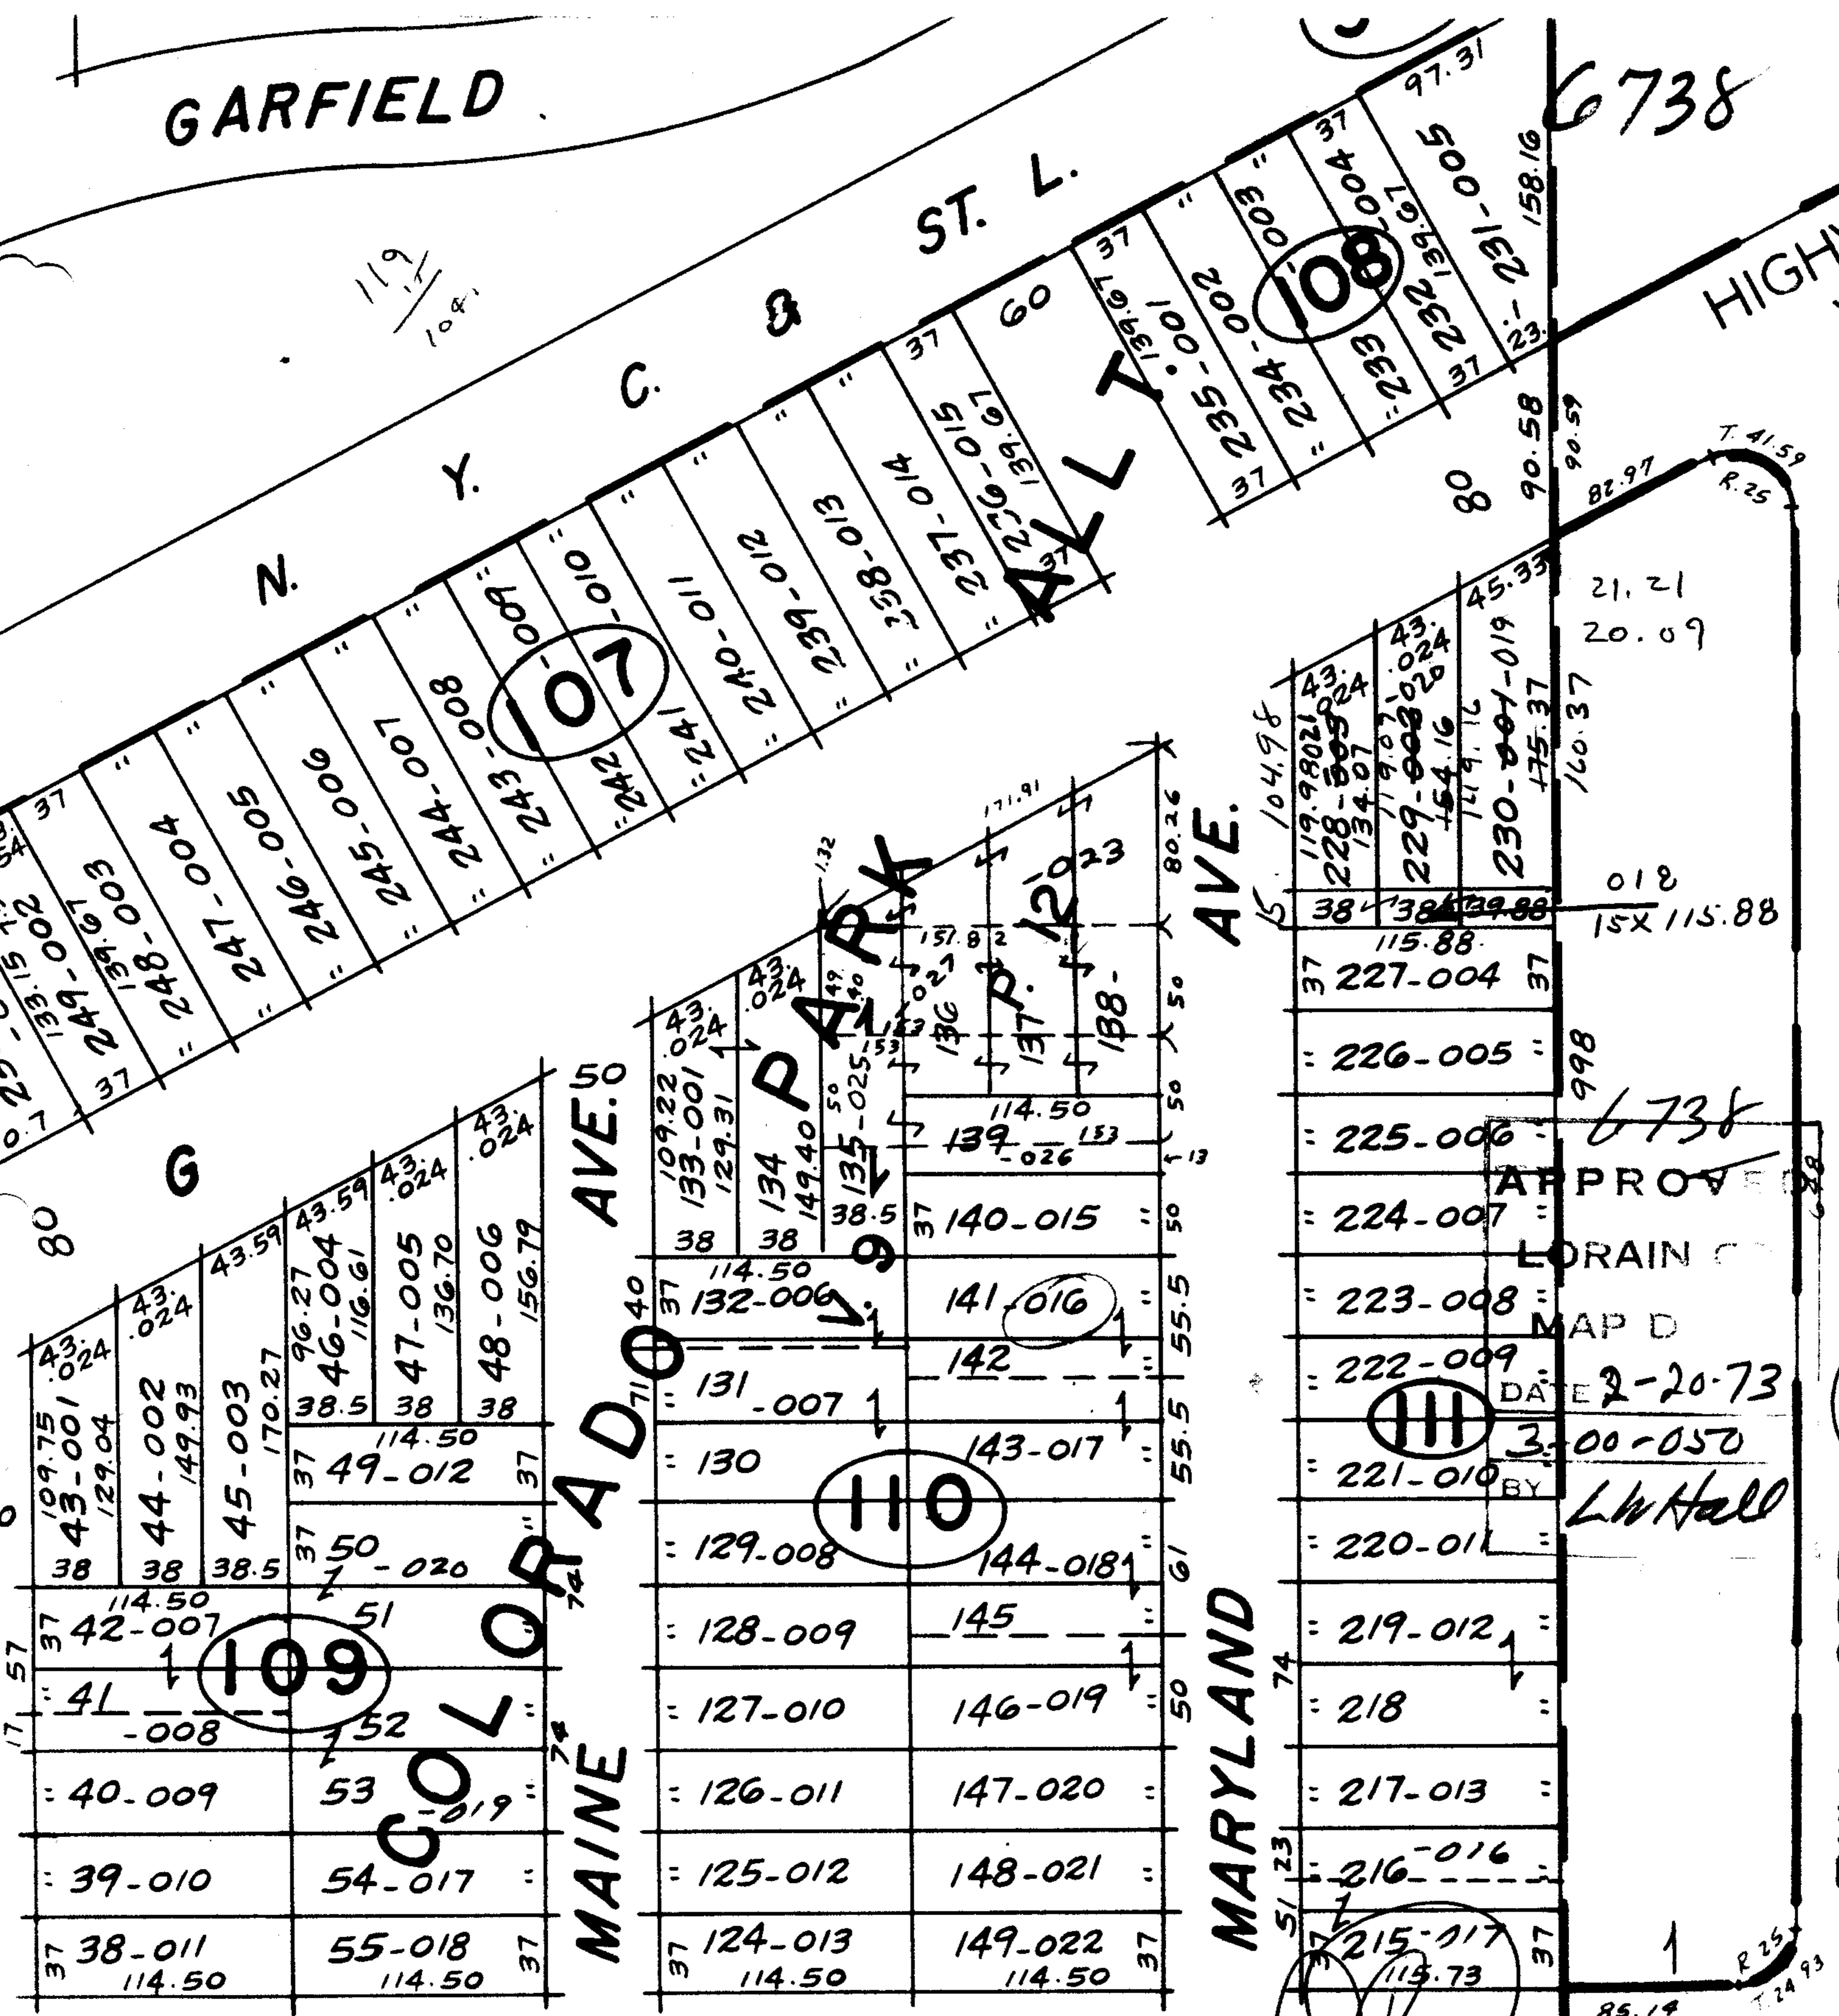

107

108

109

110

III

6738

APPROVED

LORAIN C

MAP D

DATE 2-20-73

BY 3-00-050

L. W. Hall

C.M.-O.K.

[Large scribble]

SHEFFIELD TWP.

SEE 3-00-053-A

SCALE: 1" = 100'

3-00-050