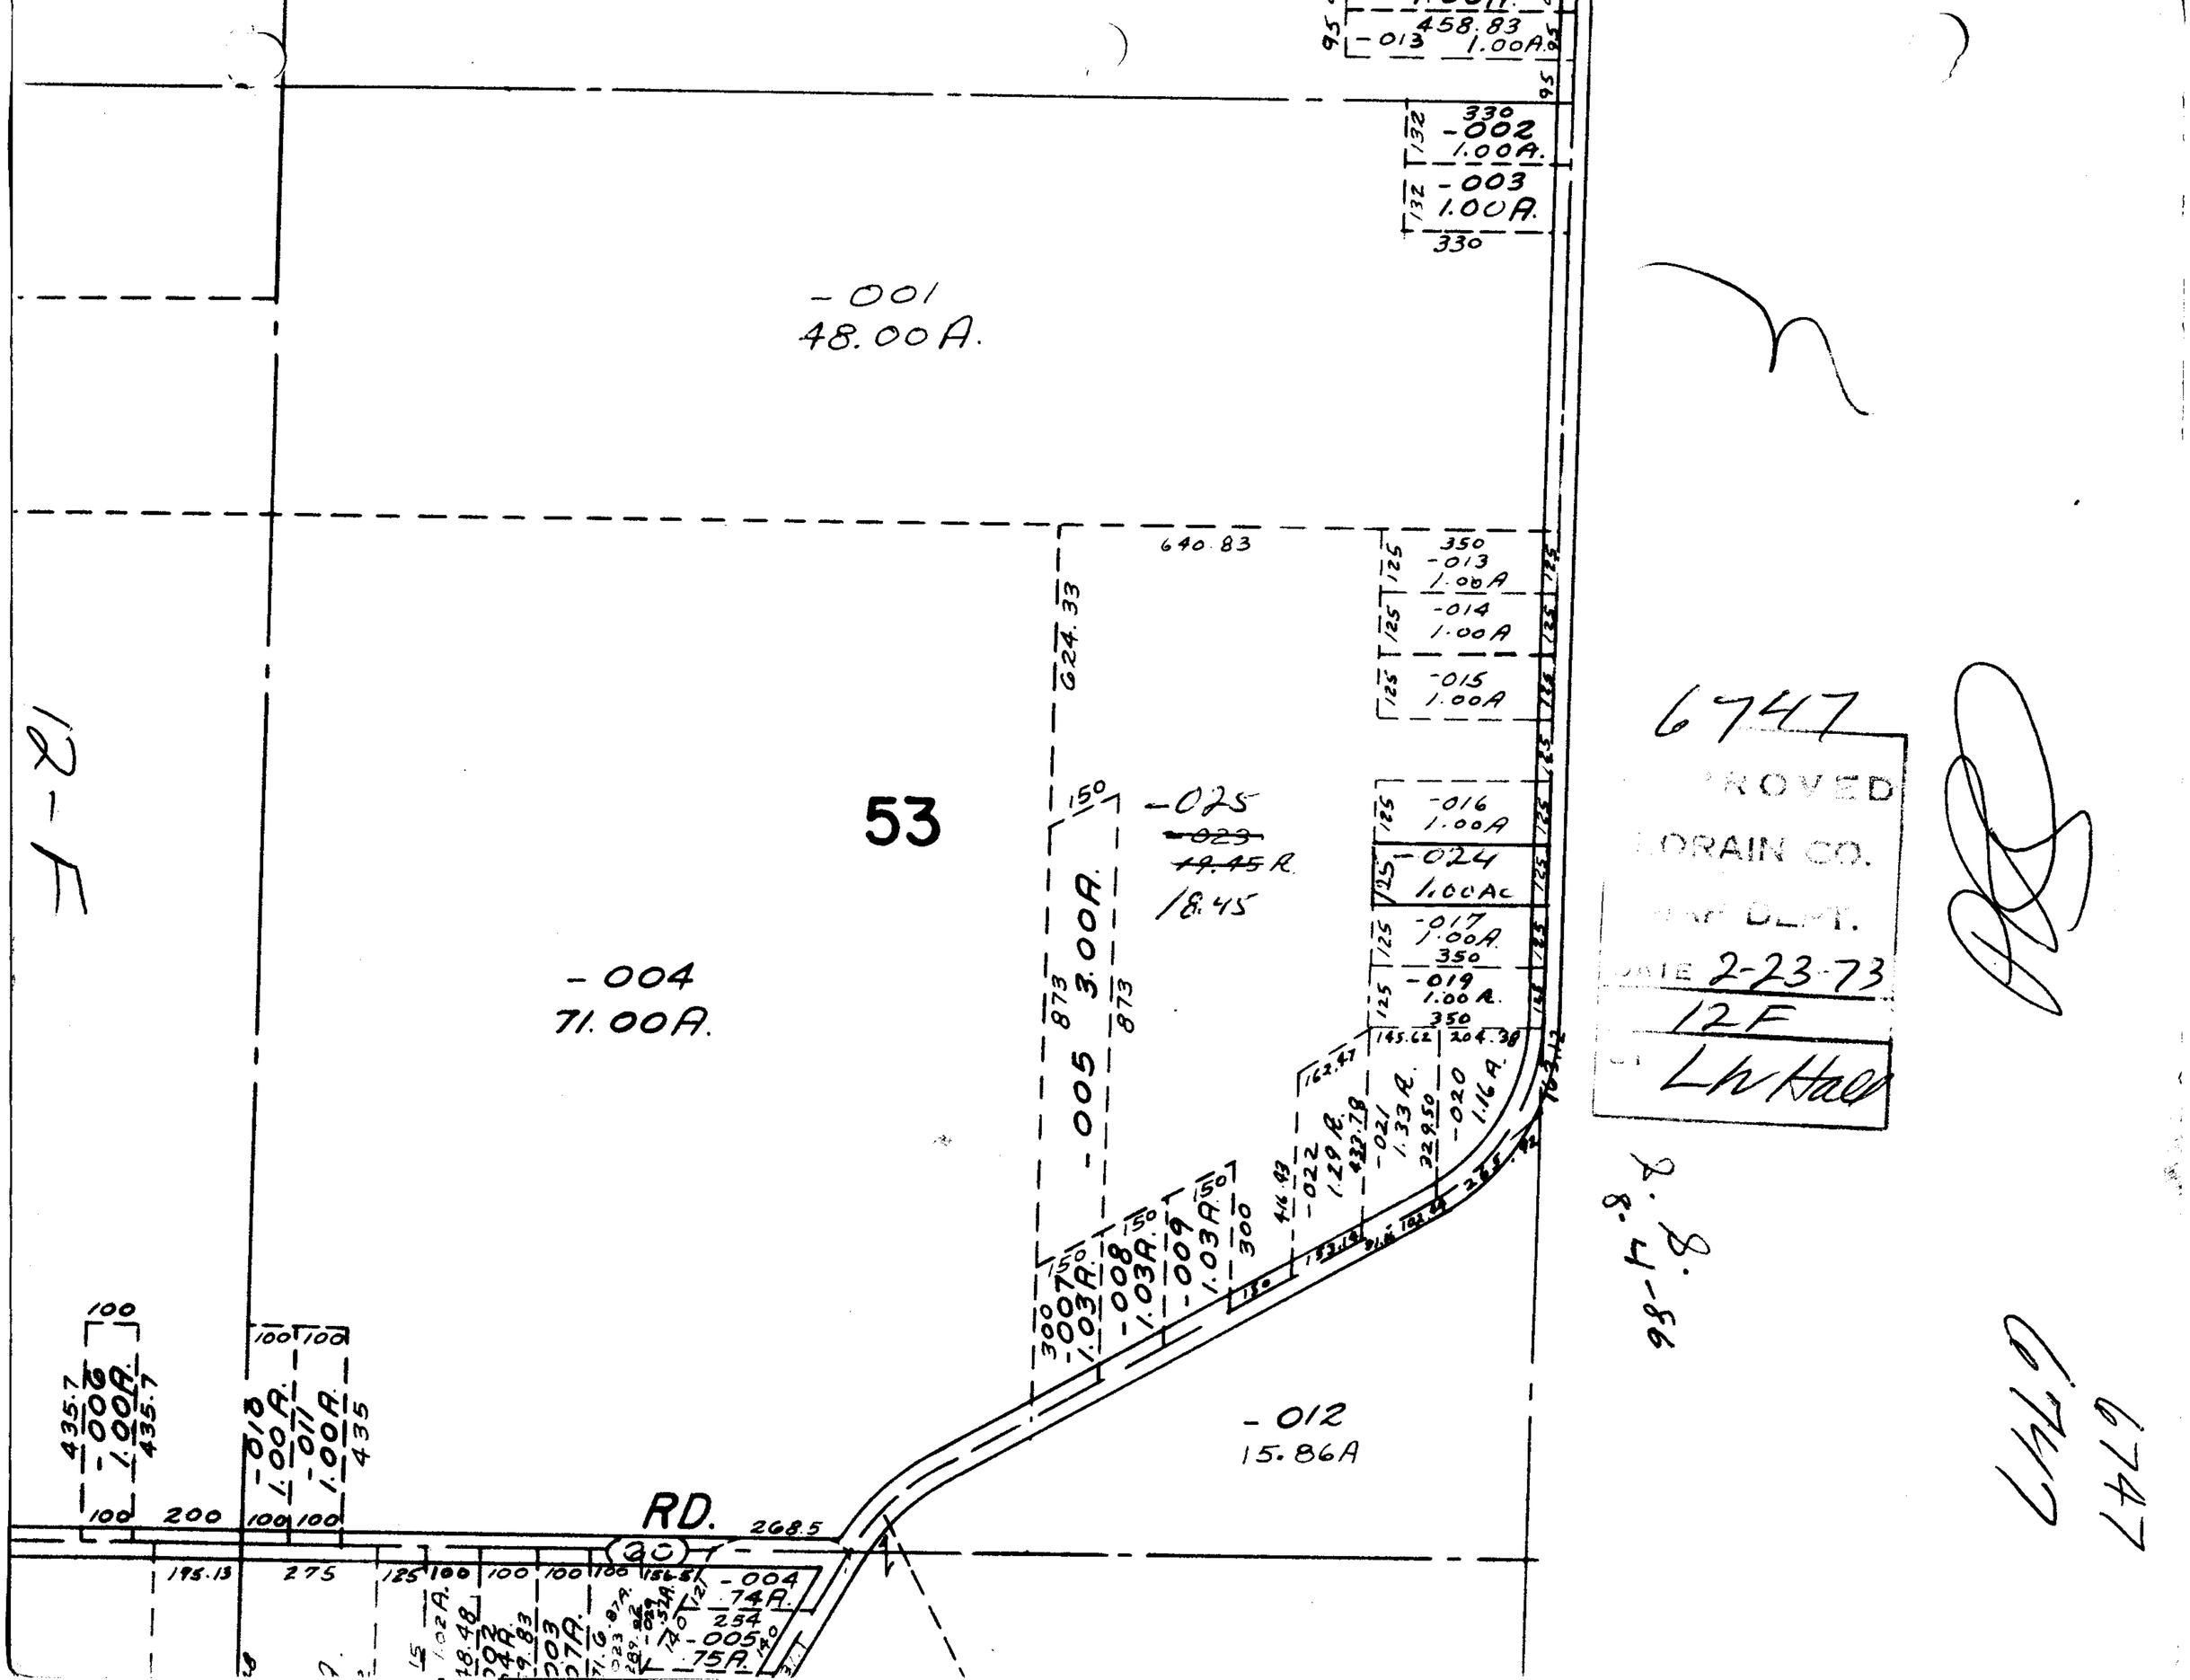

-001
48.00A.
-004
71.00A.
-005
3.00A.
-025
18.45
-012
15.86A
RD.
53
12-F
6747
PROVED
LORAIN CO.
DATE 2-23-73
12F
Lh Hall
6747
6747