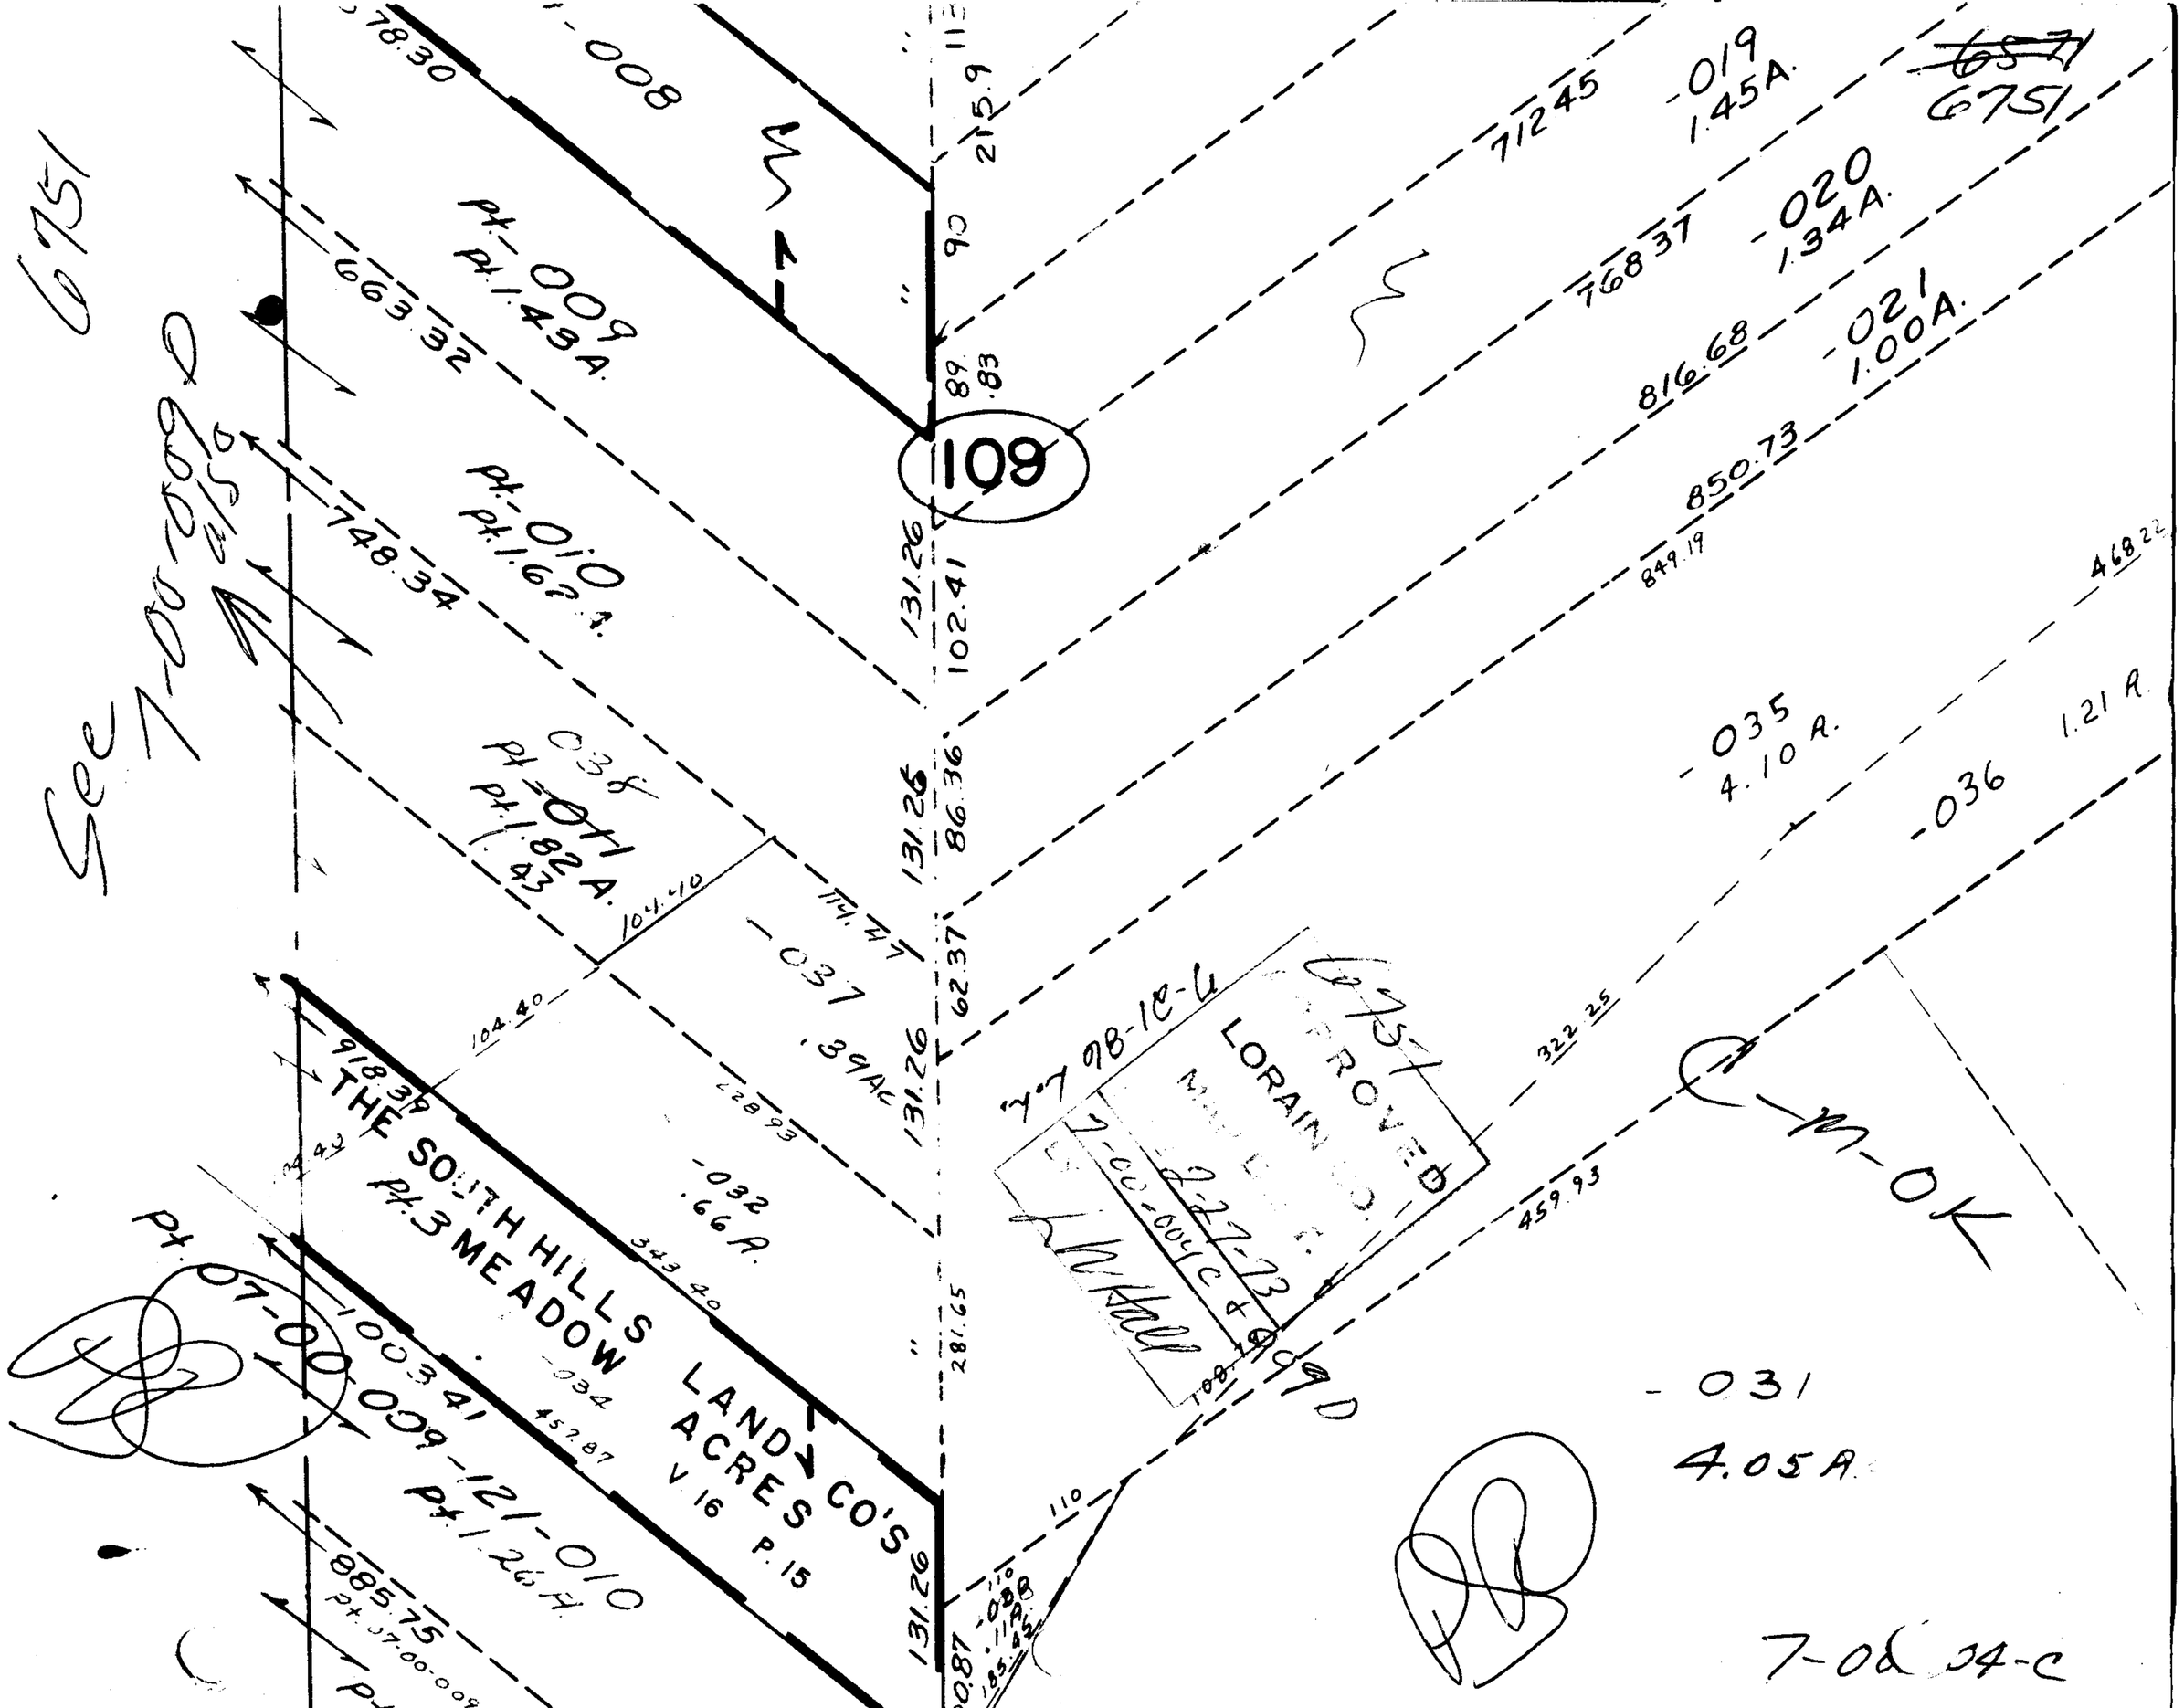

6751
See 7-00-009 also
-008
78.30
pt.-009
pt.1.43A.
663.32
pt.-010
pt.1.62A.
748.34
038
pt.-011
pt.1.82A.
.43
104.40
-037
.39Ac
228.93
-032
.66A.
343.40
-034
457.87
THE SOUTH HILLS LAND CO'S
ACRES
V.16 P.15
918.39
pt.3 MEADOW
pt.07-00-009-121-010
pt.1.26A.
885.75
pt.07-00-009
109
131.26
102.41
86.36
62.37
281.65
215.9
90
89
.83
712.45
-019
1.45A.
768.37
-020
1.34A.
816.68
-021
1.00A.
850.73
849.19
468.22
-035
4.10A.
-036
1.21A.
322.25
459.93
-031
4.05A.
LORAIN CO.
APPROVED
7-00-004C & 009D
2-27-73
C-M-OK
7-08-04-C