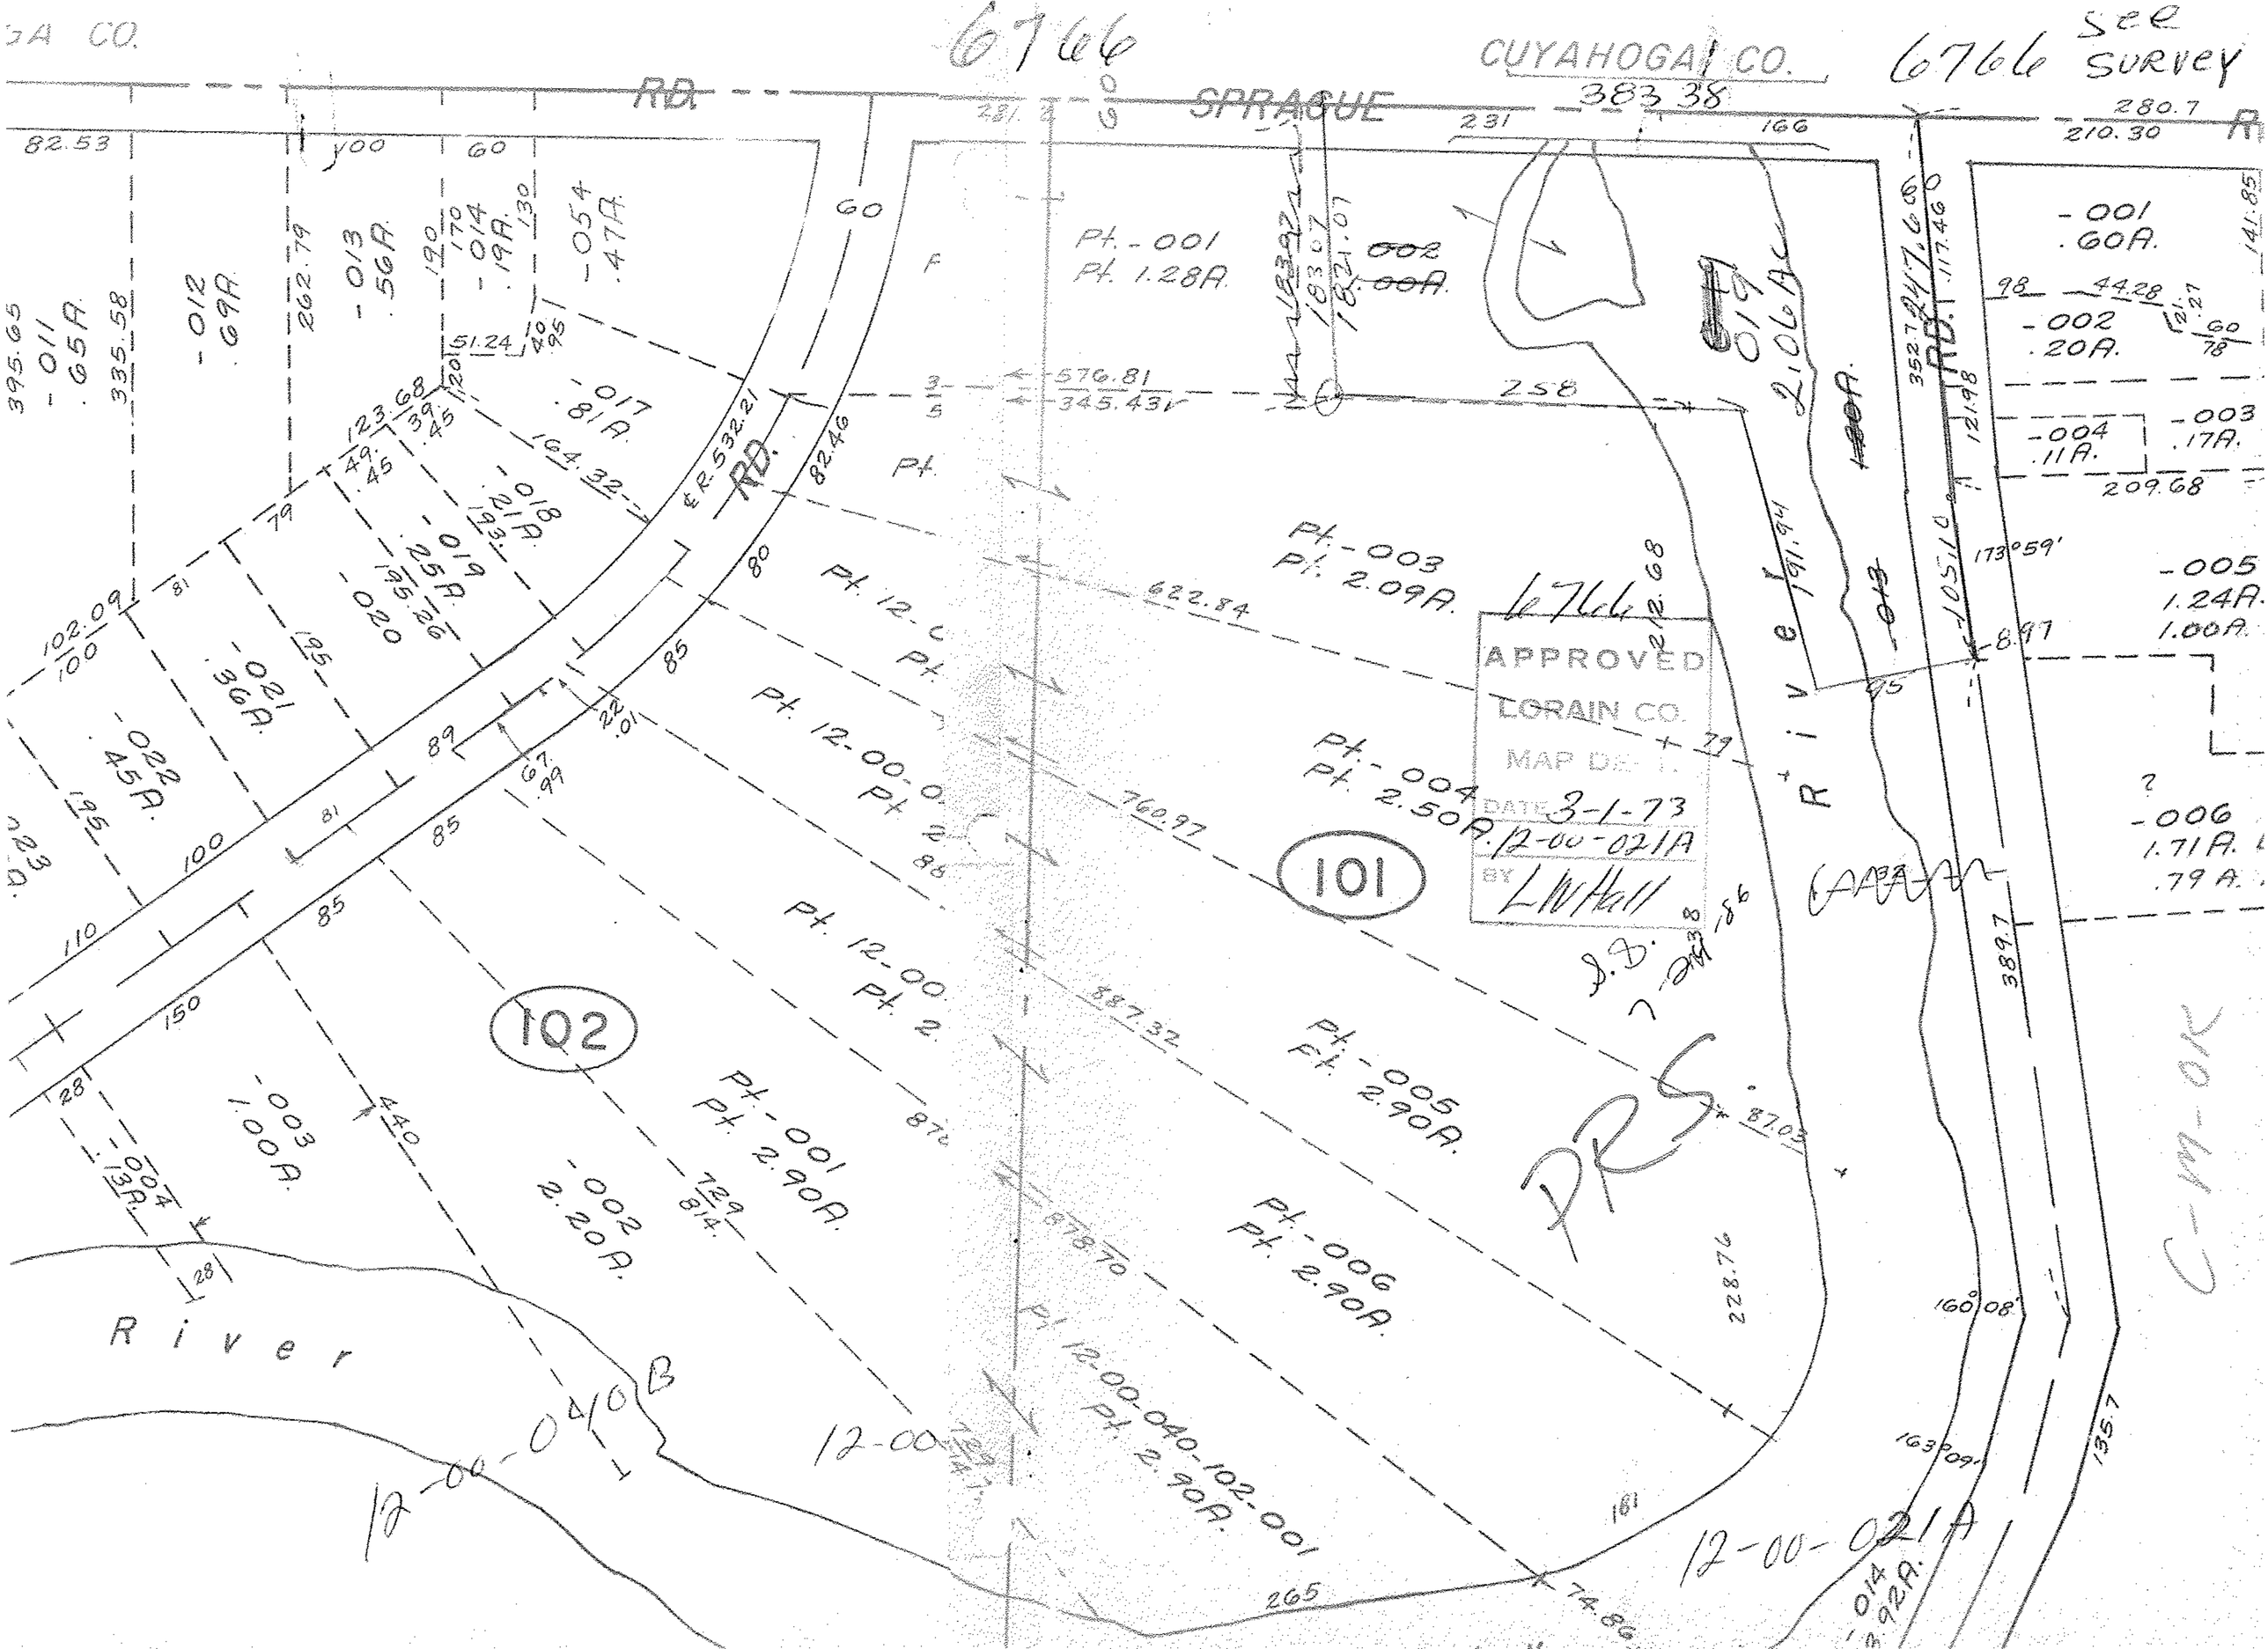

6766
CUYAHOGA CO.
383 38
6766 See SURVEY
SPRAGUE
RD.
Pt. -001
Pt. 1.28A.
Pt. -003
Pt. 2.09A.
Pt. -004
Pt. 2.50A.
Pt. -005
Pt. 2.90A.
Pt. -006
Pt. 2.90A.
Pt. 12-00-040-102-001
Pt. 2.90A.
Pt. 12-00-040B
12-00-021A
101
102
River
APPROVED
LORAIN CO.
MAP DEPT.
DATE 3-1-73
12-00-021A
BY LWHall
PRS
C-M-OK