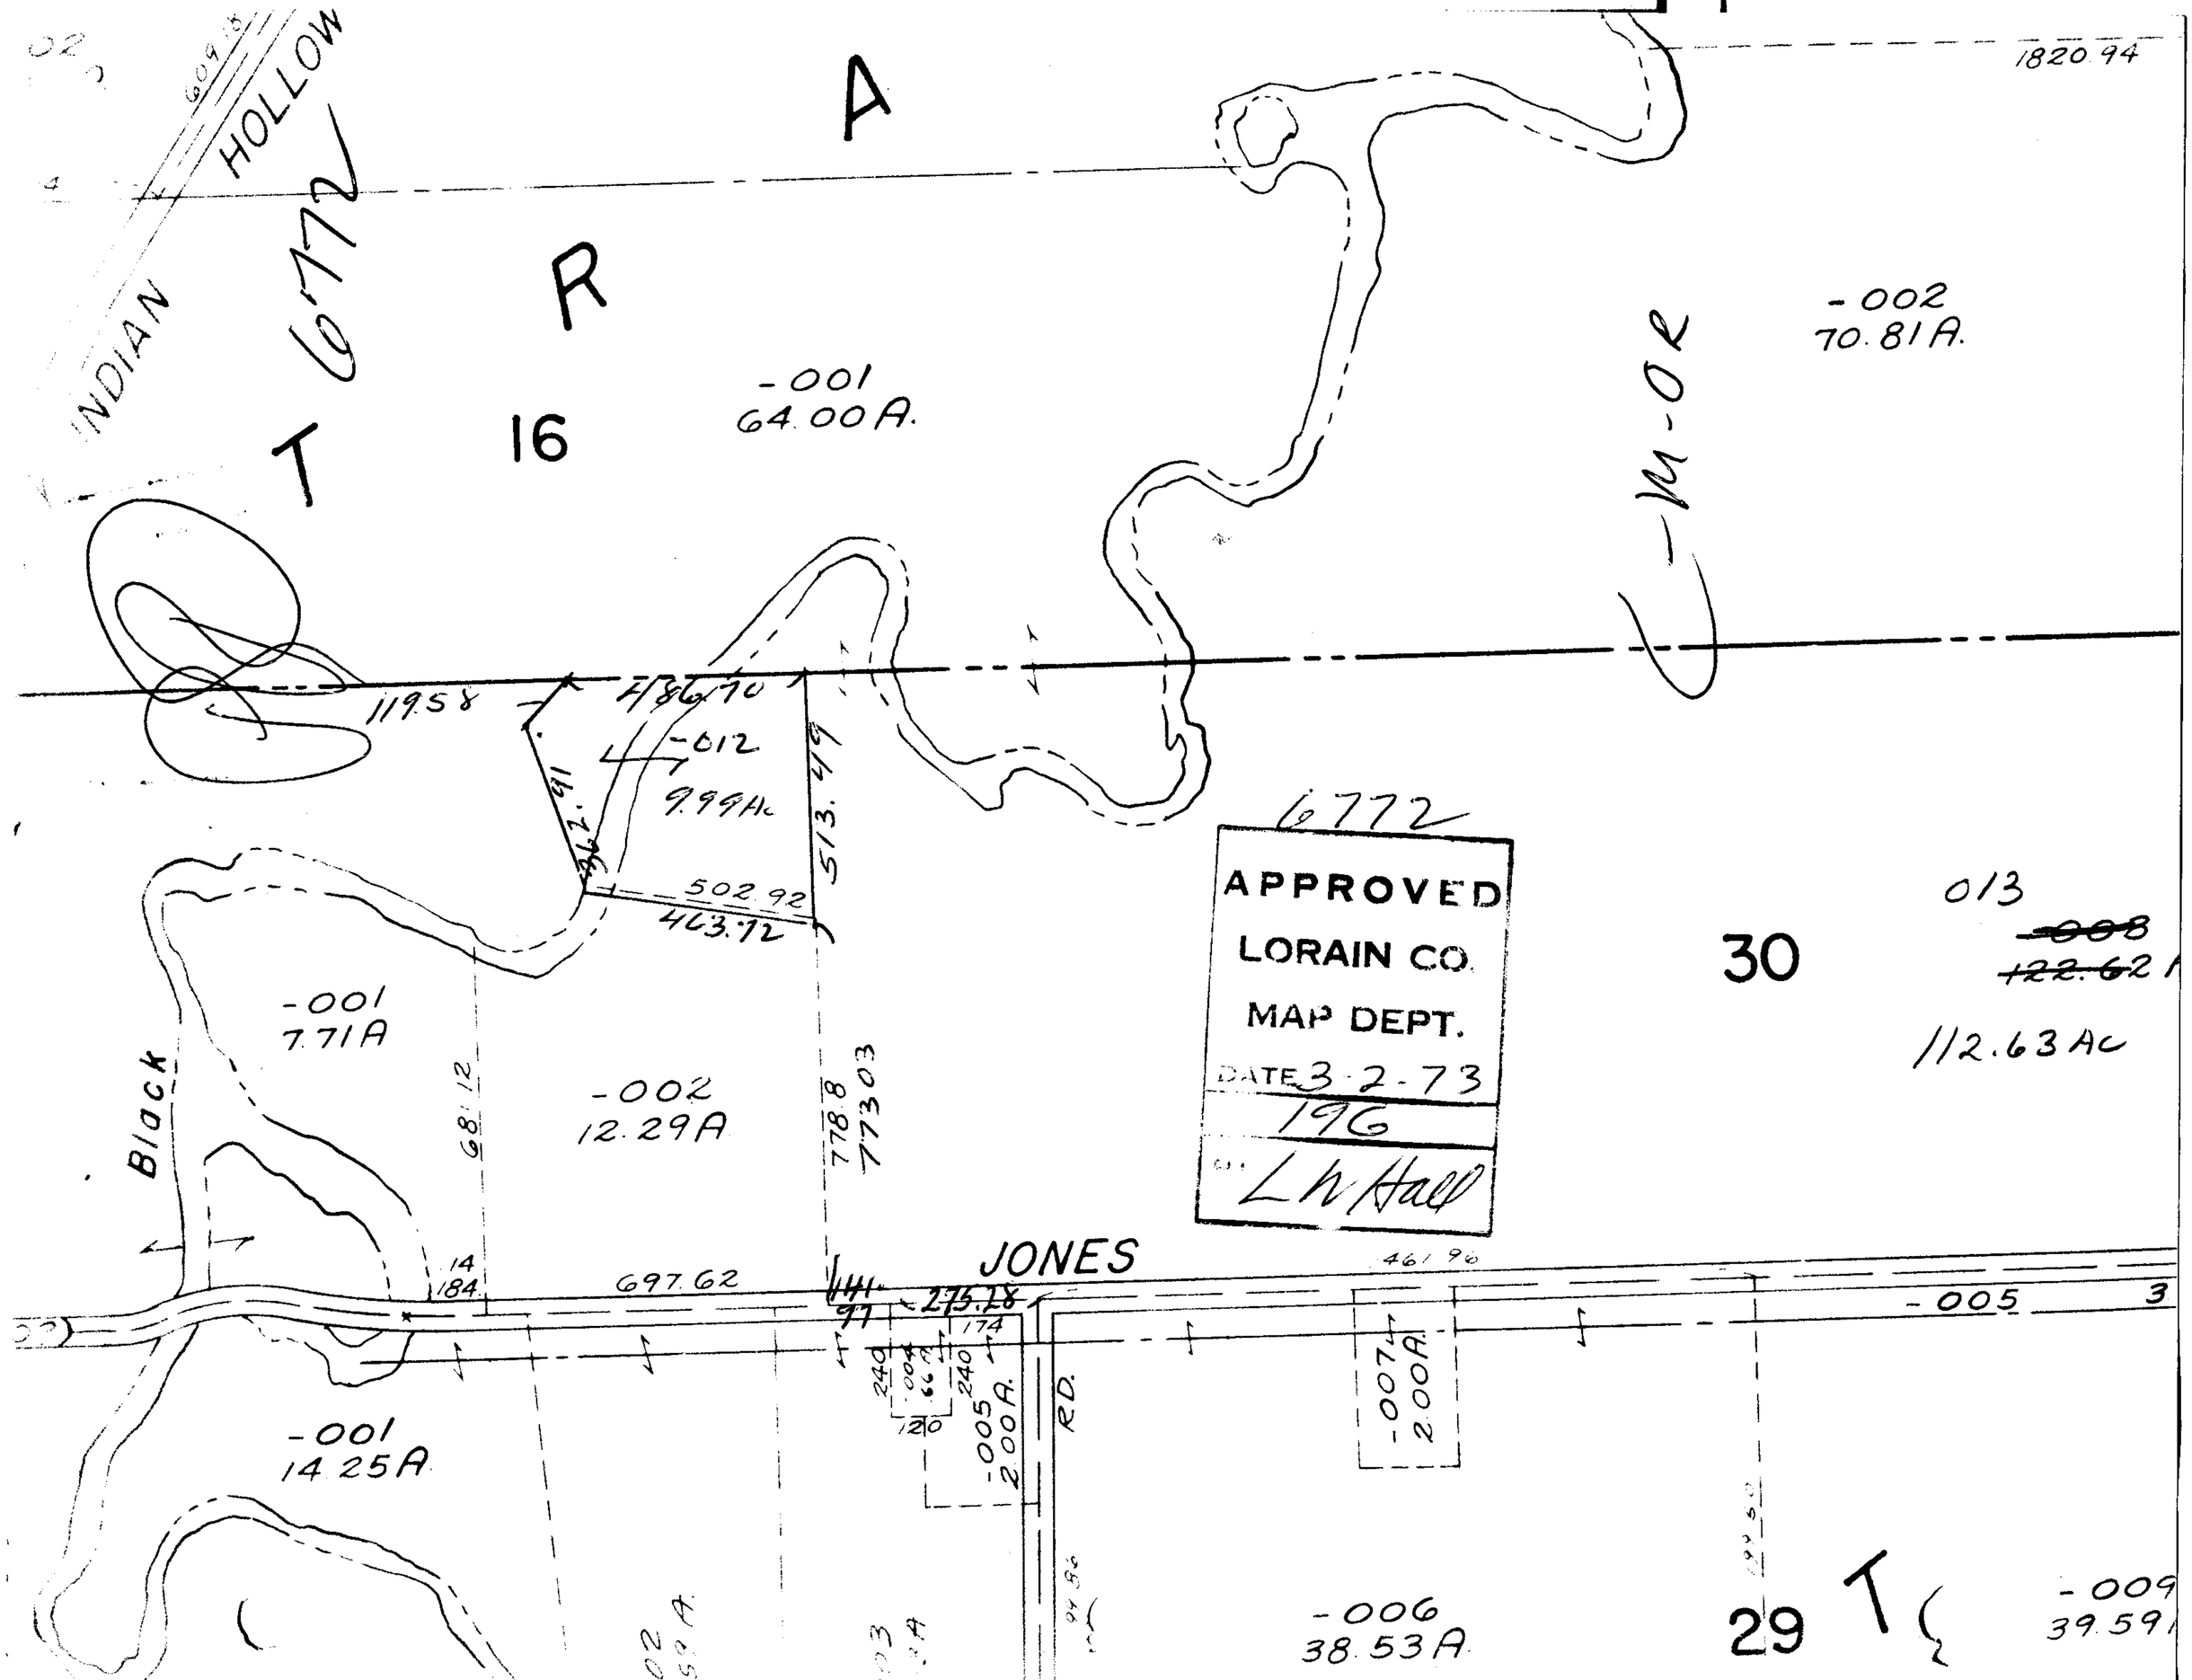

INDIAN HOLLOW
6772
T R A
16
-001
64.00A.
-002
70.81A.
-M-OR
1820.94
119.58
486.70
-012
9.99Ac
513.49
502.92
463.72
6772
APPROVED
LORAIN CO.
MAP DEPT.
DATE 3-2-73
196
L W Hall
30
013
~~-008~~
~~122.62~~
112.63 Ac
-001
7.71A
-002
12.29A
Black
681.12
778.8
773.03
JONES
14
184
697.62
141.97
275.28
174
461.96
-005
3
240
120
-005
2.00A.
RD.
-007
2.00A.
-001
14.25A
-006
38.53A
29
-009
39.59